



FED. ROAD DIST. NO.	STATE	FED. AID PROJ. NO.	FISCAL YEAR	SHEET NO.	TOTAL SHEETS
9	VT	91.0	1956	8	31

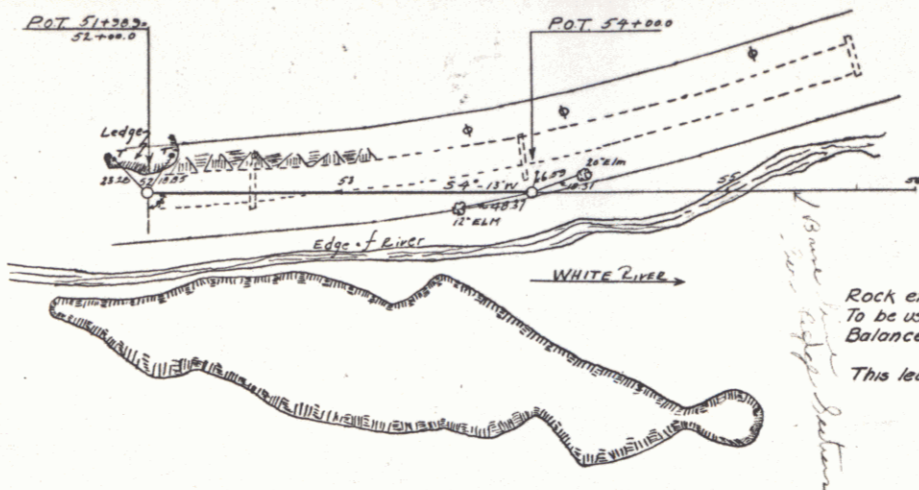

Rock excavation in River on Rt of Sta 51+75-55+25 - 1695 Cu Yd  
 To be used in making side fill Sta 33+50-36+50 - 598 ..  
 Balance to be used between Sta 36+50-48+00  
 This ledge to be cut to the Grades shown on Cross Section Sheets 30 & 31

1695  
 598  
 1097

Project  
 8606A  
 Highway  
 Tinned

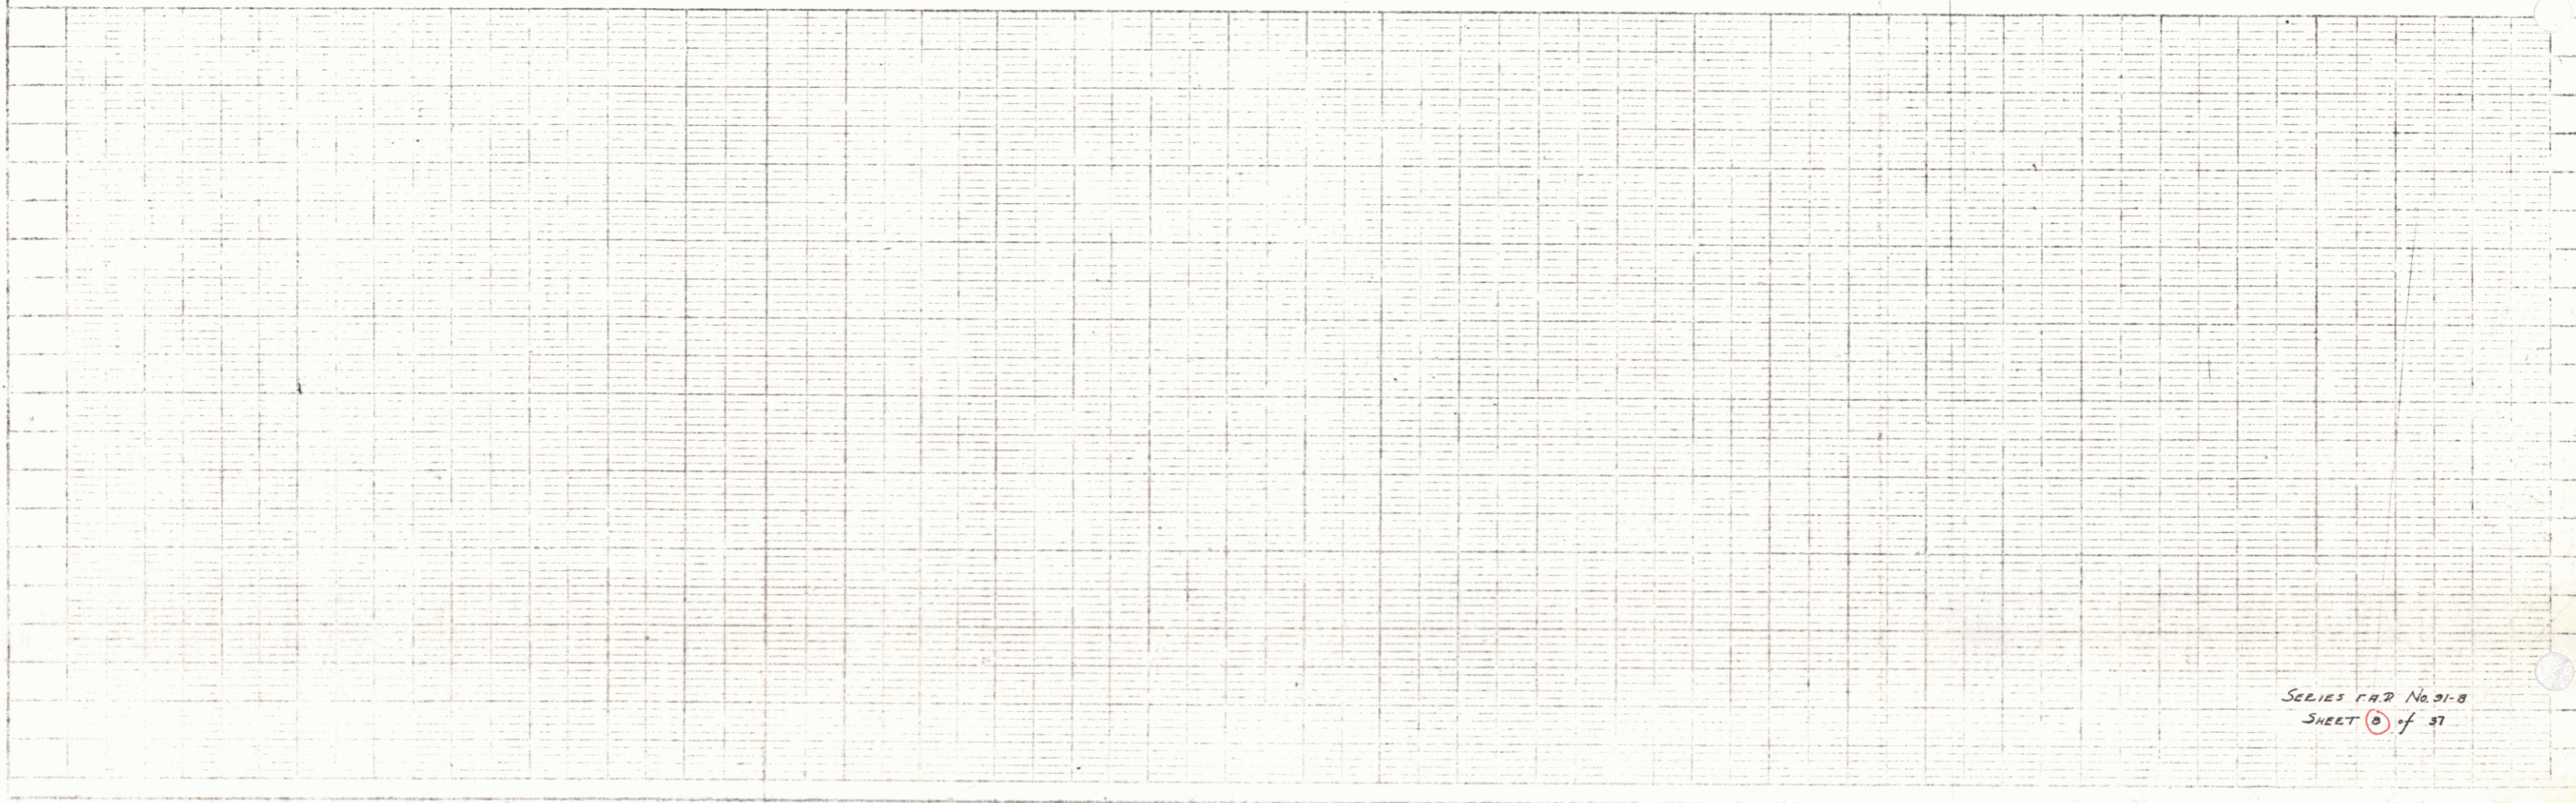

SERIES FAR No. 91-B  
 SHEET 8 of 31