


18

DATE	1/15/50
PROJECT	NEW YORK STATE THRUWAY
SECTION	CLARENCE
NO.	18
SCALE	1" = 40'
DESIGNED BY	...
CHECKED BY	...
APPROVED BY	...

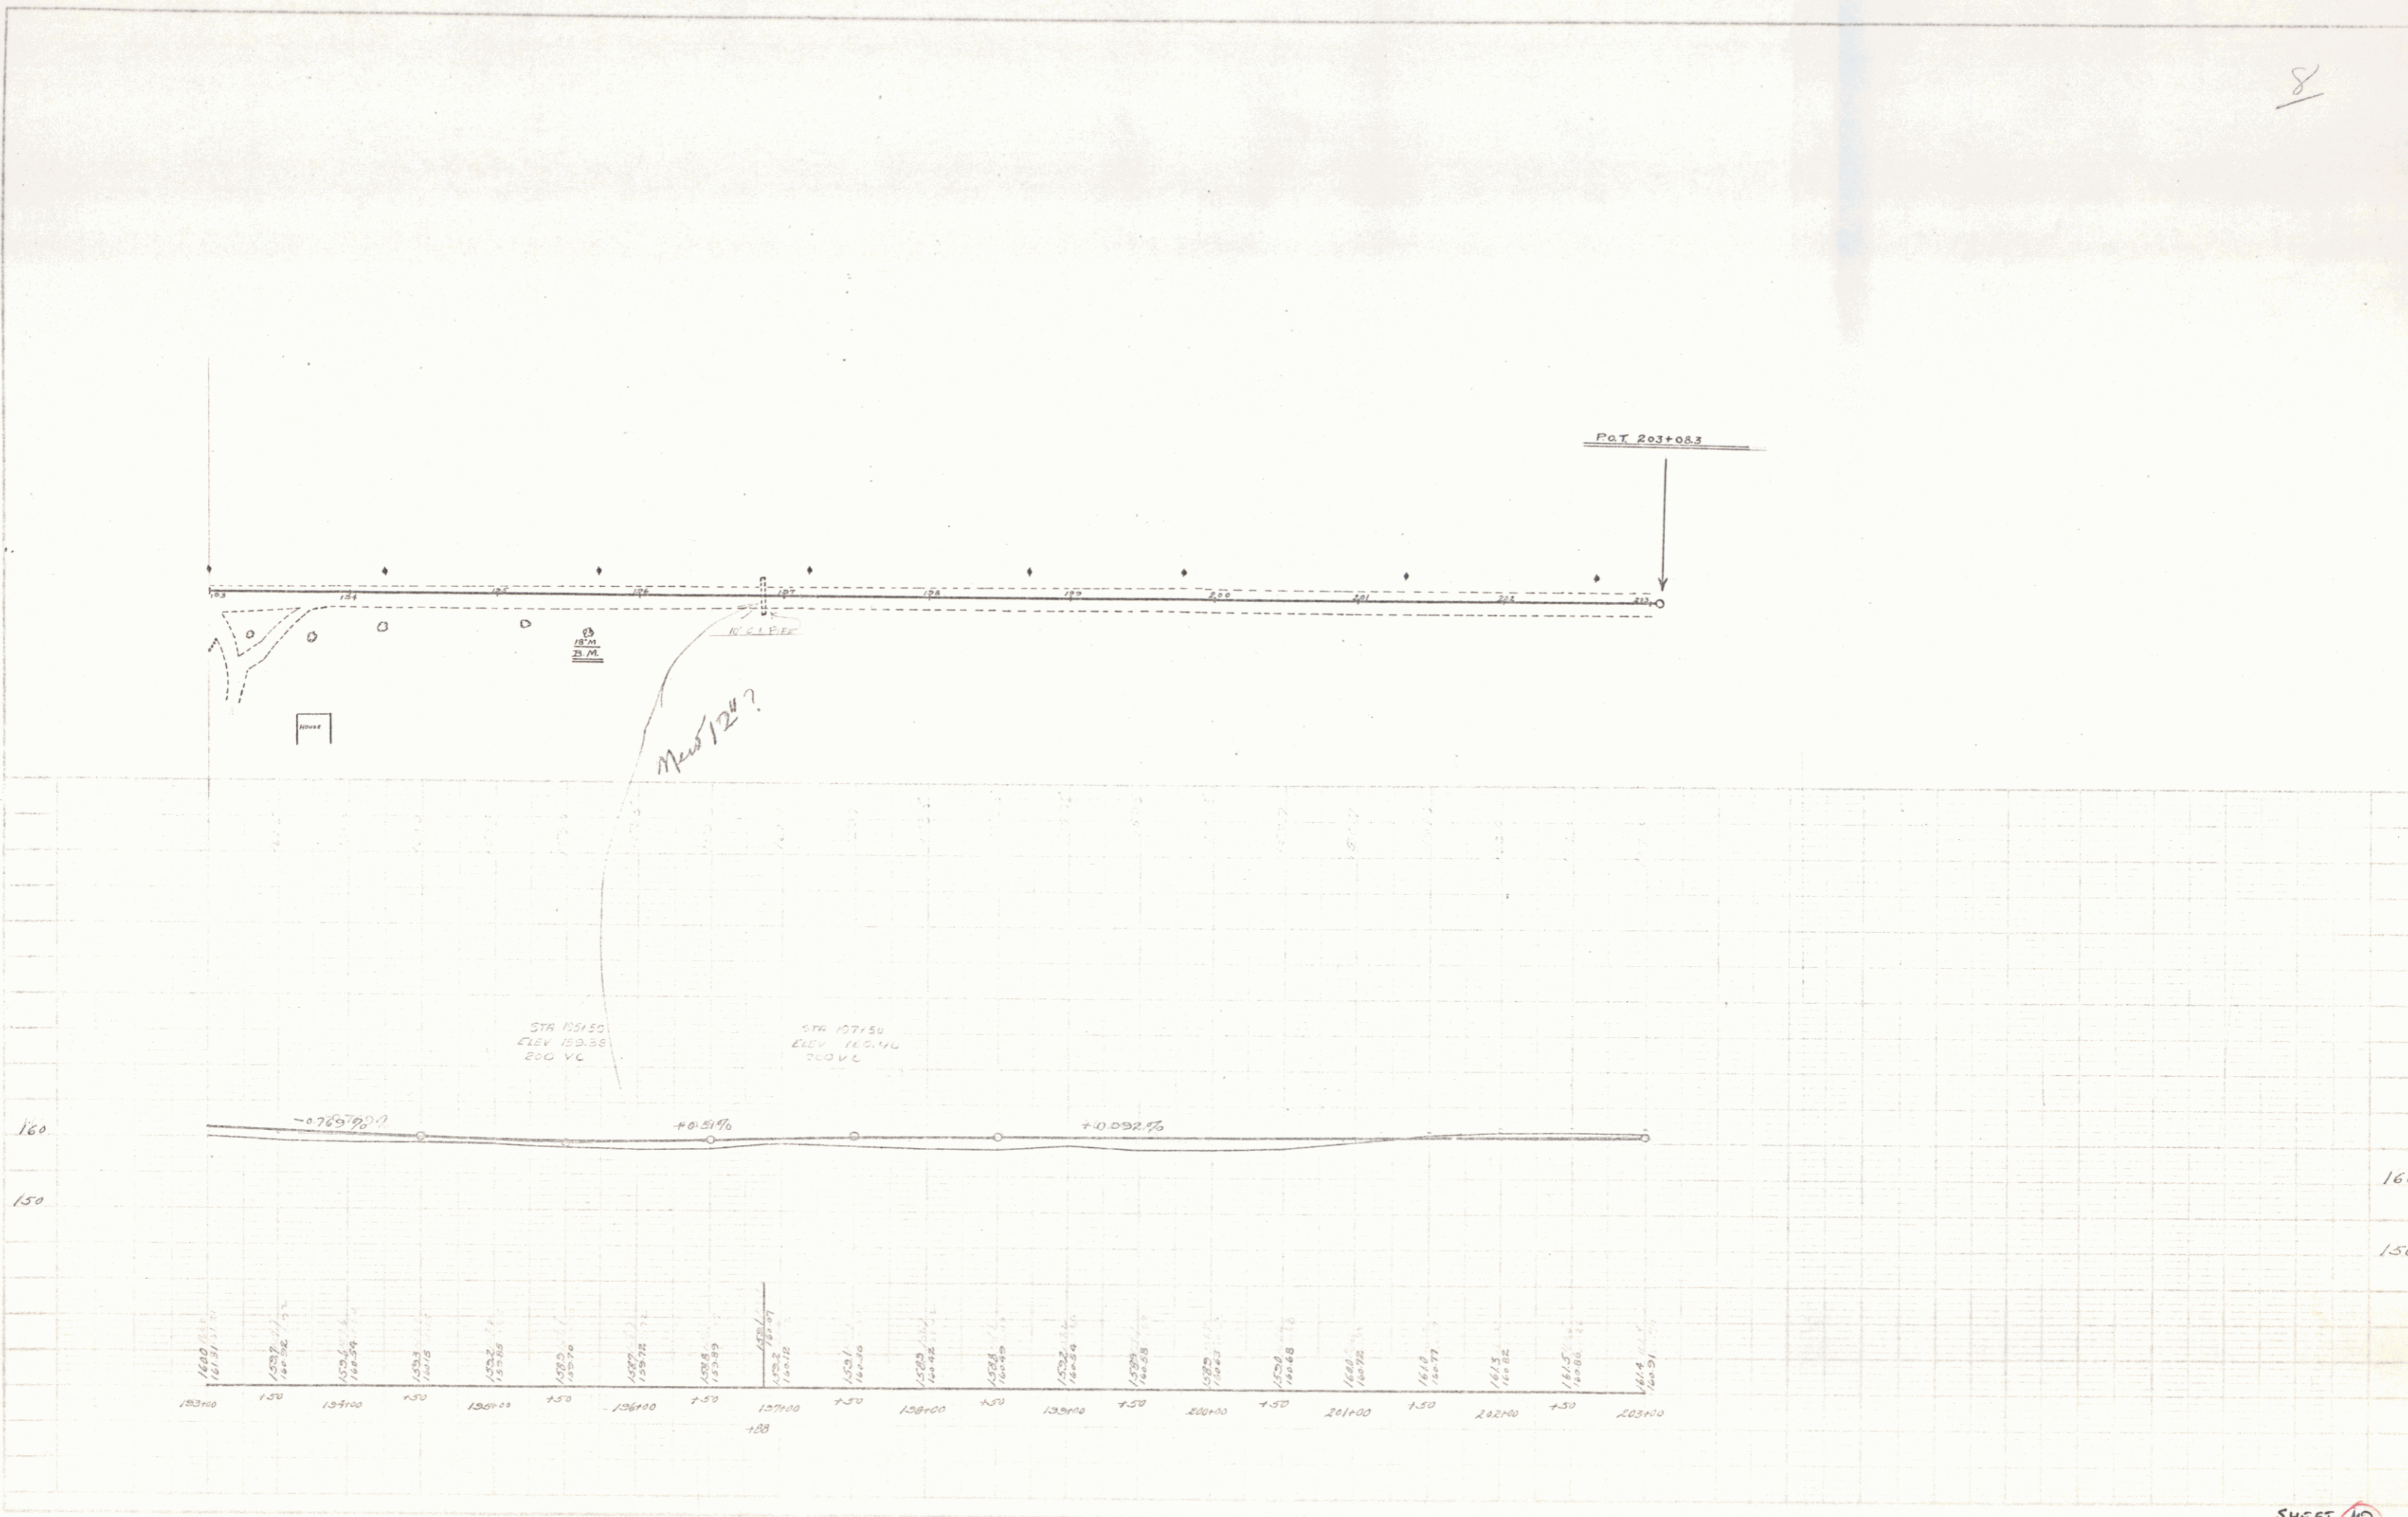

SHEET 18

18