
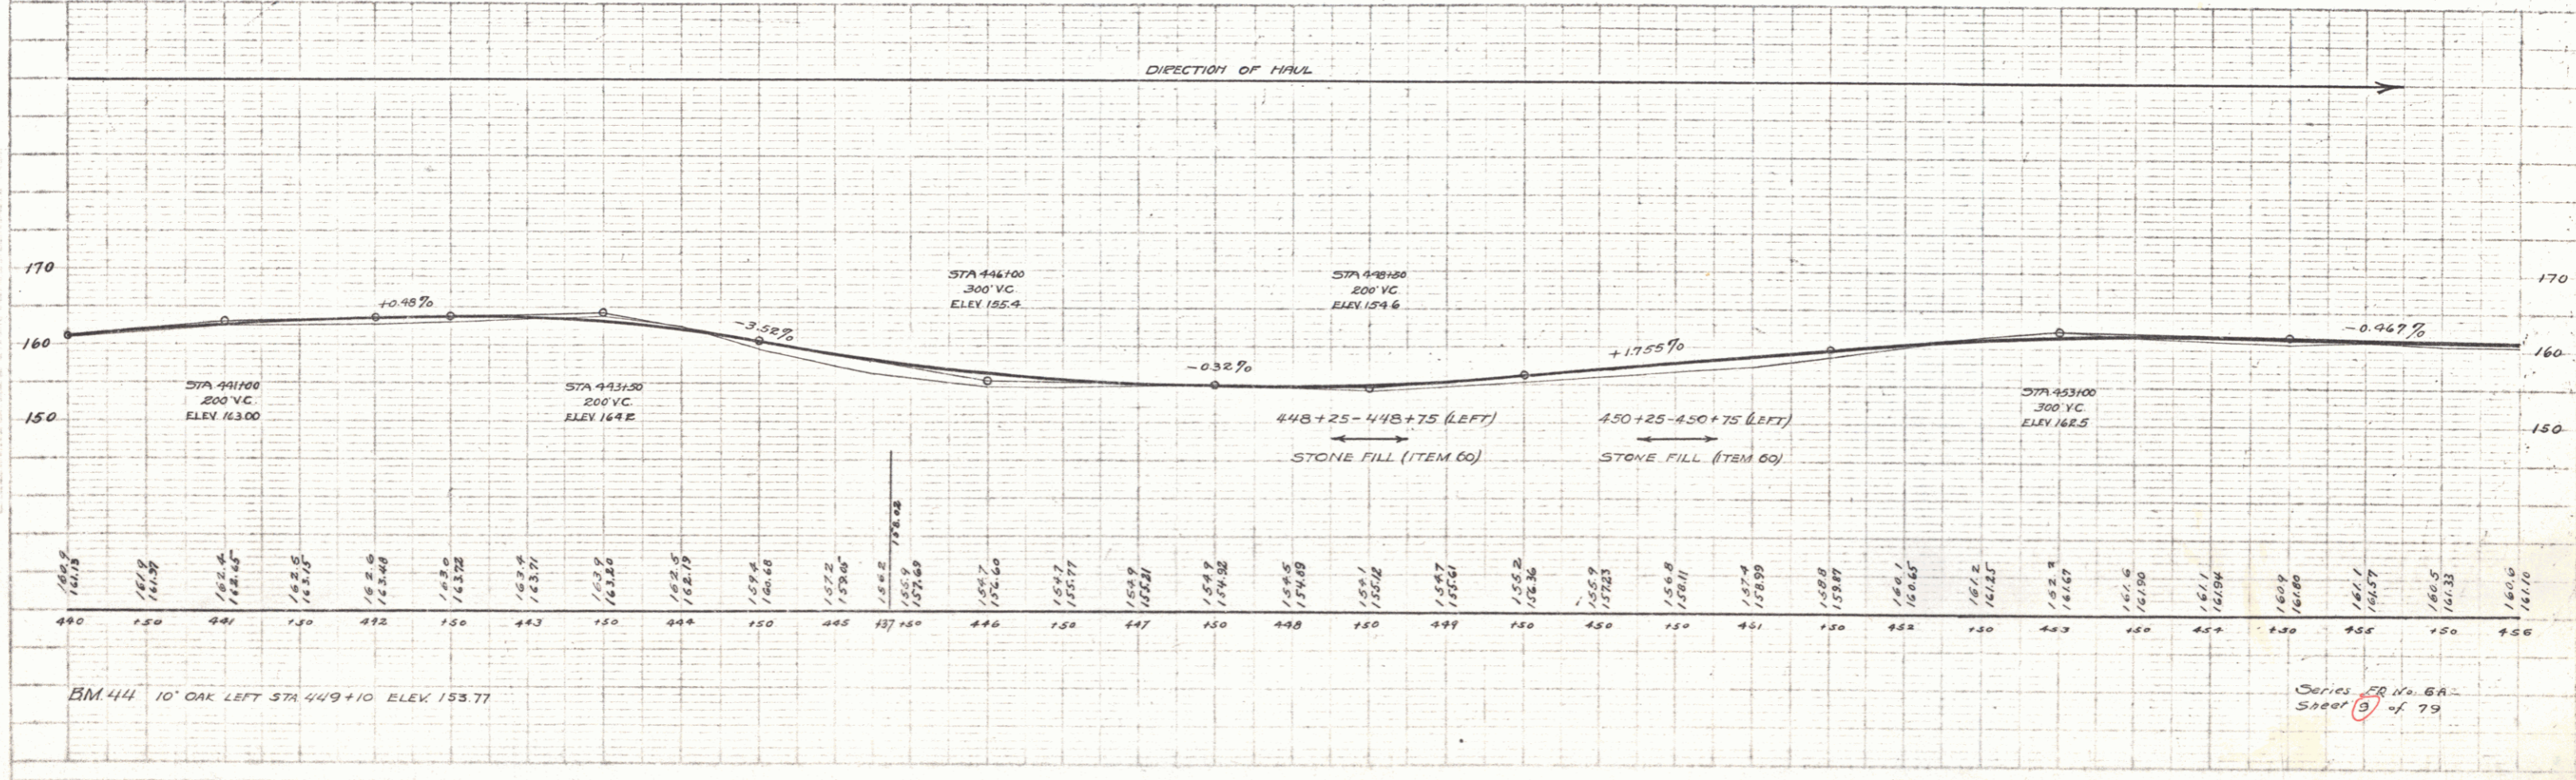


WOOD GUARD RAIL		CABLE GUARD RAIL	
RIGHT		LEFT	
445+25 - 445+49	Length 24'	444+26 - 445+54	Length 128'
447+63 - 448+02	" 24'	447+76 - 450+00	" 824'
LEFT			
441+63 - 441+87	Length 24'		

NEW CULVERTS REQUIRED			
Stn. 441+75	15" Rivet Coac Pipe	Length 32 ft	(15" Rivet Coac Pipe)
	Concrete Class D (1-24-3)	2.5 cu yds	Length 128 ft
	Reinforcing Steel	33 lbs.	
Stn. 445+37	18" Rivet Coac Pipe	Length 40 ft	
	Concrete Class A (1-1-4)	1.9 cu yds	
	Reinforcing Steel	29 lbs.	
Stn. 447+90	15" Rivet Coac Pipe	Length 32 ft	
	Concrete Class B (1-24-3)	2.6 cu yds	
	Reinforcing Steel	33 lbs.	

STATE	PROJECT	DATE	SHEET NO.	TOTAL SHEETS
VI	FR-62	1928	9	79

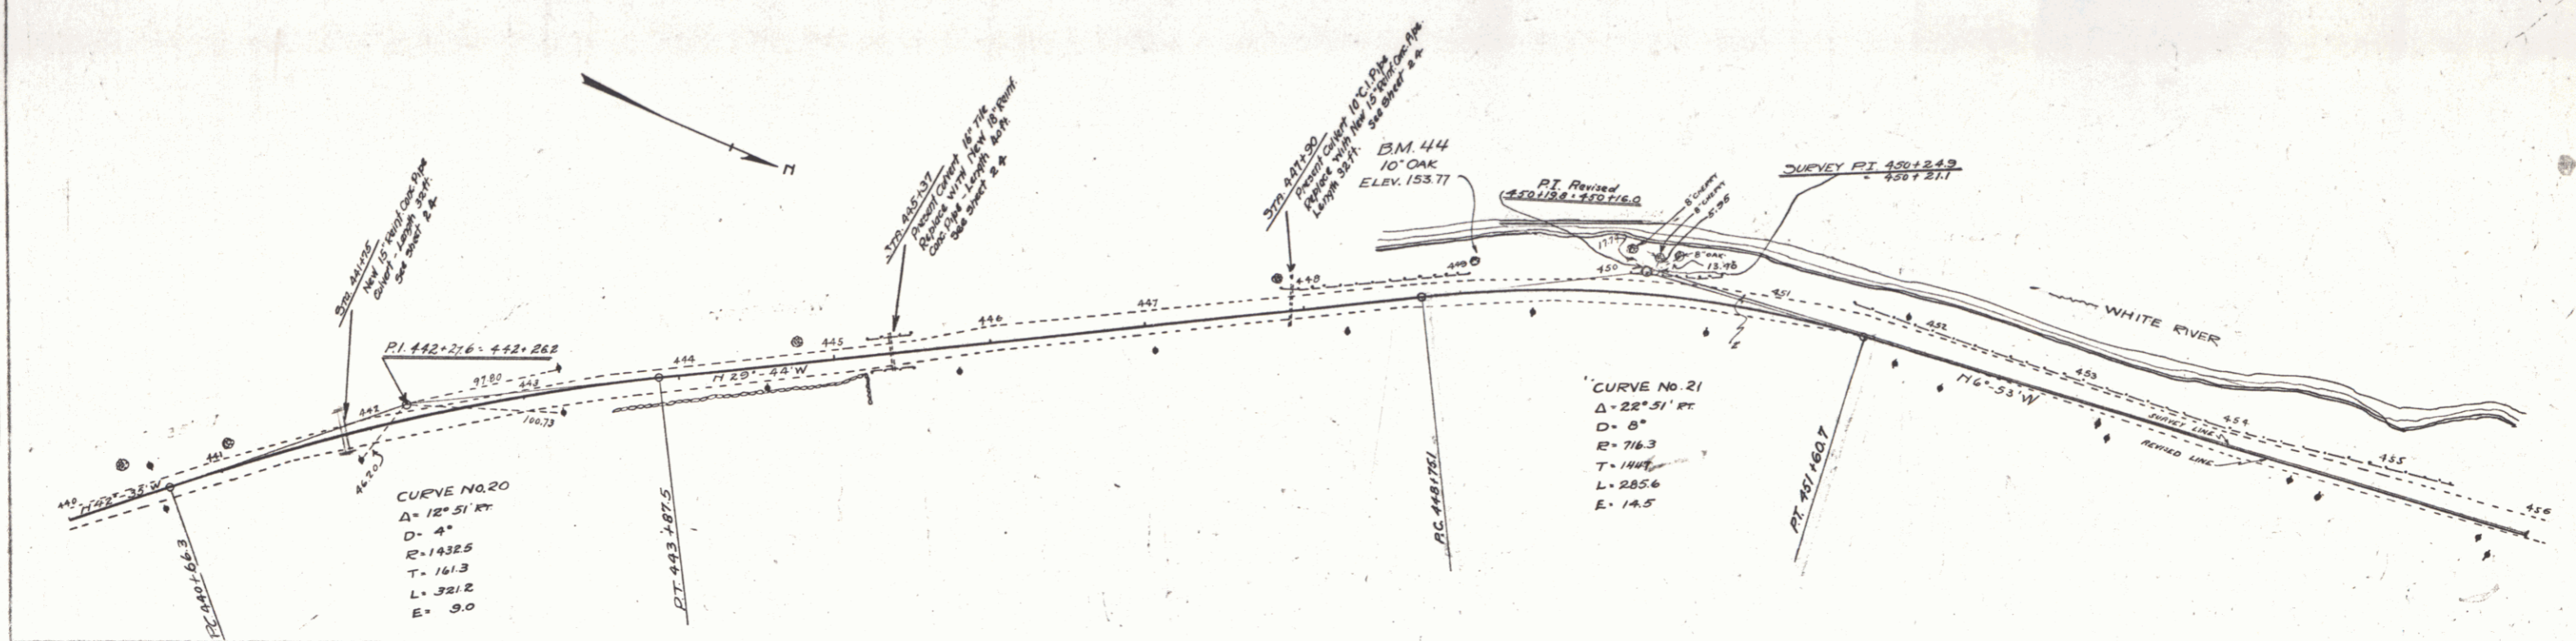

PLAN  
 SCALE: 1" = 40'  
 DATE: 1928

PROFILE  
 SCALE: 1" = 10'  
 DATE: 1928

Series 22 No. 6A  
 Sheet 9 of 79

81