

PLAN
A.D. WOOD
E. PLATTING
6442
4992



PROFILE
A.D. WOOD
E. PLATTING
6442
4992

WOOD GUARD RAIL
RIGHT
51015-51062 Length 47'
51015-51039 " 24'

CABLE GUARD RAIL
LEFT
50745-51017 Length 272'
51210-51410 " 200'
51820-51910 " 70'

NEW CULVERTS REQUIRED
18" Reinf. Conc. Pipe Length 74'
Conc. Class A (1-2-4) 19 cu yds.
Reinf. Steel 54 lbs.
15" Reinf. Conc. Pipe Length 36'
Conc. Class B (1-2-5) 4.6 cu yds.
Reinf. Steel 33 lbs.

LEGEND
STATE 110 70
VI. FRGA 1928 13 79

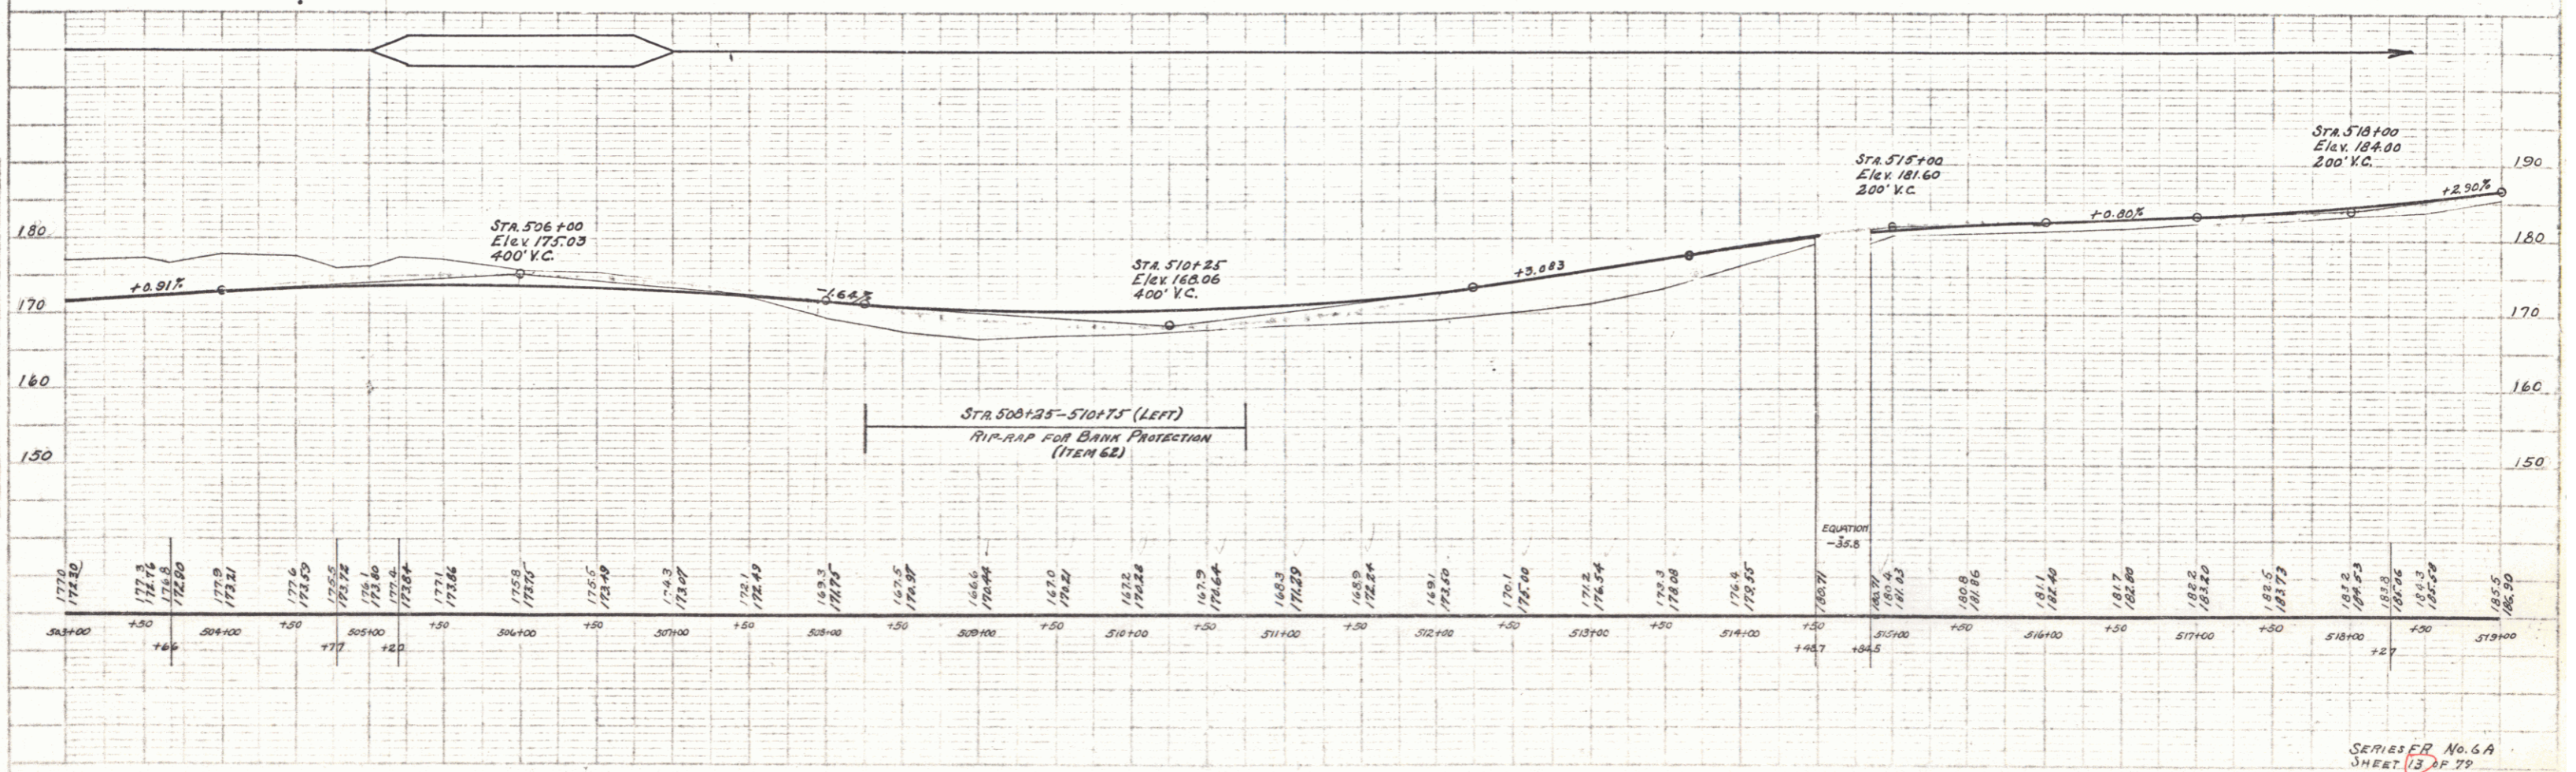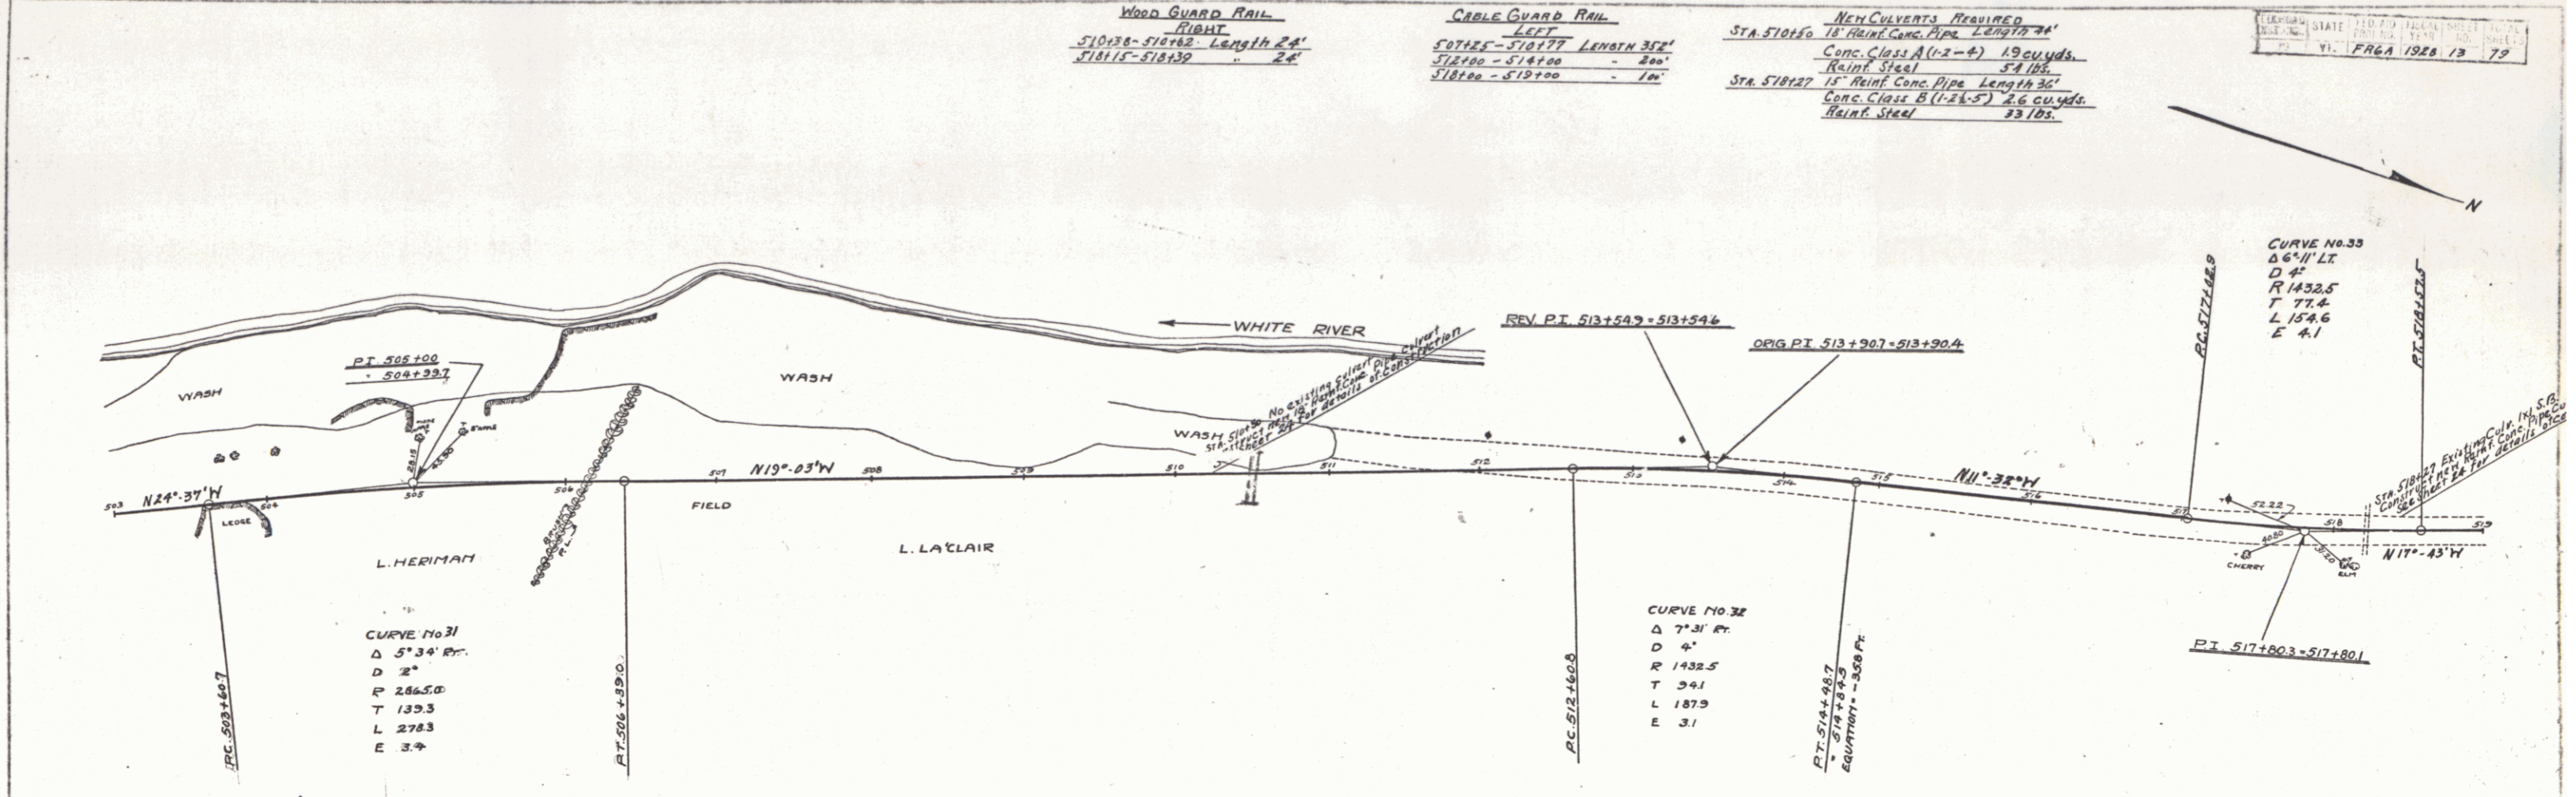

SERIES ER No. 6A
SHEET 13 OF 29

13