
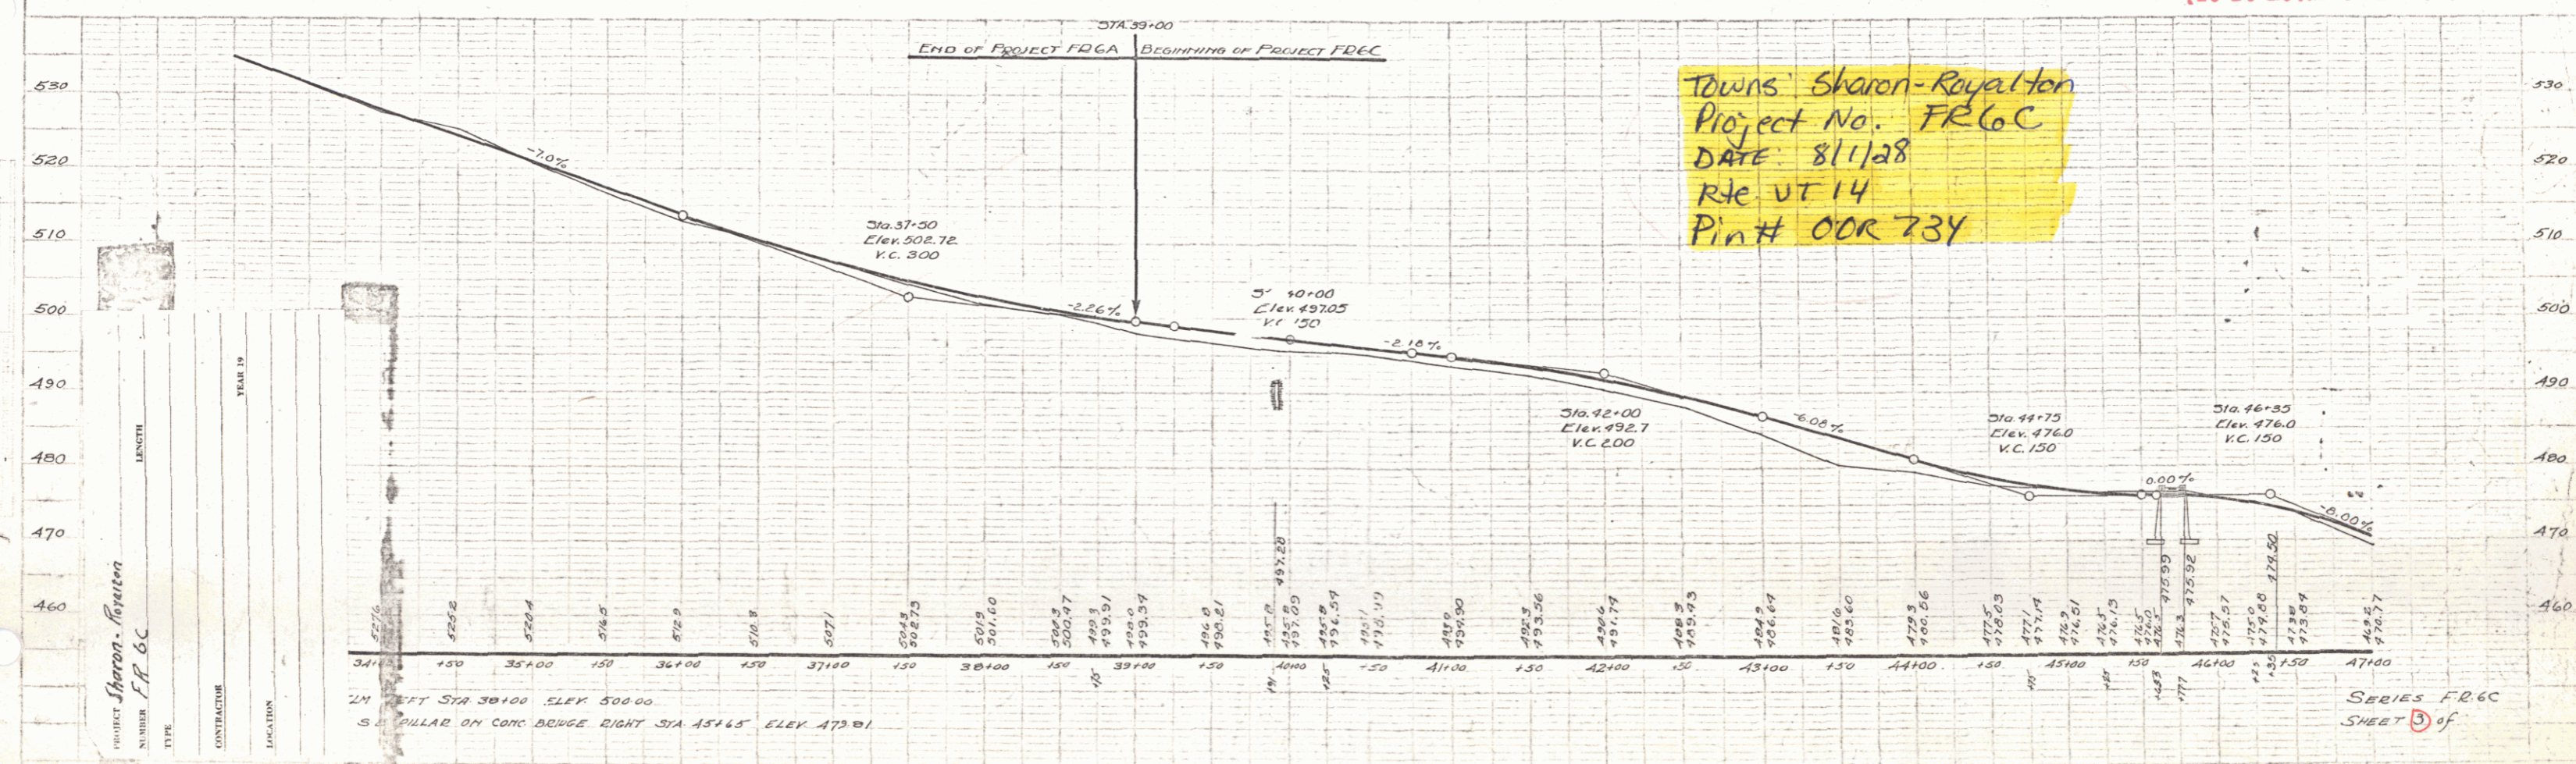


Sharon T/L Royalton  
 7,565 0+00  
 MP 3.901 STA 39+00 STA 232+46 STA 361+36  
 MP 2.441

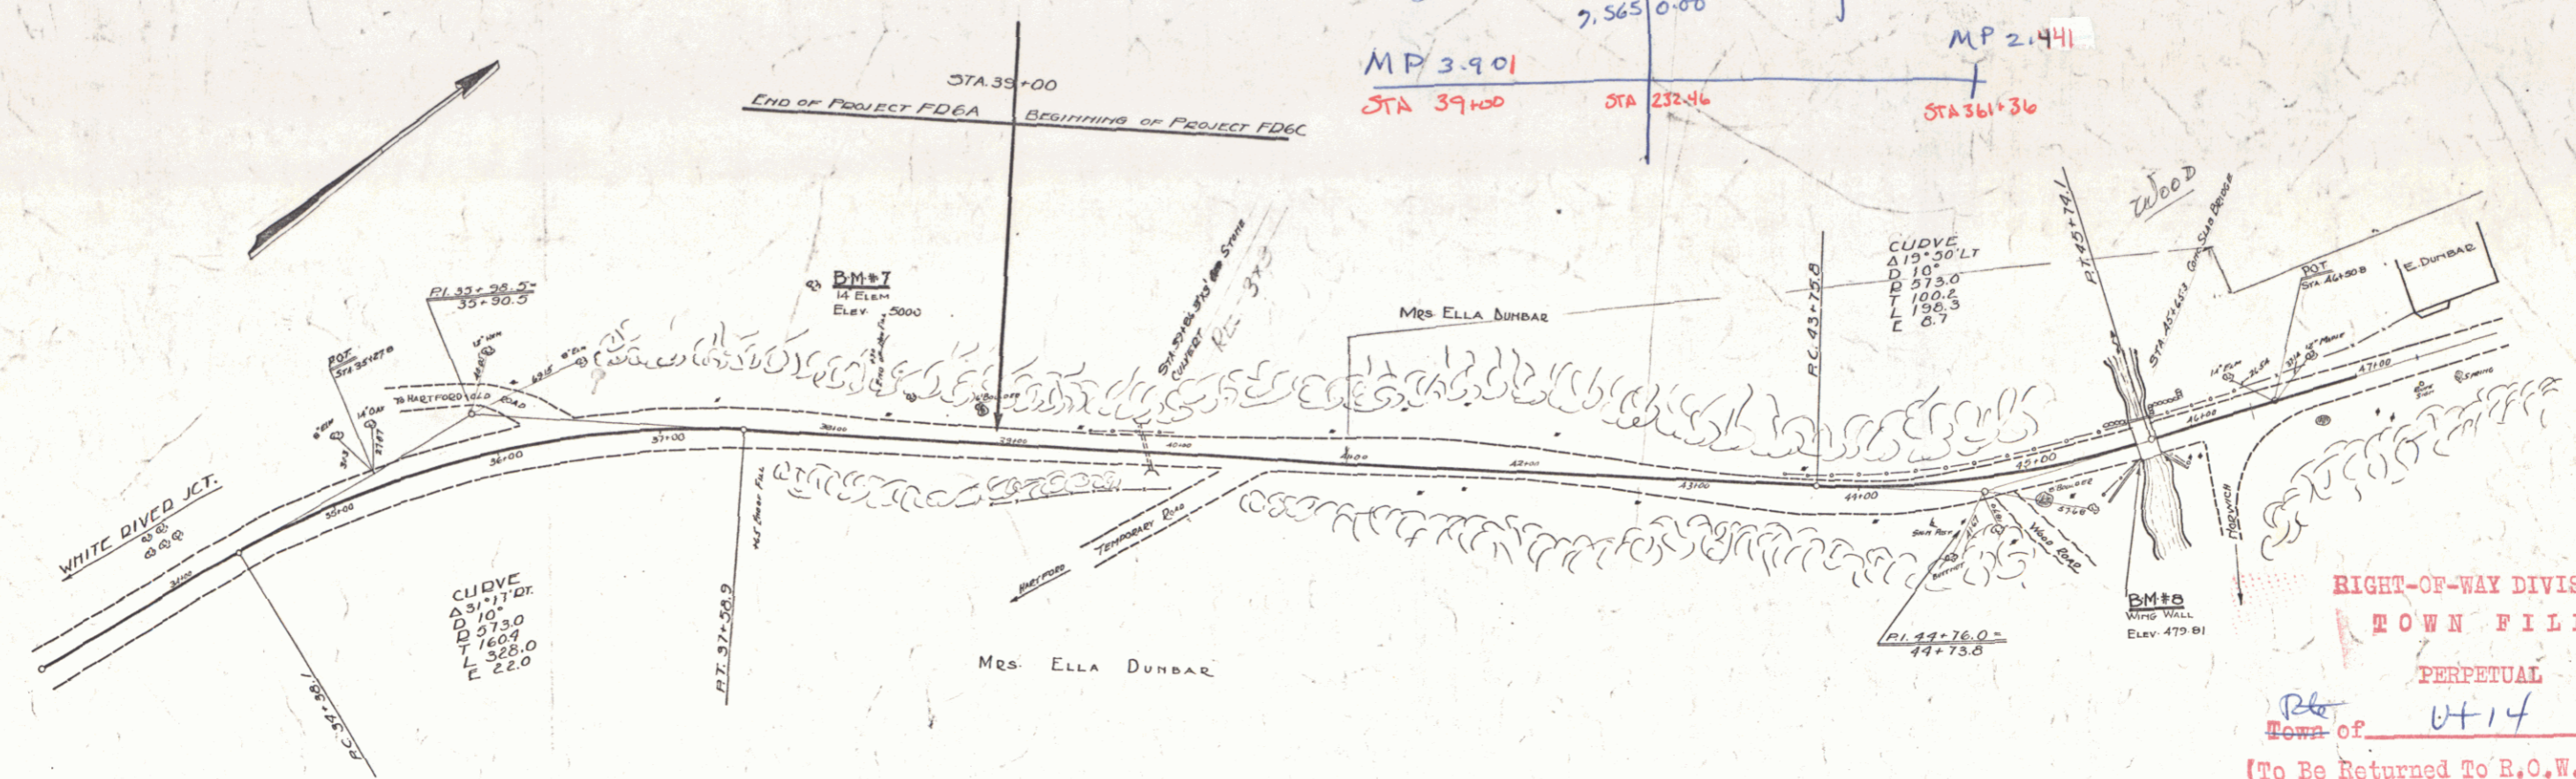

PLAN  
 DATE 8/1/28  
 DRAWN BY [illegible]  
 CHECKED BY [illegible]

PROFILE  
 DATE 8/1/28  
 DRAWN BY [illegible]  
 CHECKED BY [illegible]

PROJECT Sharon-Royalton  
 NUMBER FR 6C  
 TYPE  
 CONTRACTOR  
 LOCATION

24' WIDE STA 39+00 SLPK 500.00  
 S. PILLAR ON CONC BRIDGE RIGHT STA 45+45 ELEV. 479.01

SERIES FR 6C  
 SHEET 3 of 3