
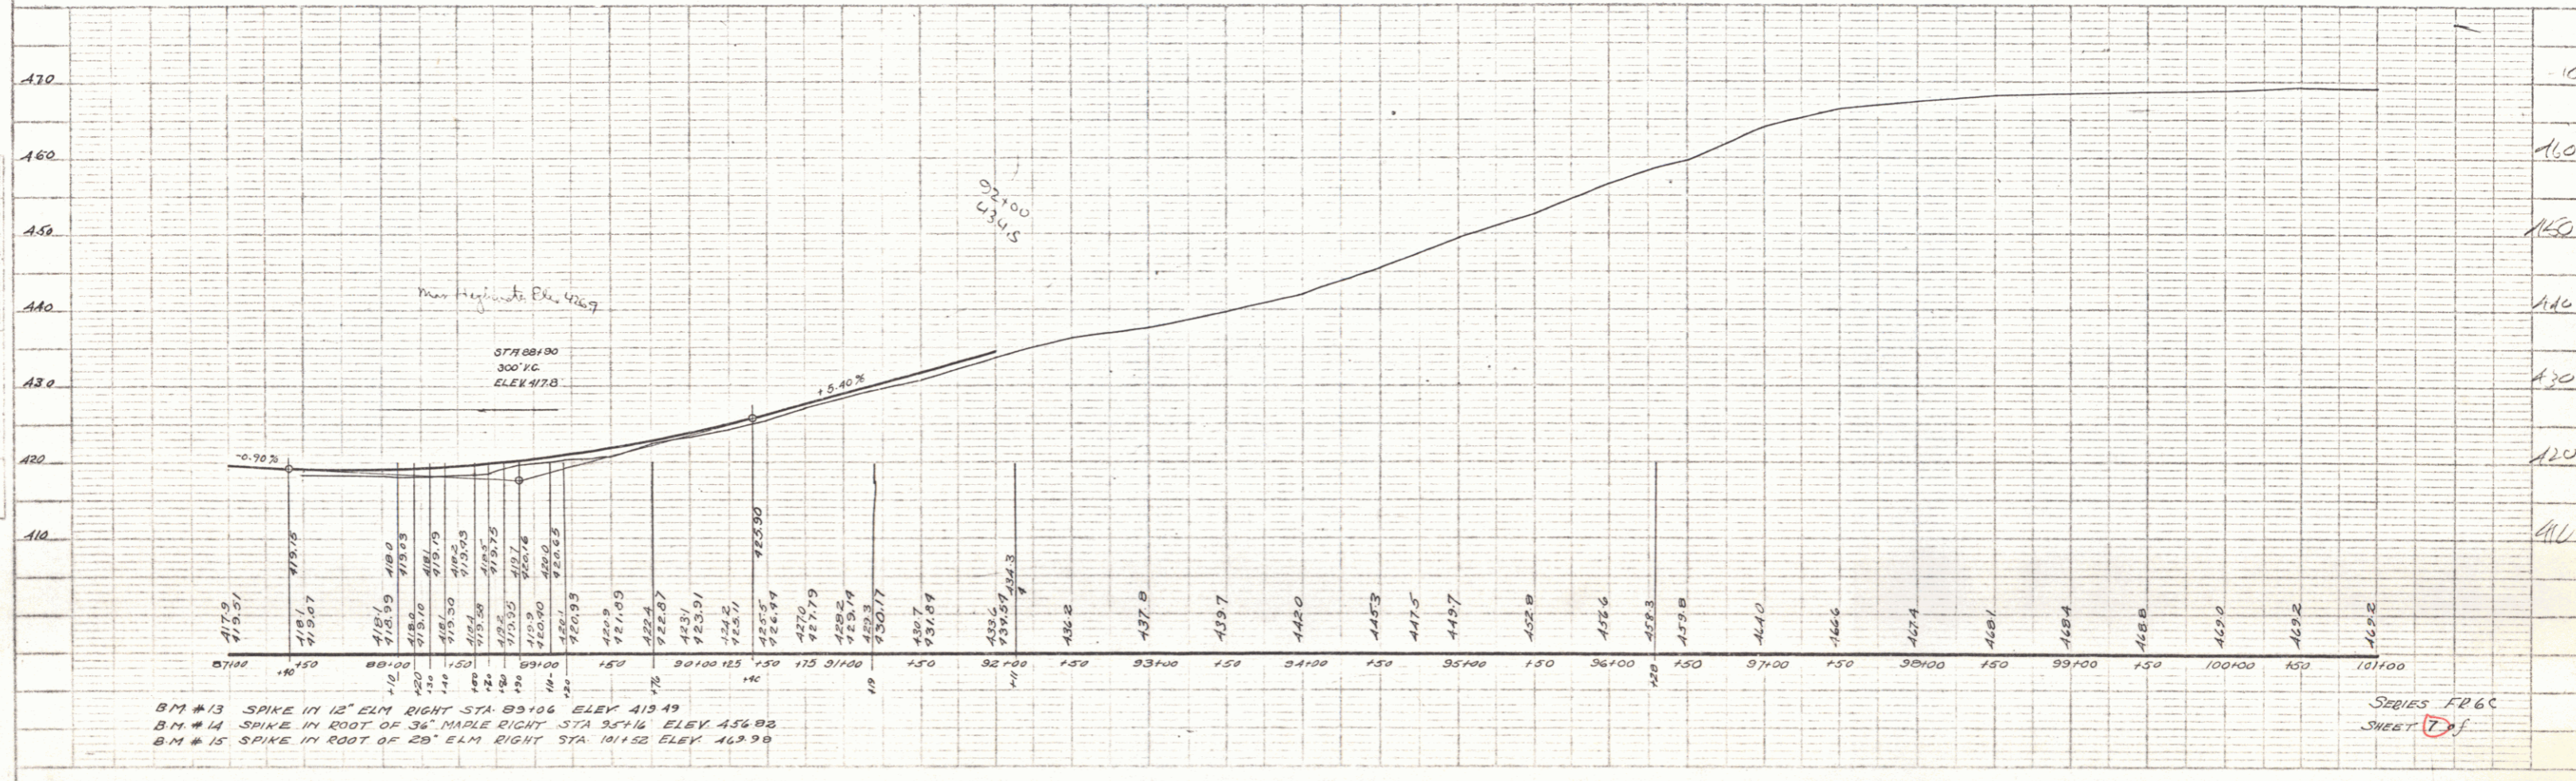


PLAN
 DATE 8/28
 3472AM
 S.W.C.

PROFILE
 DATE 8/28
 3472AM
 S.W.C.

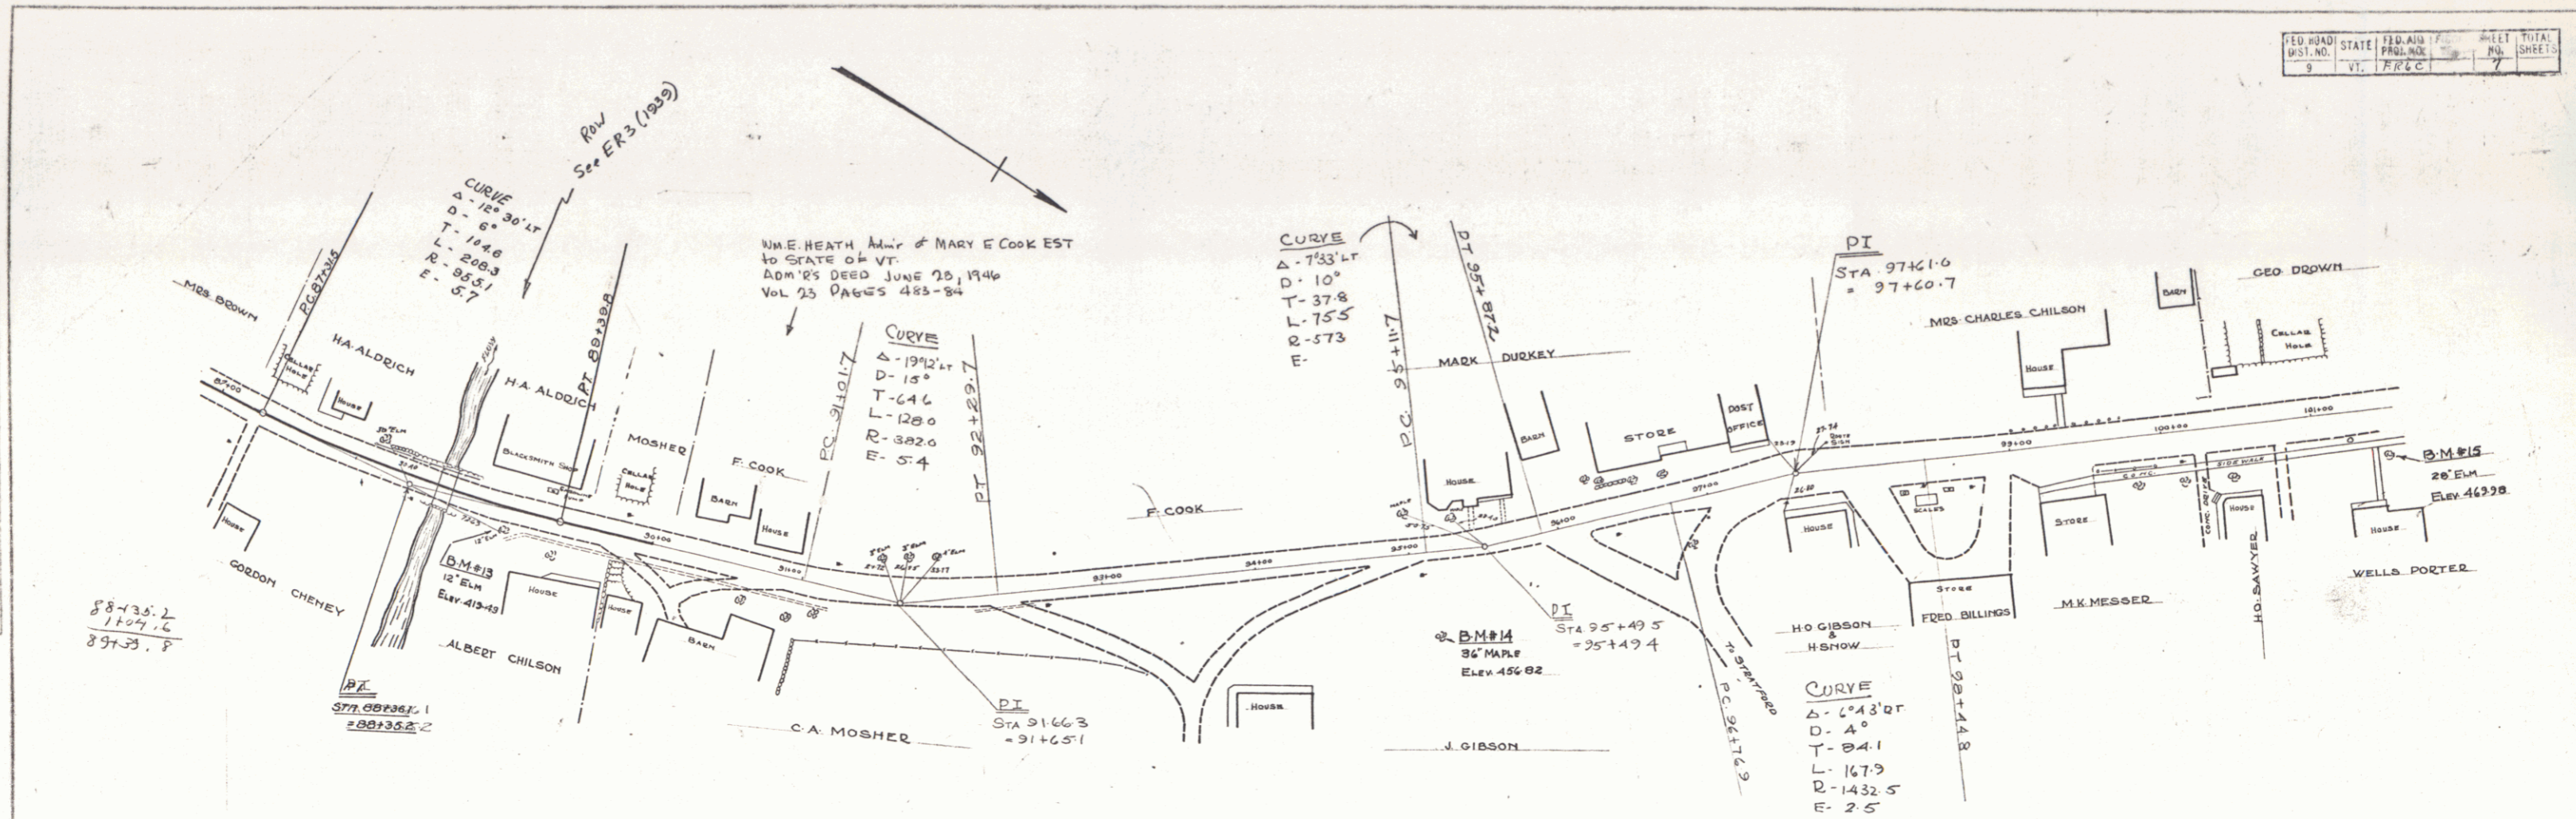

B.M. #13 SPIKE IN 12" ELM RIGHT STA 89106 ELEV 419.49
 B.M. #14 SPIKE IN ROOT OF 36" MAPLE RIGHT STA 95116 ELEV 456.82
 B.M. #15 SPIKE IN ROOT OF 20" ELM RIGHT STA 101152 ELEV 469.98

SERIES FR 6C
 SHEET 7 of 7