

FED. ROAD DIST. NO.	STATE	FED. AID PROJ. NO.	FISCAL YEAR	SHEET NO.	TOTAL SHEETS
9	VT.	FR66C		8	

PLAN
 DATE 8/22/66
 DRAWN BY S.W.C.
 CHECKED BY S.W.C.

PROFILE
 DATE 8/22/66
 DRAWN BY S.W.C.
 CHECKED BY S.W.C.

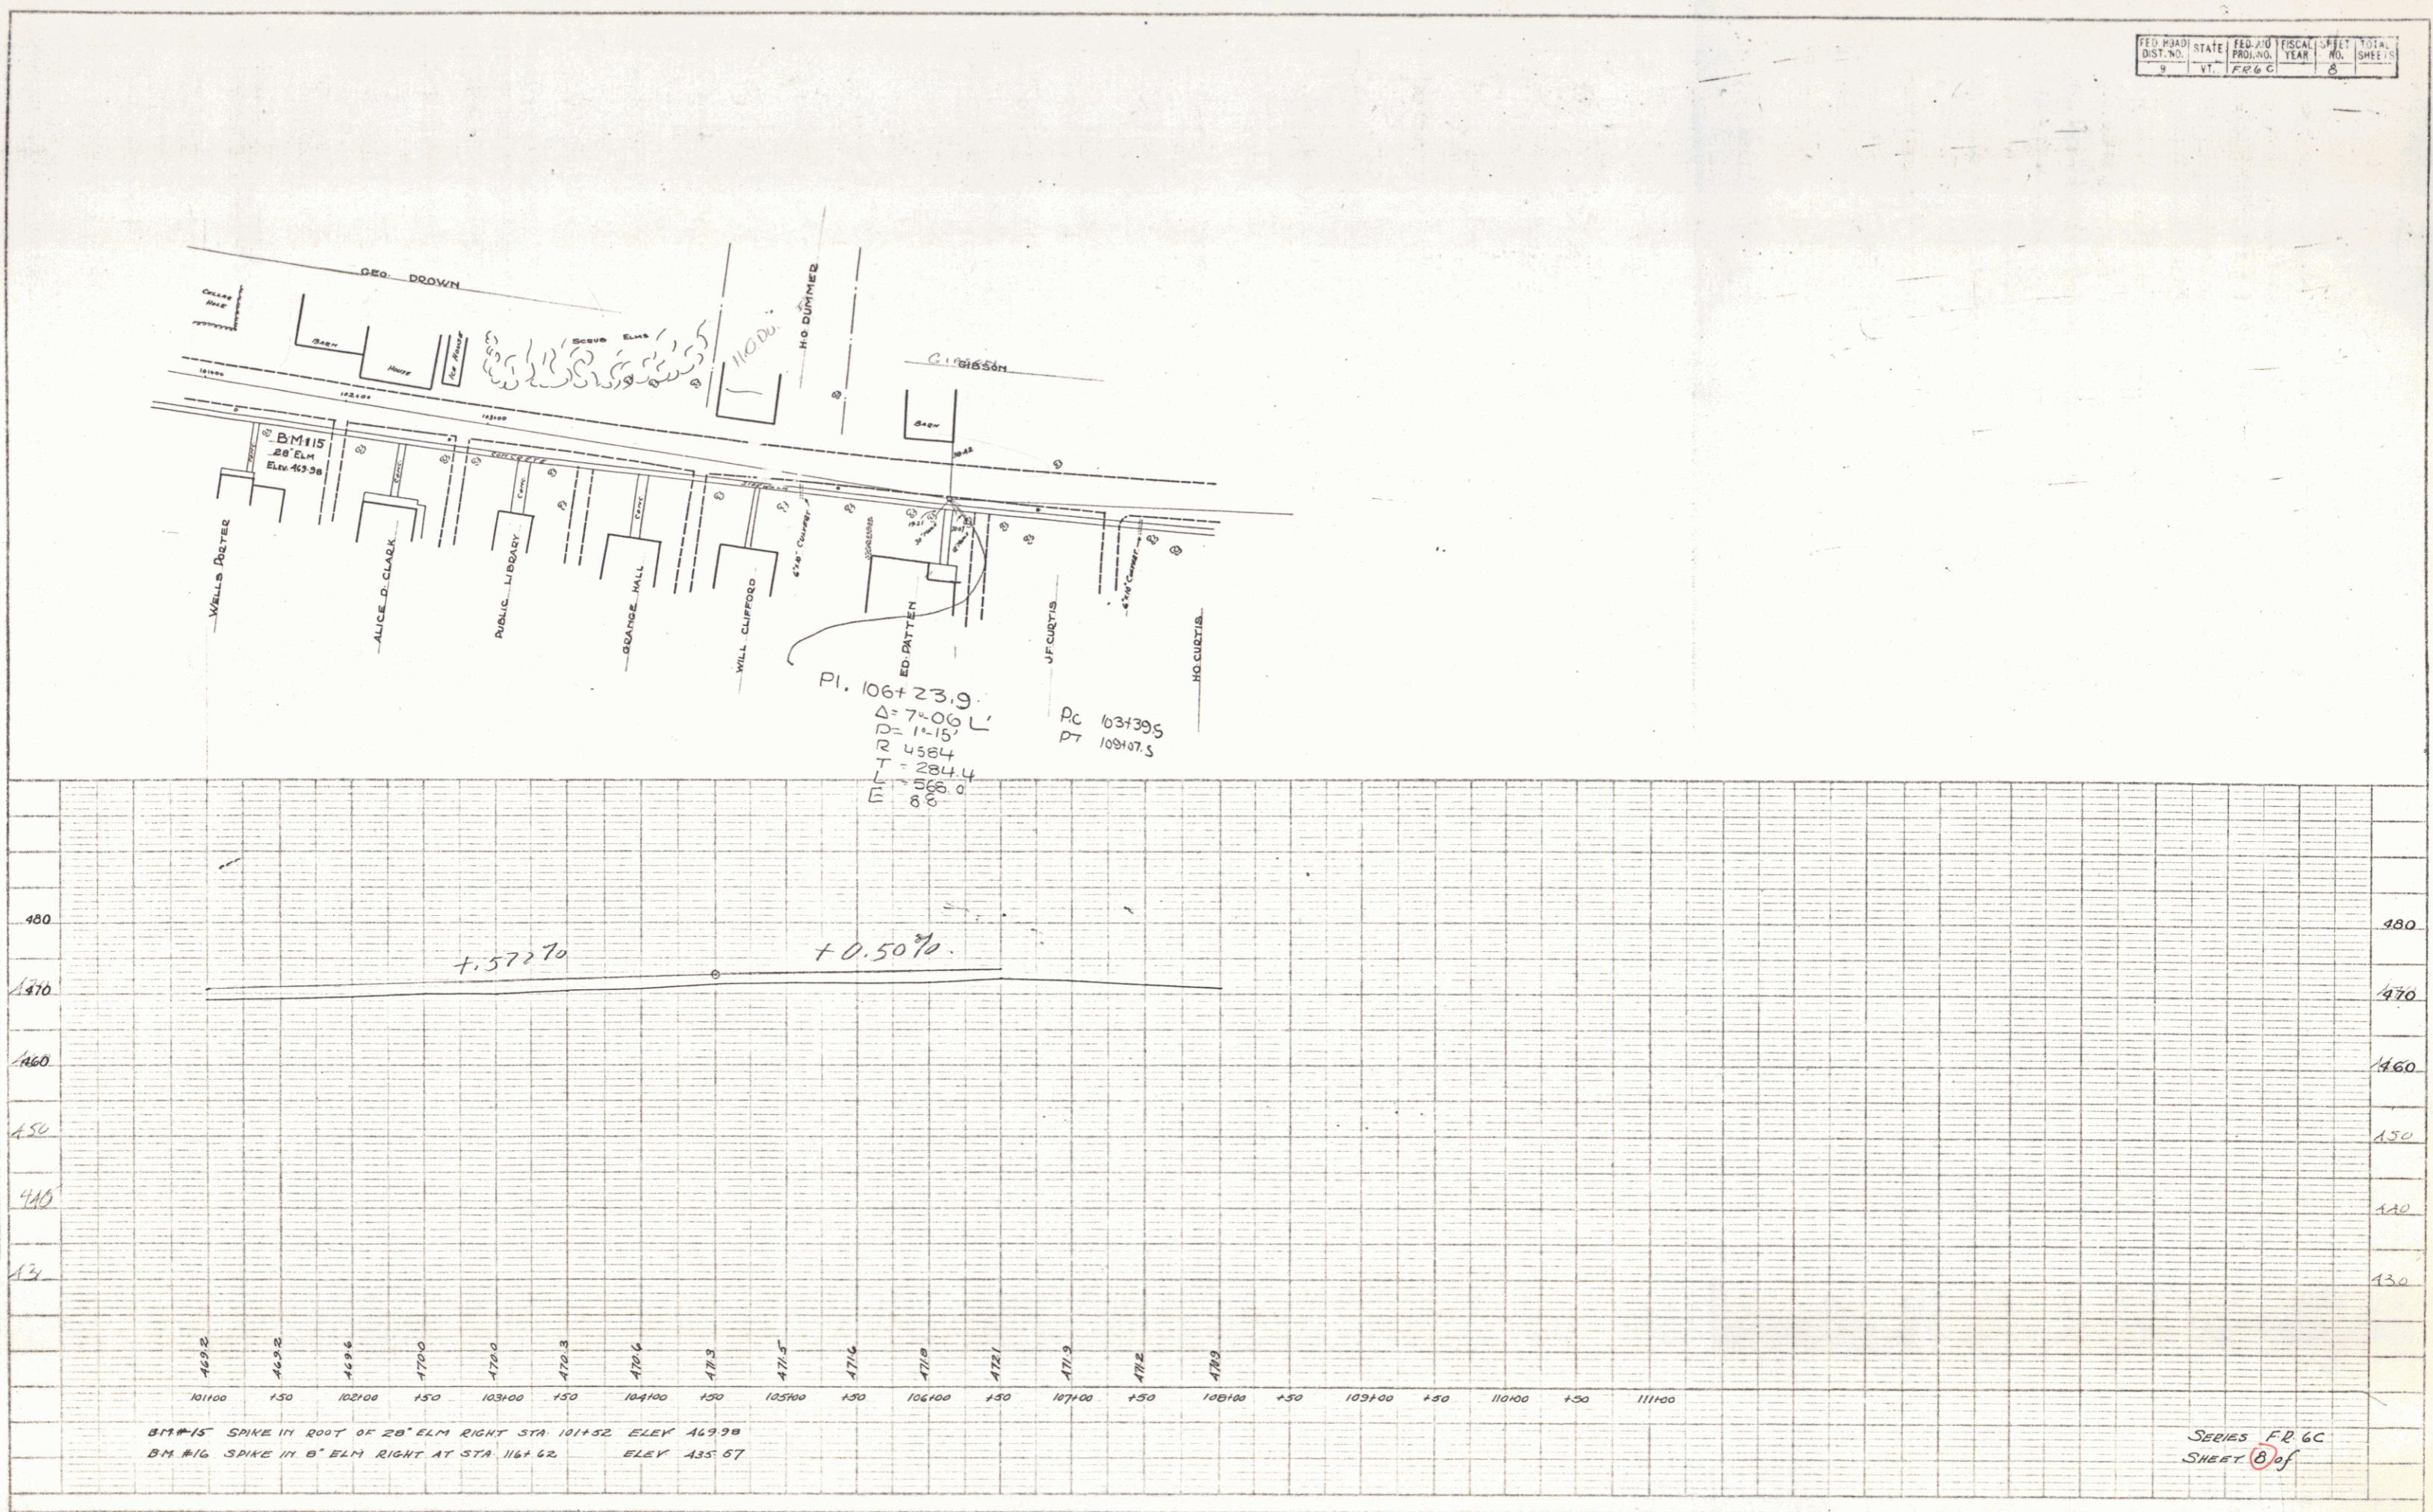


PLATE 1-PLAN-PROFILE - F. & E. STANBRO
 REGISTERED & PATENTED BY THE ENGINEER