



STA 121+00 - 133+00 QUANTITIES

FILL = 4077 c.y.
 Factor = 1.10
 FILL incl. Factor 4485 c.y.
 CUT = 1016 c.y.
 Borrow = 3469 c.y.

DESIGN	STATE	FEDERAL	LOCAL
10	10	10	10
10	10	10	10
10	10	10	10

PLAN
 DRAWN BY
 CHECKED BY
 DATE
 PROJECT NO.
 SHEET NO.

PROFILE
 DRAWN BY
 CHECKED BY
 DATE
 PROJECT NO.
 SHEET NO.

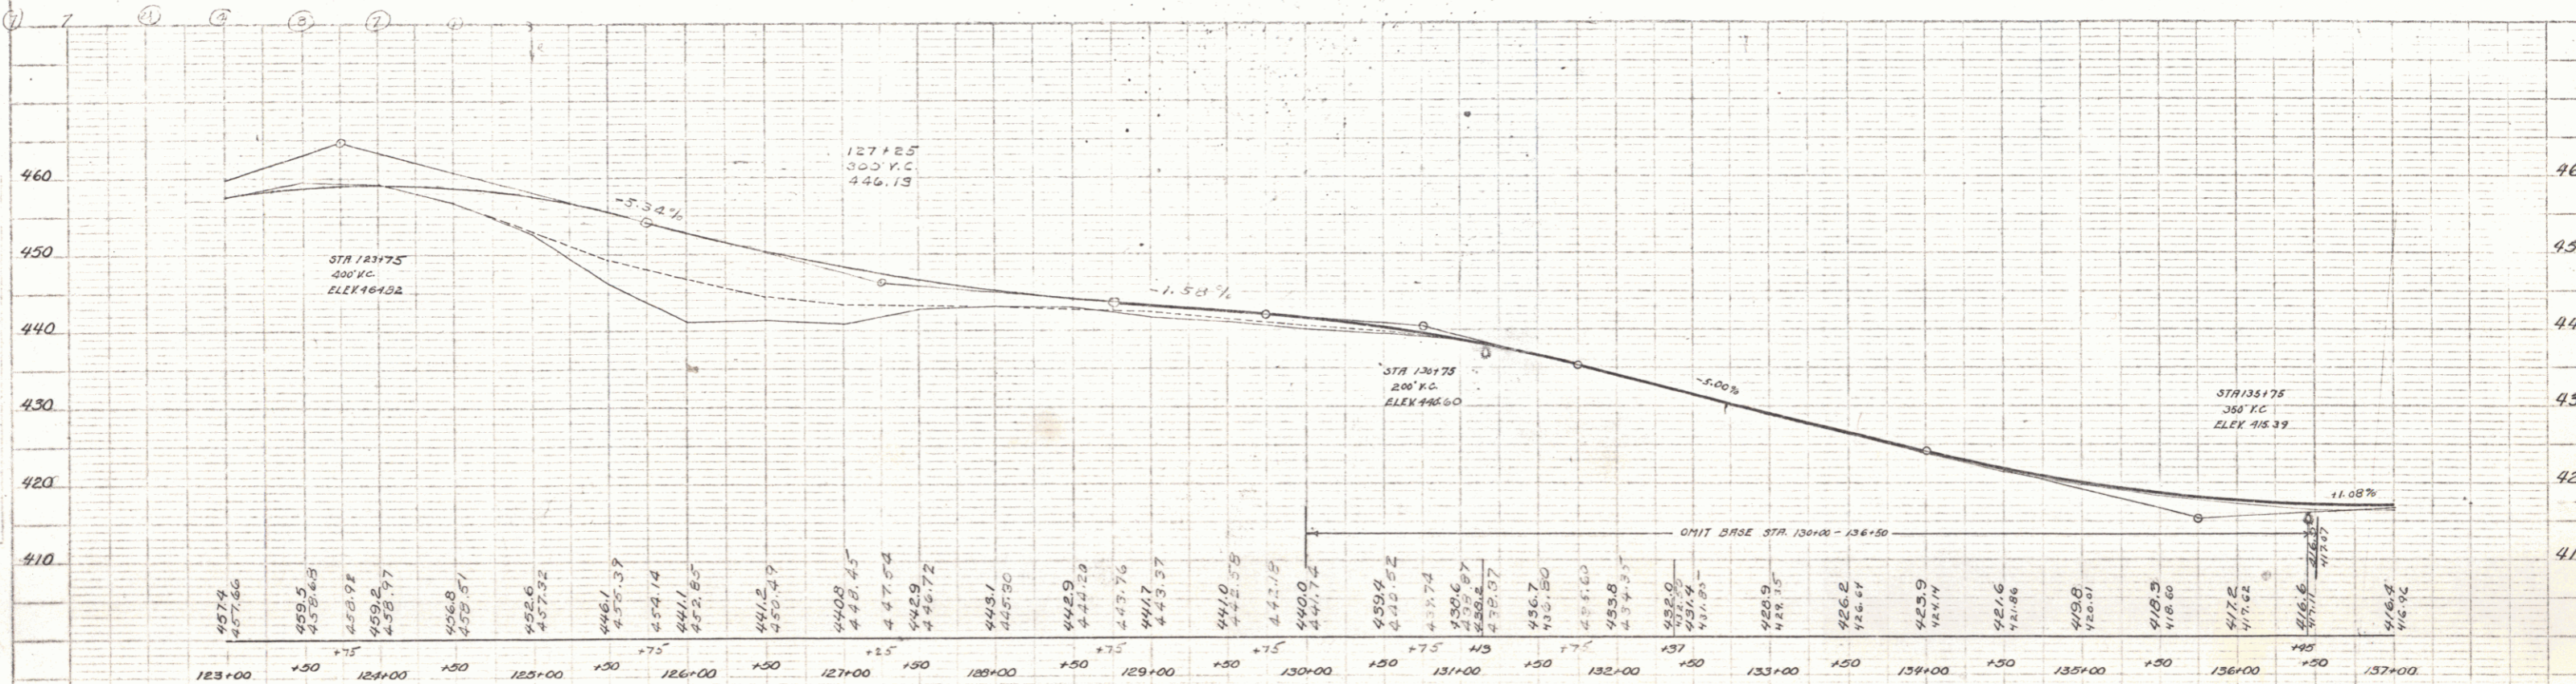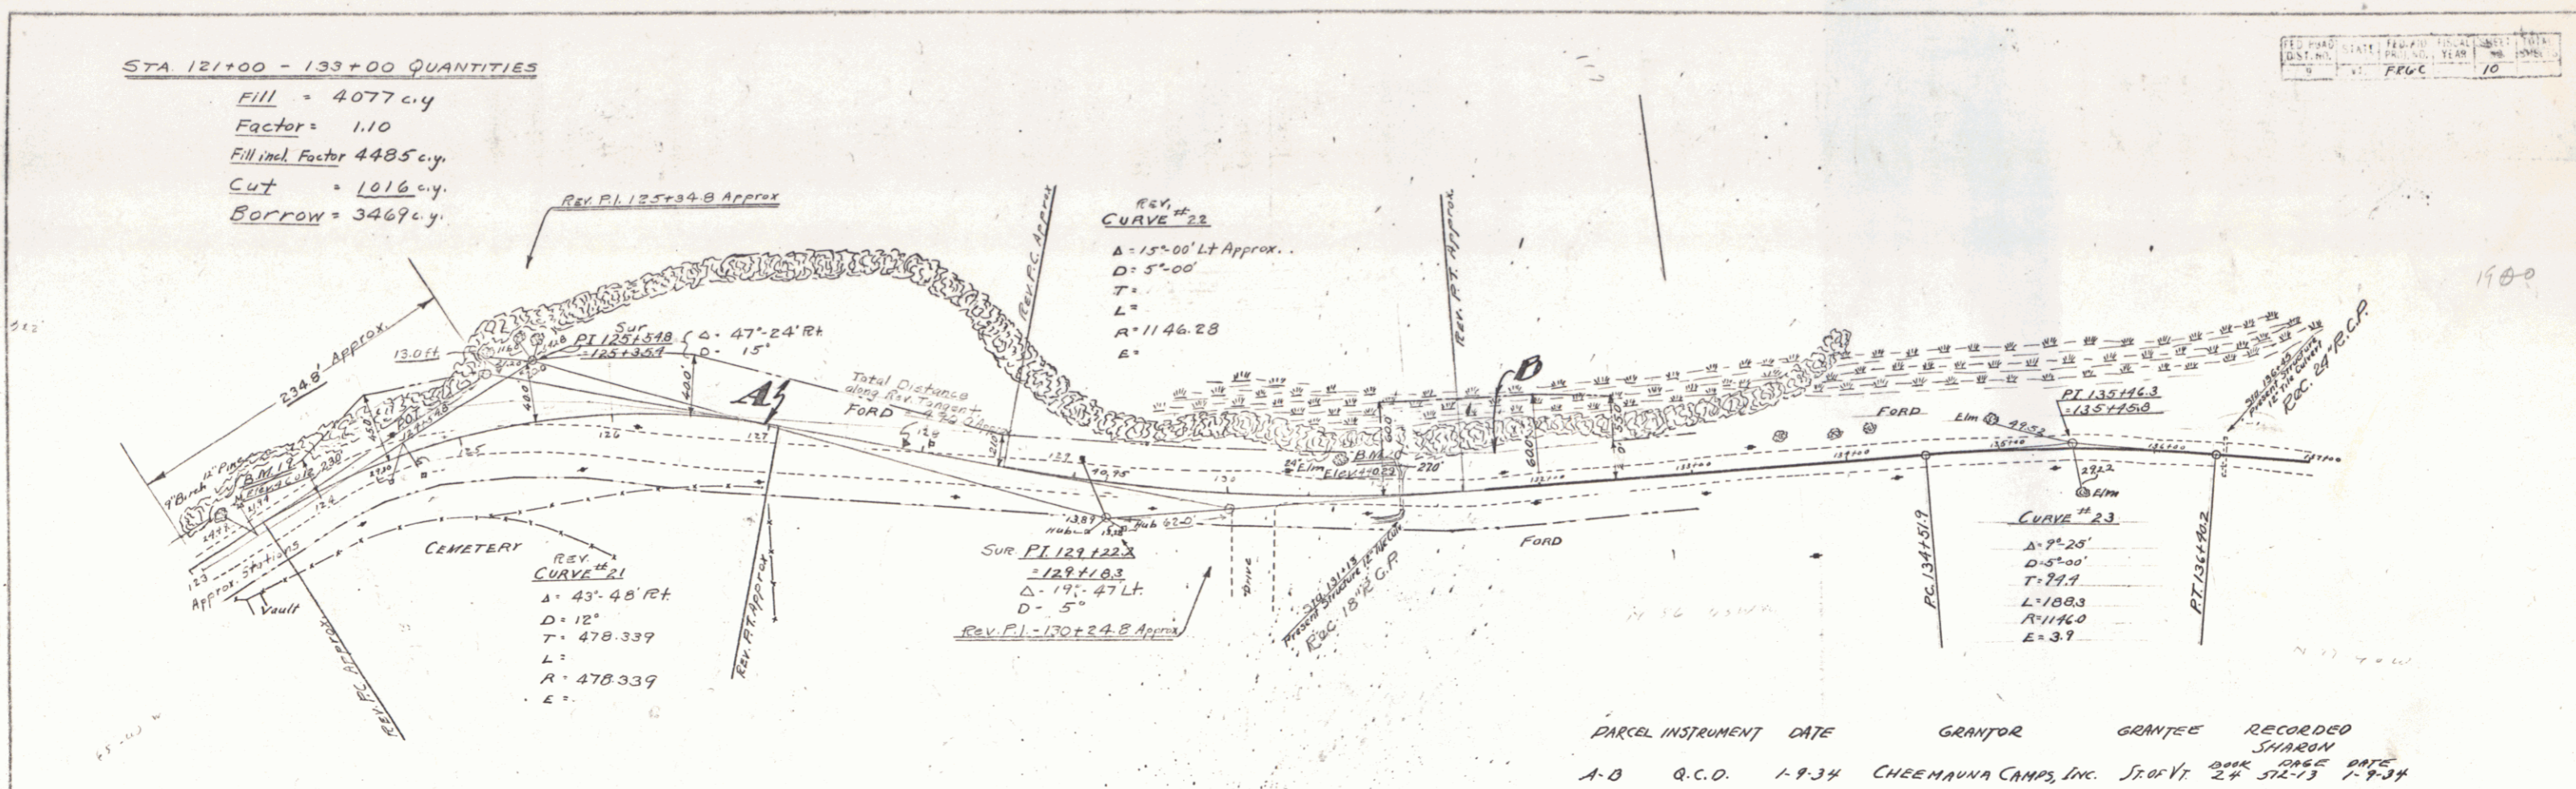

BM. #19 SPIKE IN 12" PINE OPP. CEM. LEFT STA. 123+12 ~ ELEV. 460.12
 BM. #20 SPIKE IN 24" ELM OPP. CAMP CHEEMAUNA LEFT STA. 130+70 ~ ELEV. 440.29

SERIES FR. No 6C
 SHEET 10 OF