


PLAN
 DATE: 11/15/51
 DRAWN BY: P. J. SHERMAN
 CHECKED BY: A. L. SHERMAN
 TITLE: ALIGNMENT CHANGES
 SHEET NO. 19 OF 19



PROFILE
 DATE: 11/15/51
 DRAWN BY: P. J. SHERMAN
 CHECKED BY: A. L. SHERMAN
 TITLE: ALIGNMENT CHANGES
 SHEET NO. 19 OF 19

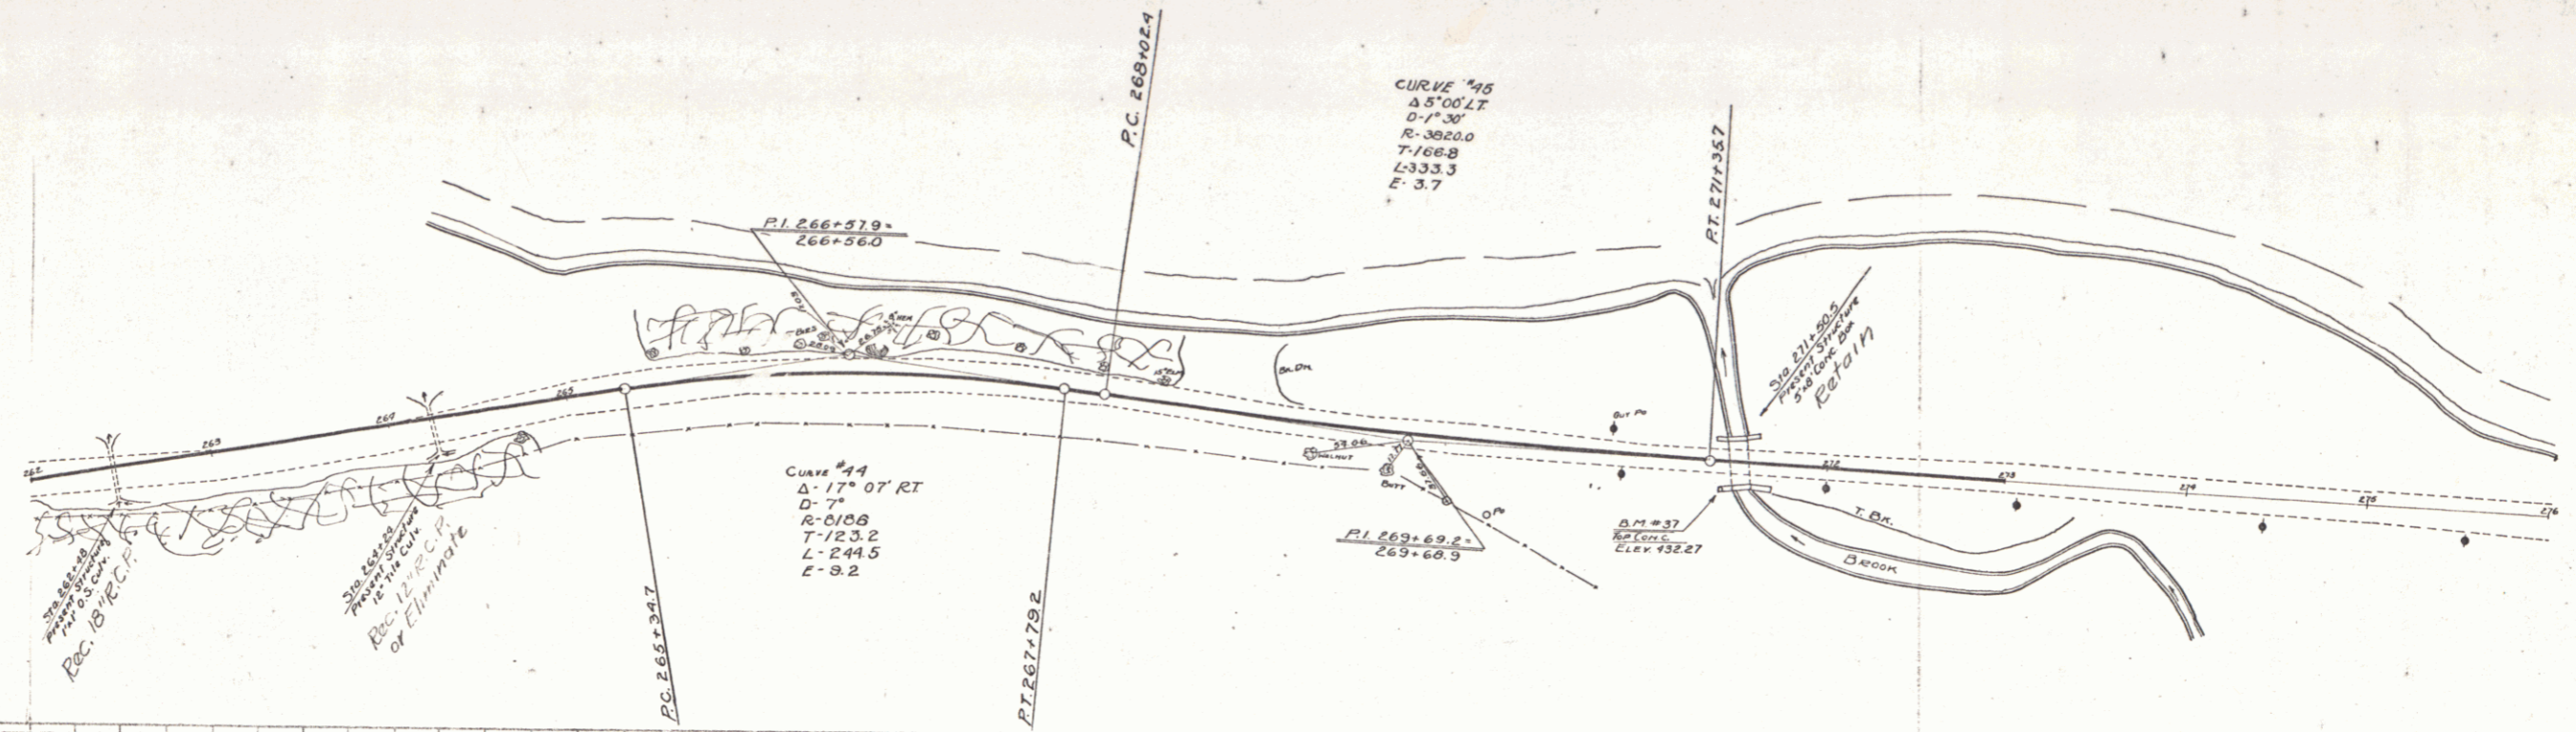