


PLAN
 DATE: 6/68
 DRAWN BY: PUTNAM
 CHECKED BY: A.L.S.
 TITLE: 16" MAP OFF. CROSS RD. 3M. LEFT STA. 351+91 ~ ELEV. 169.67

PROFILE
 DATE: 6/68
 DRAWN BY: PUTNAM
 CHECKED BY: A.L.S.
 TITLE: 16" MAP OFF. CROSS RD. 3M. LEFT STA. 351+91 ~ ELEV. 169.67

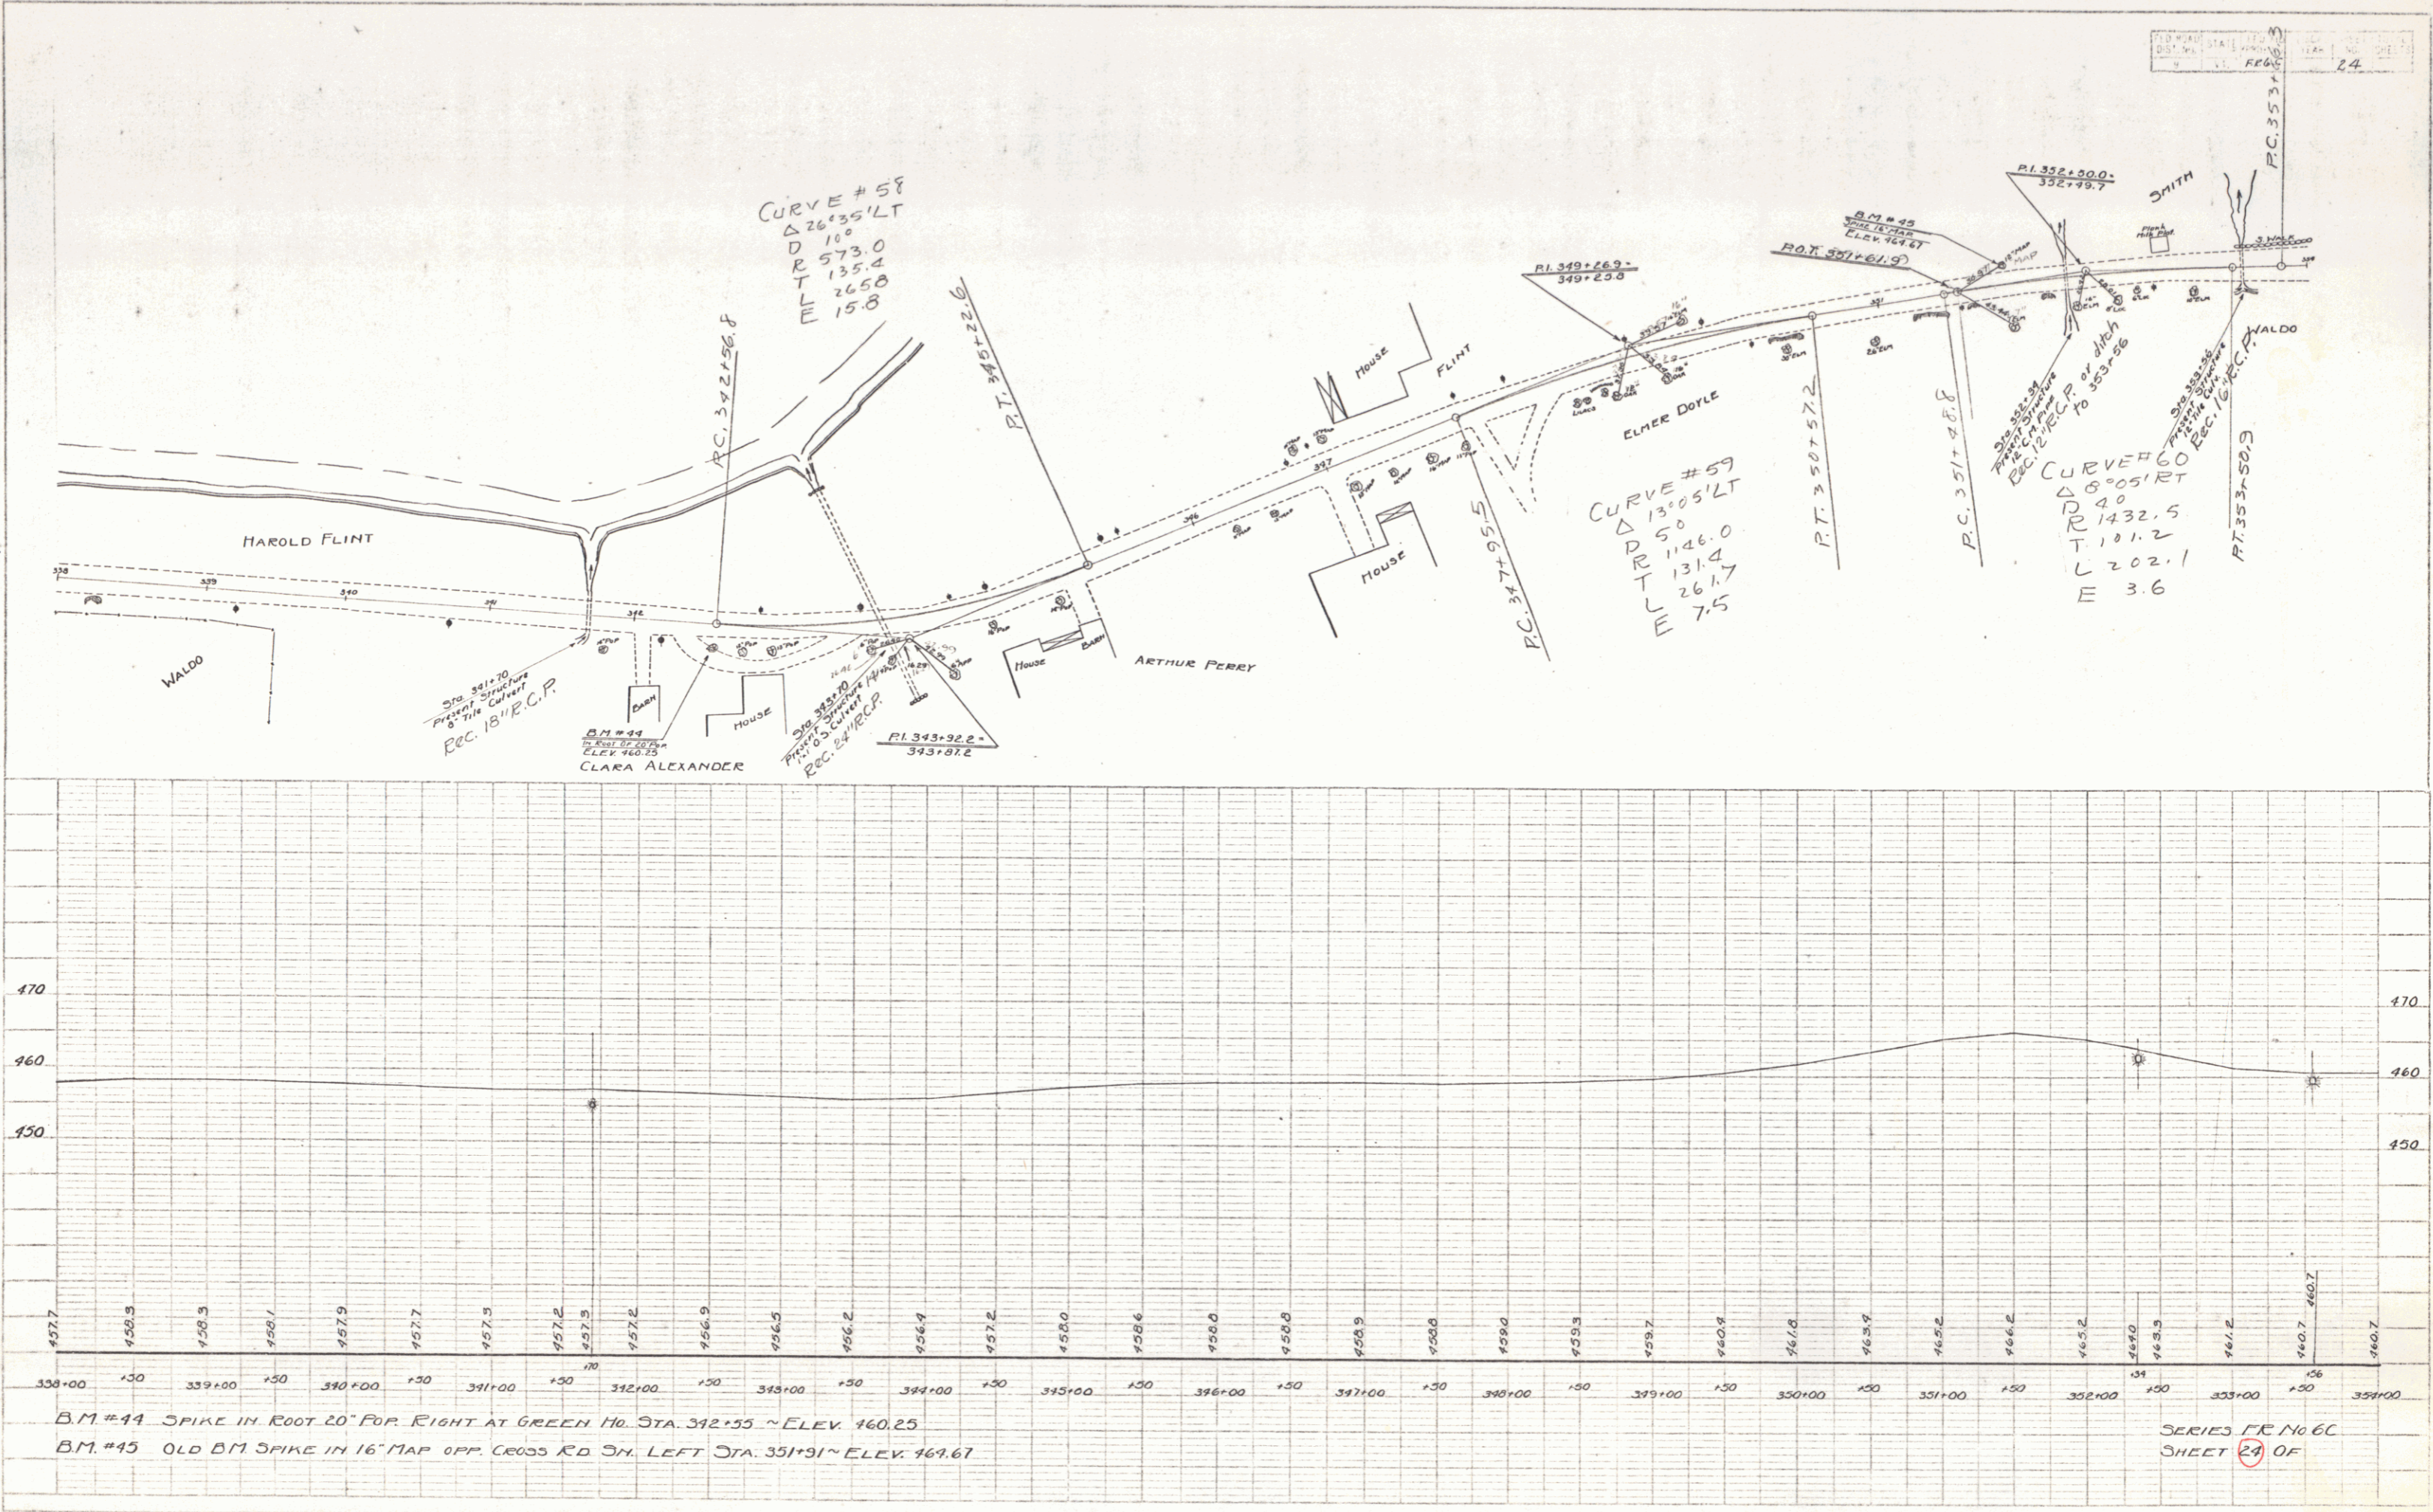

BM #44 SPIKE IN ROOT 20" FOR RIGHT AT GREEN HD. STA. 342+55 ~ ELEV. 460.25
 BM #45 OLD BM SPIKE IN 16" MAP OFF. CROSS RD. 3M. LEFT STA. 351+91 ~ ELEV. 169.67

SERIES LR No 6C
 SHEET 24 OF