

INDEX OF SHEETS

SHEET NO.	TITLE PAGE
1	TYPICAL CROSS-SECTION OF IMPROVEMENT GRADING, BASE, & DRAINAGE WITH DOUBLE TACK COAT OF REFINED TAR-ITEM 29
2	BANKING AND WIDENING TABLES
3	PLAN AND PROFILE STA.
4-6	DETAILS OF 12"x12" RC BOX
7	STANDARD STRUCTURE SHEET 52.8 PIPE CULVERTS
8	53.0 GUARD RAIL
9	53.11 LIGHTS, SIGNS, & BARRICADES
10	CROSS SECTIONS

(To Be Returned to H.O.W. Division)
 Form of 4-14
 PERPETUAL
 DOWN FILE
 RIGHT-OF-WAY DIVISION

Standard Structure Sheets
 Approved by the Chief Engineer
 5-28 - July 11, 1933
 5-30 - August 15, 1934

STATE OF VERMONT
 STATE HIGHWAY DEPARTMENT


PLAN AND PROFILE OF PROPOSED
 STATE HIGHWAY
 PROJECT E.R.3

TOWN OF SHARON Pin# COR 735

ROYALTON-WHITE RIVER JCT. ROAD
 BEGINNING AT A POINT 617 FT. SOUTHEASTERLY
 FROM THE INTERSECTION WITH THE STRAFFORD
 ROAD AND EXTENDING SOUTHEASTERLY 200 FT.

LENGTH OF PROJECT = 200.0 FT. = 0.037 MI.


FED. ROAD DIST. NO.	STATE	PROJ. NO.	FISCAL YEAR	SHEET NO.	TOTAL SHEETS
9	VT.	3	1939	1	13

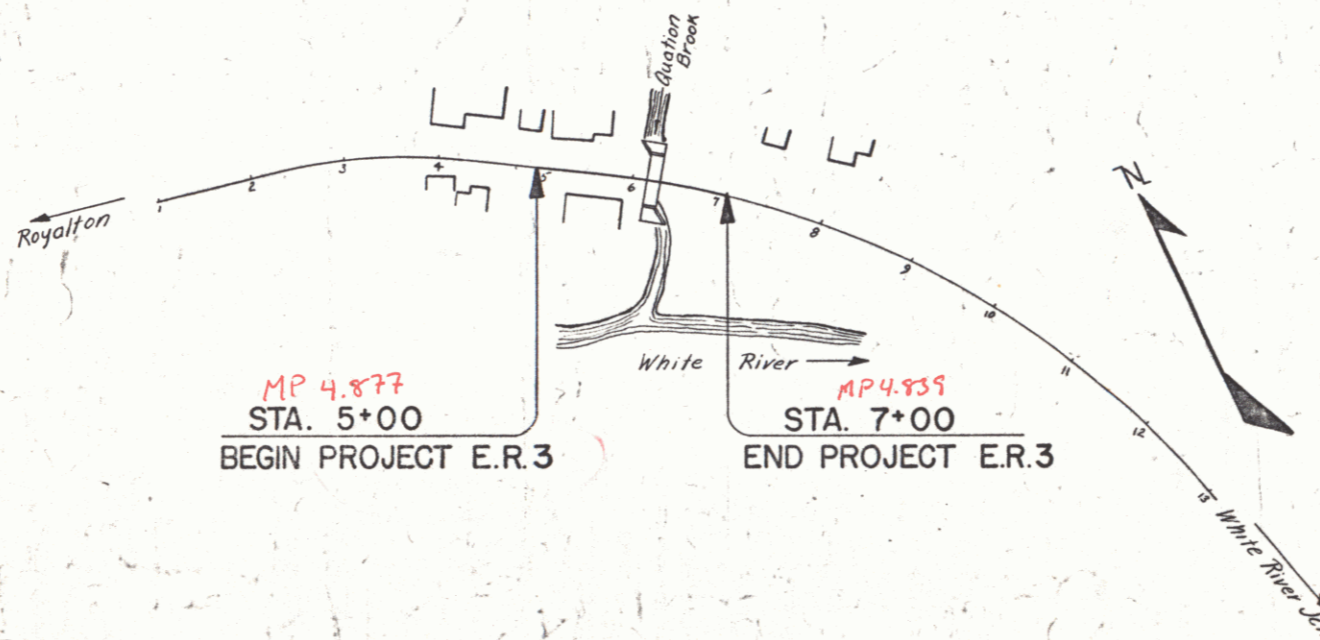

RE-VT 14
 APPROVED: Nov. 21, 1935
 Commissioner of Highways
 SUBMITTED BY ORDER OF THE STATE HIGHWAY BOARD

MM0485

These plans are subject to such revisions as may be required by the Bureau of Public Roads or the Commissioner of Highways. Construction is to be carried on in accordance with the plans and Standard Road and Bridge Specifications of 1936 as approved December 29, 1936 by the Bureau of Public Roads including all subsequent approved revisions and such revised specifications and special provisions as are submitted with the plans.

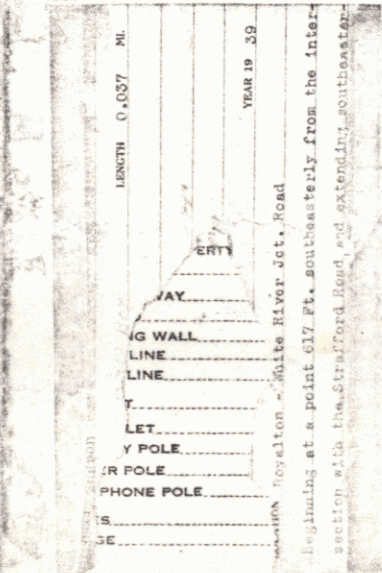

CONVENTIONAL SIGNS

GROUND ELEVATION	DATUM	LINE
GRADE ELEVATION	DATUM	LINE

CURVE DATA

DEFLECTION ANGLE	Δ
DEGREE OF CURVE	D
RADIUS OF CURVE	R
TANGENT DISTANCE	T
LENGTH OF CURVE	L
EXTERNAL DISTANCE	E
POINT OF INTERSECTION	P. I.
POINT OF CURVE	P. C.
POINT OF TANGENT	P. T.
POINT ON TANGENT	P. O. T.

Scales

Title	1"=100'
Typical	1"=2'
Plan	1"=20'
Profile	1"=10'
Cross-Sections	1"=5'

APPROVED: [Signature]
 DISTRICT HIGHWAY COMMISSIONER

CORRECT: [Signature]
 BRIDGE ENGINEER

SERIES E.R. NO. 3 FILED
 SHEET 1 OF 13

DIST. # 4 PLANS