



PLAN  
 NOTE BOOK  
 DATE

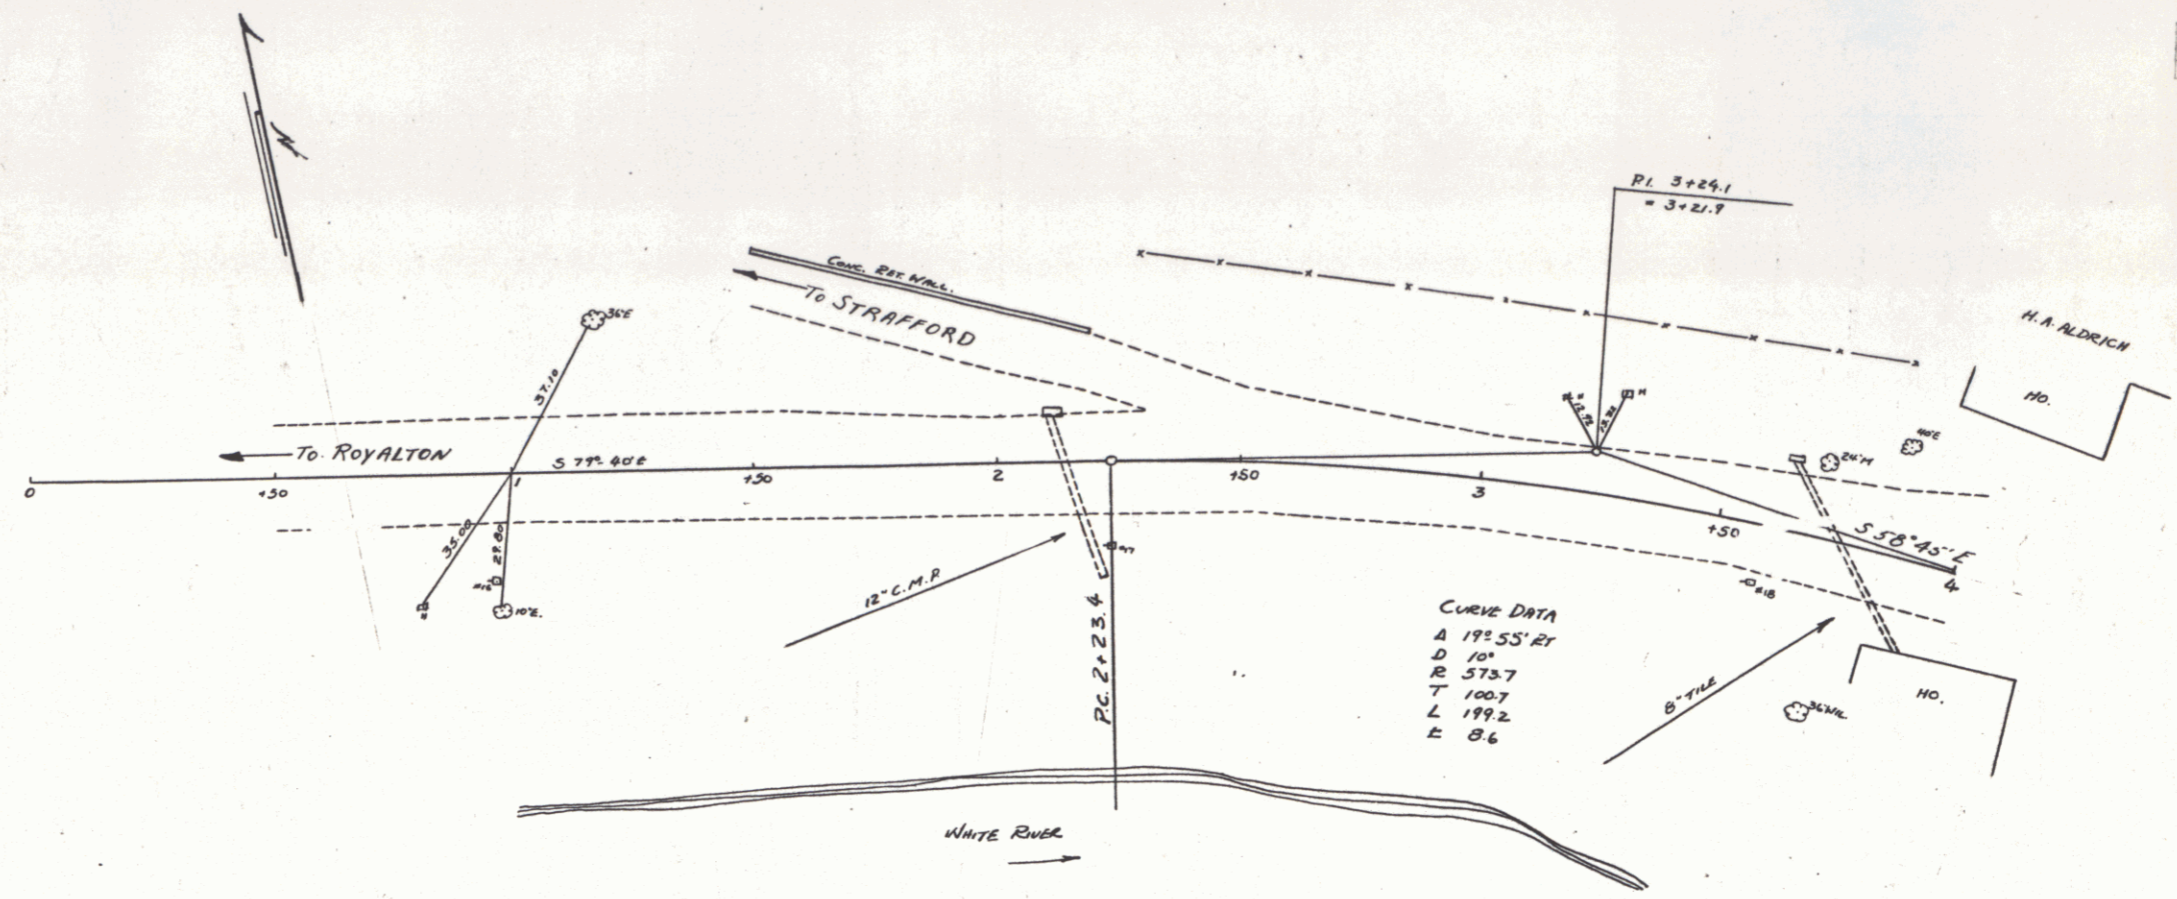

CURVE DATA  
 Δ 191.55° RT  
 D 101'  
 R 573.7  
 T 100.7  
 L 199.2  
 E 8.6

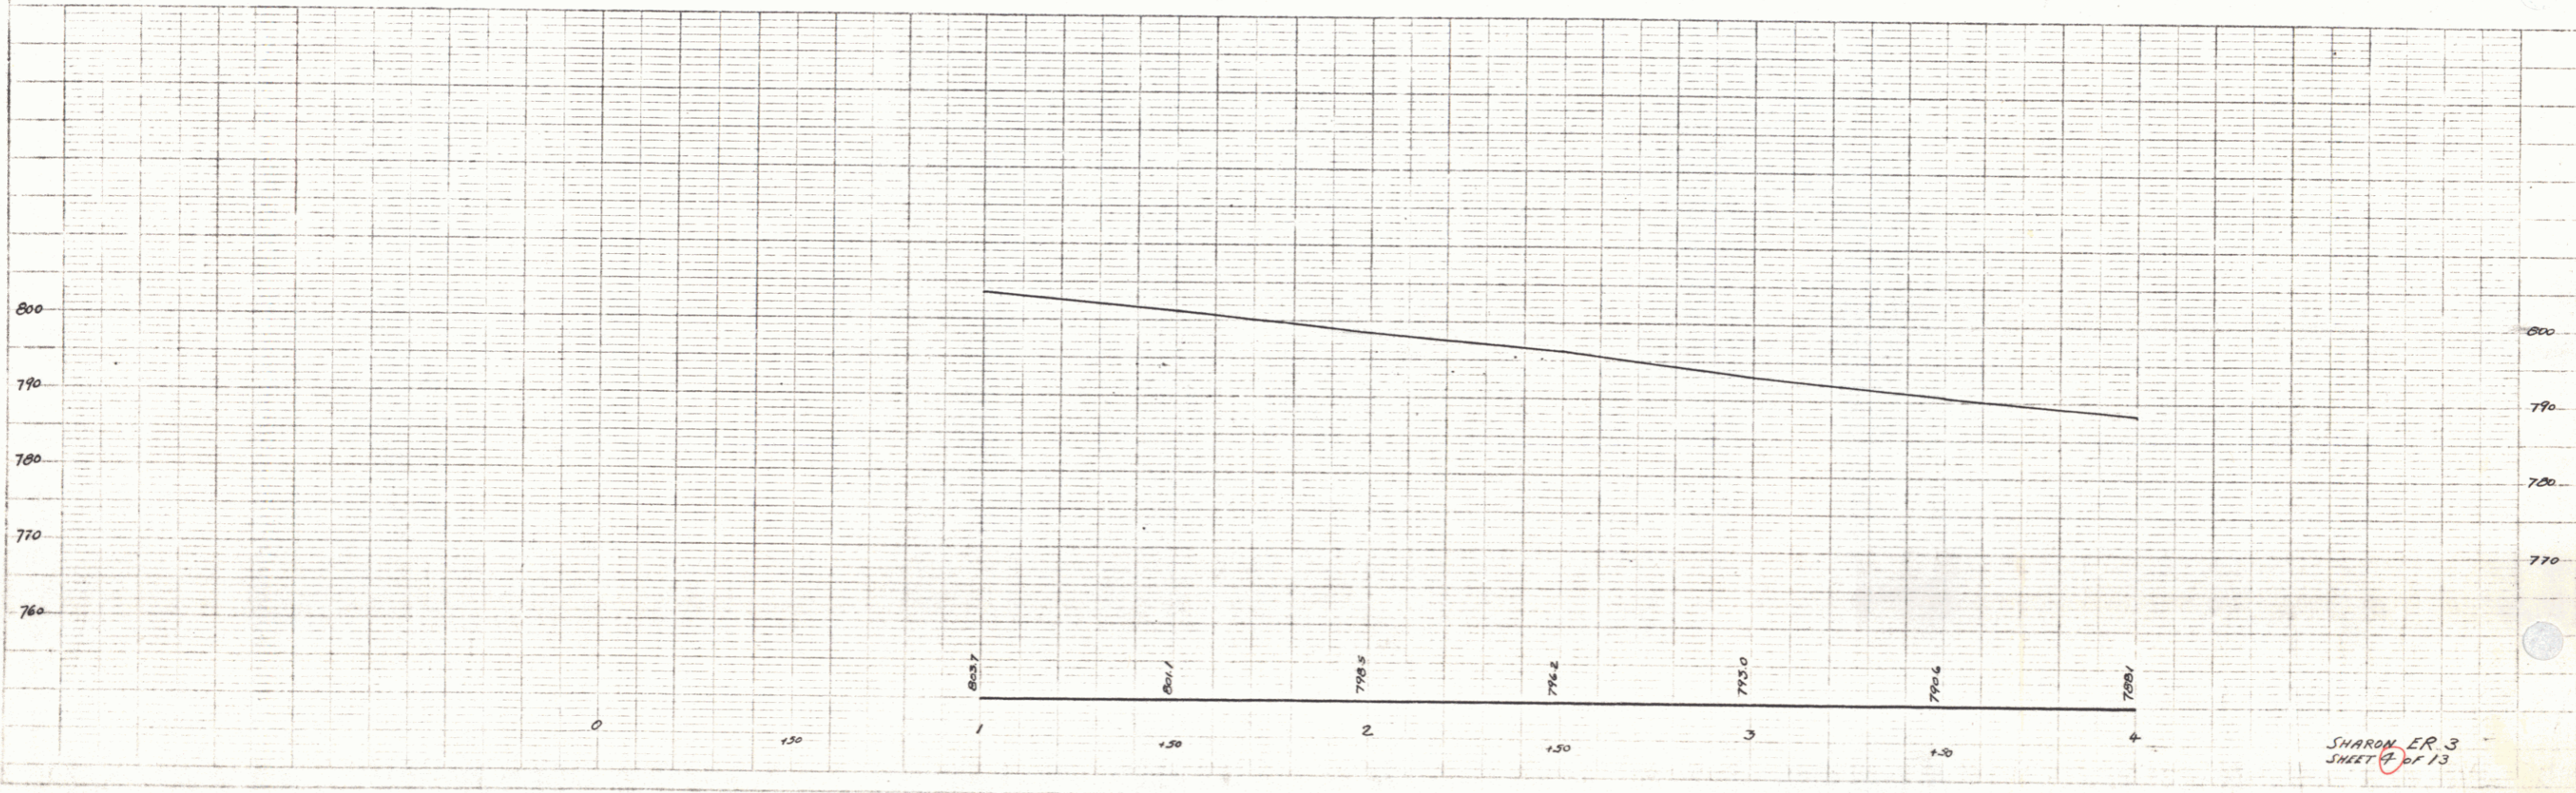

SHARON ER 3  
 SHEET 13