
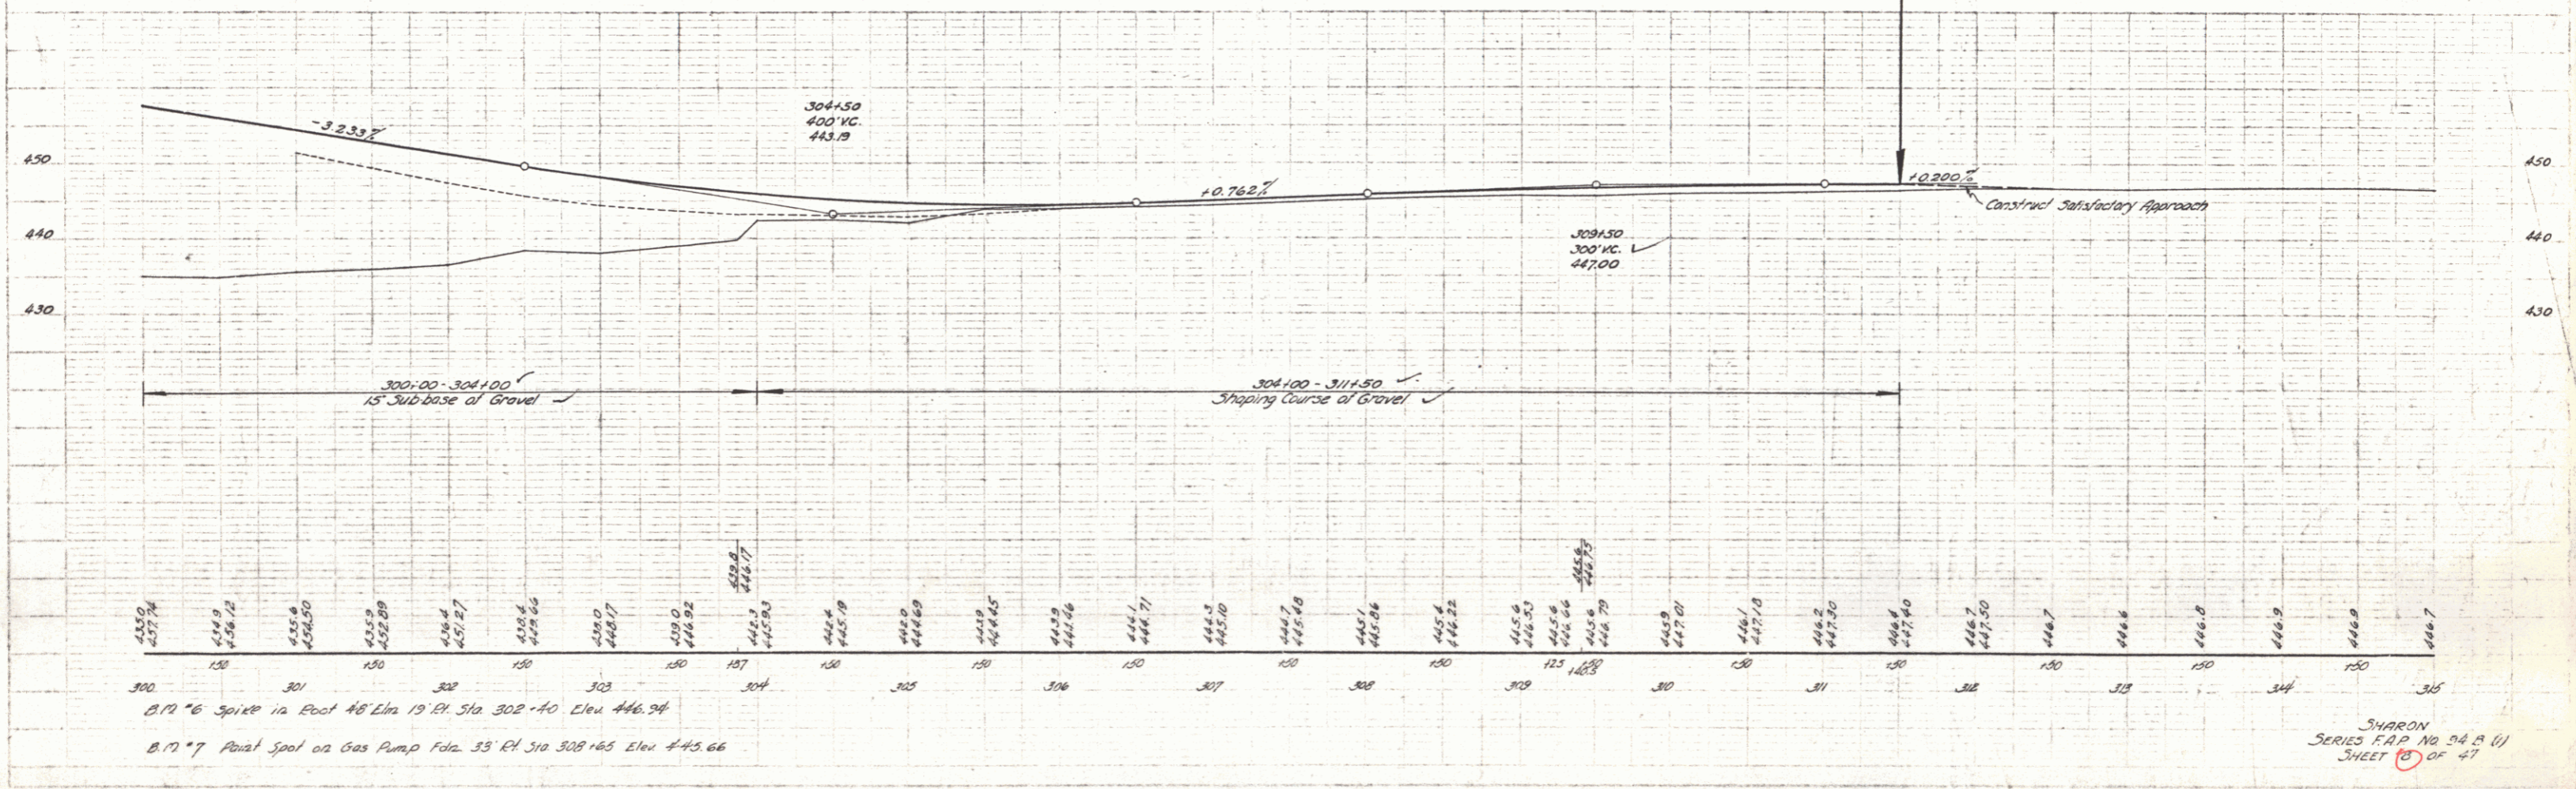


PARCEL INTRUMENT DATE GRANTOR GRANTEE RECORDED REMARKS
 A W.D.06 10-2-40 G.A. WILKINSON ST OF VT SHARON
 23 233 107-40

FED. ROAD DIST. NO. STATE VT PROJ. NO. 94 B (1) FISCAL YEAR 1941 SHEET 5 OF 47

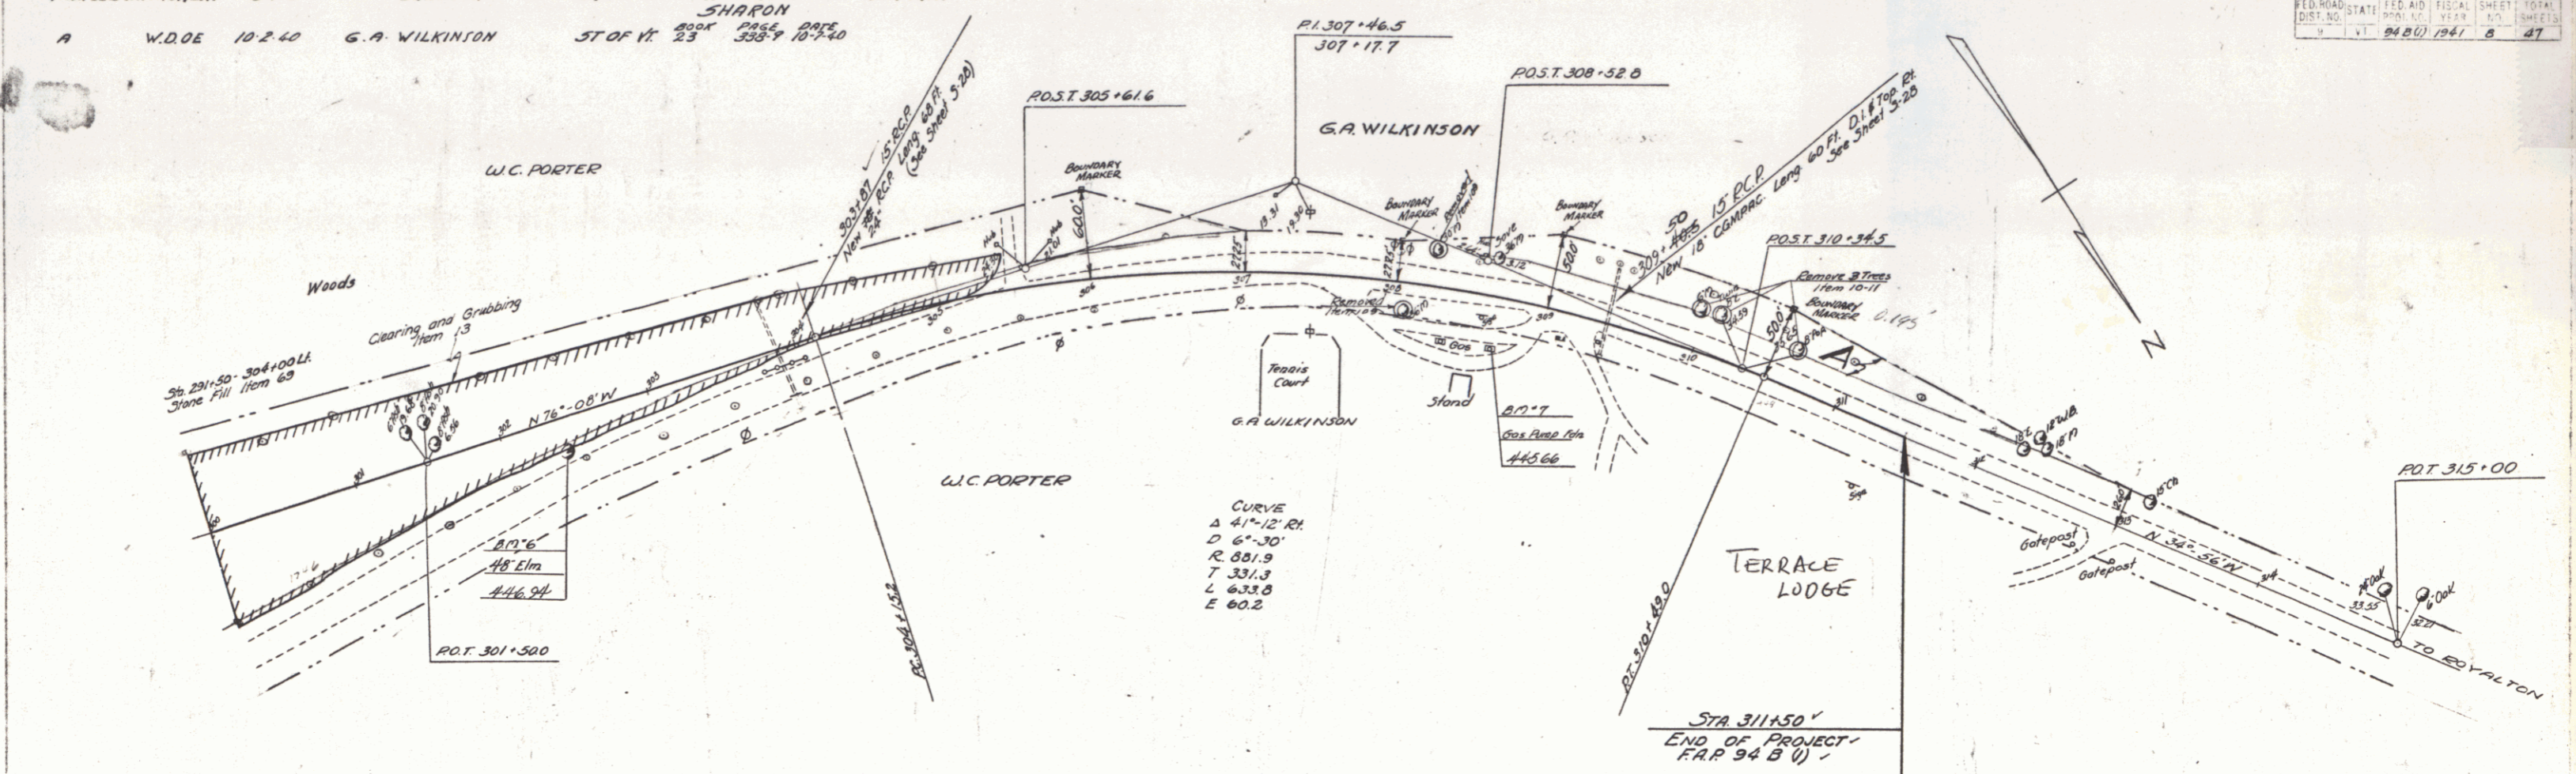

8.17' x 6' Spike in Post 48' Elm 19' RH Sta 302+40 Elev 446.94
 8.17' x 7' Post Spool on Gas Pump Fdn. 33' RH Sta 308+45 Elev 445.66

SHARON
 SERIES F.A.P. NO. 54 B (1)
 SHEET 5 OF 47

6