


PLAN  
 DATE: 11-30-40  
 DRAWN BY: [Signature]  
 CHECKED BY: [Signature]

PROFILE  
 DATE: 11-30-40  
 DRAWN BY: [Signature]  
 CHECKED BY: [Signature]

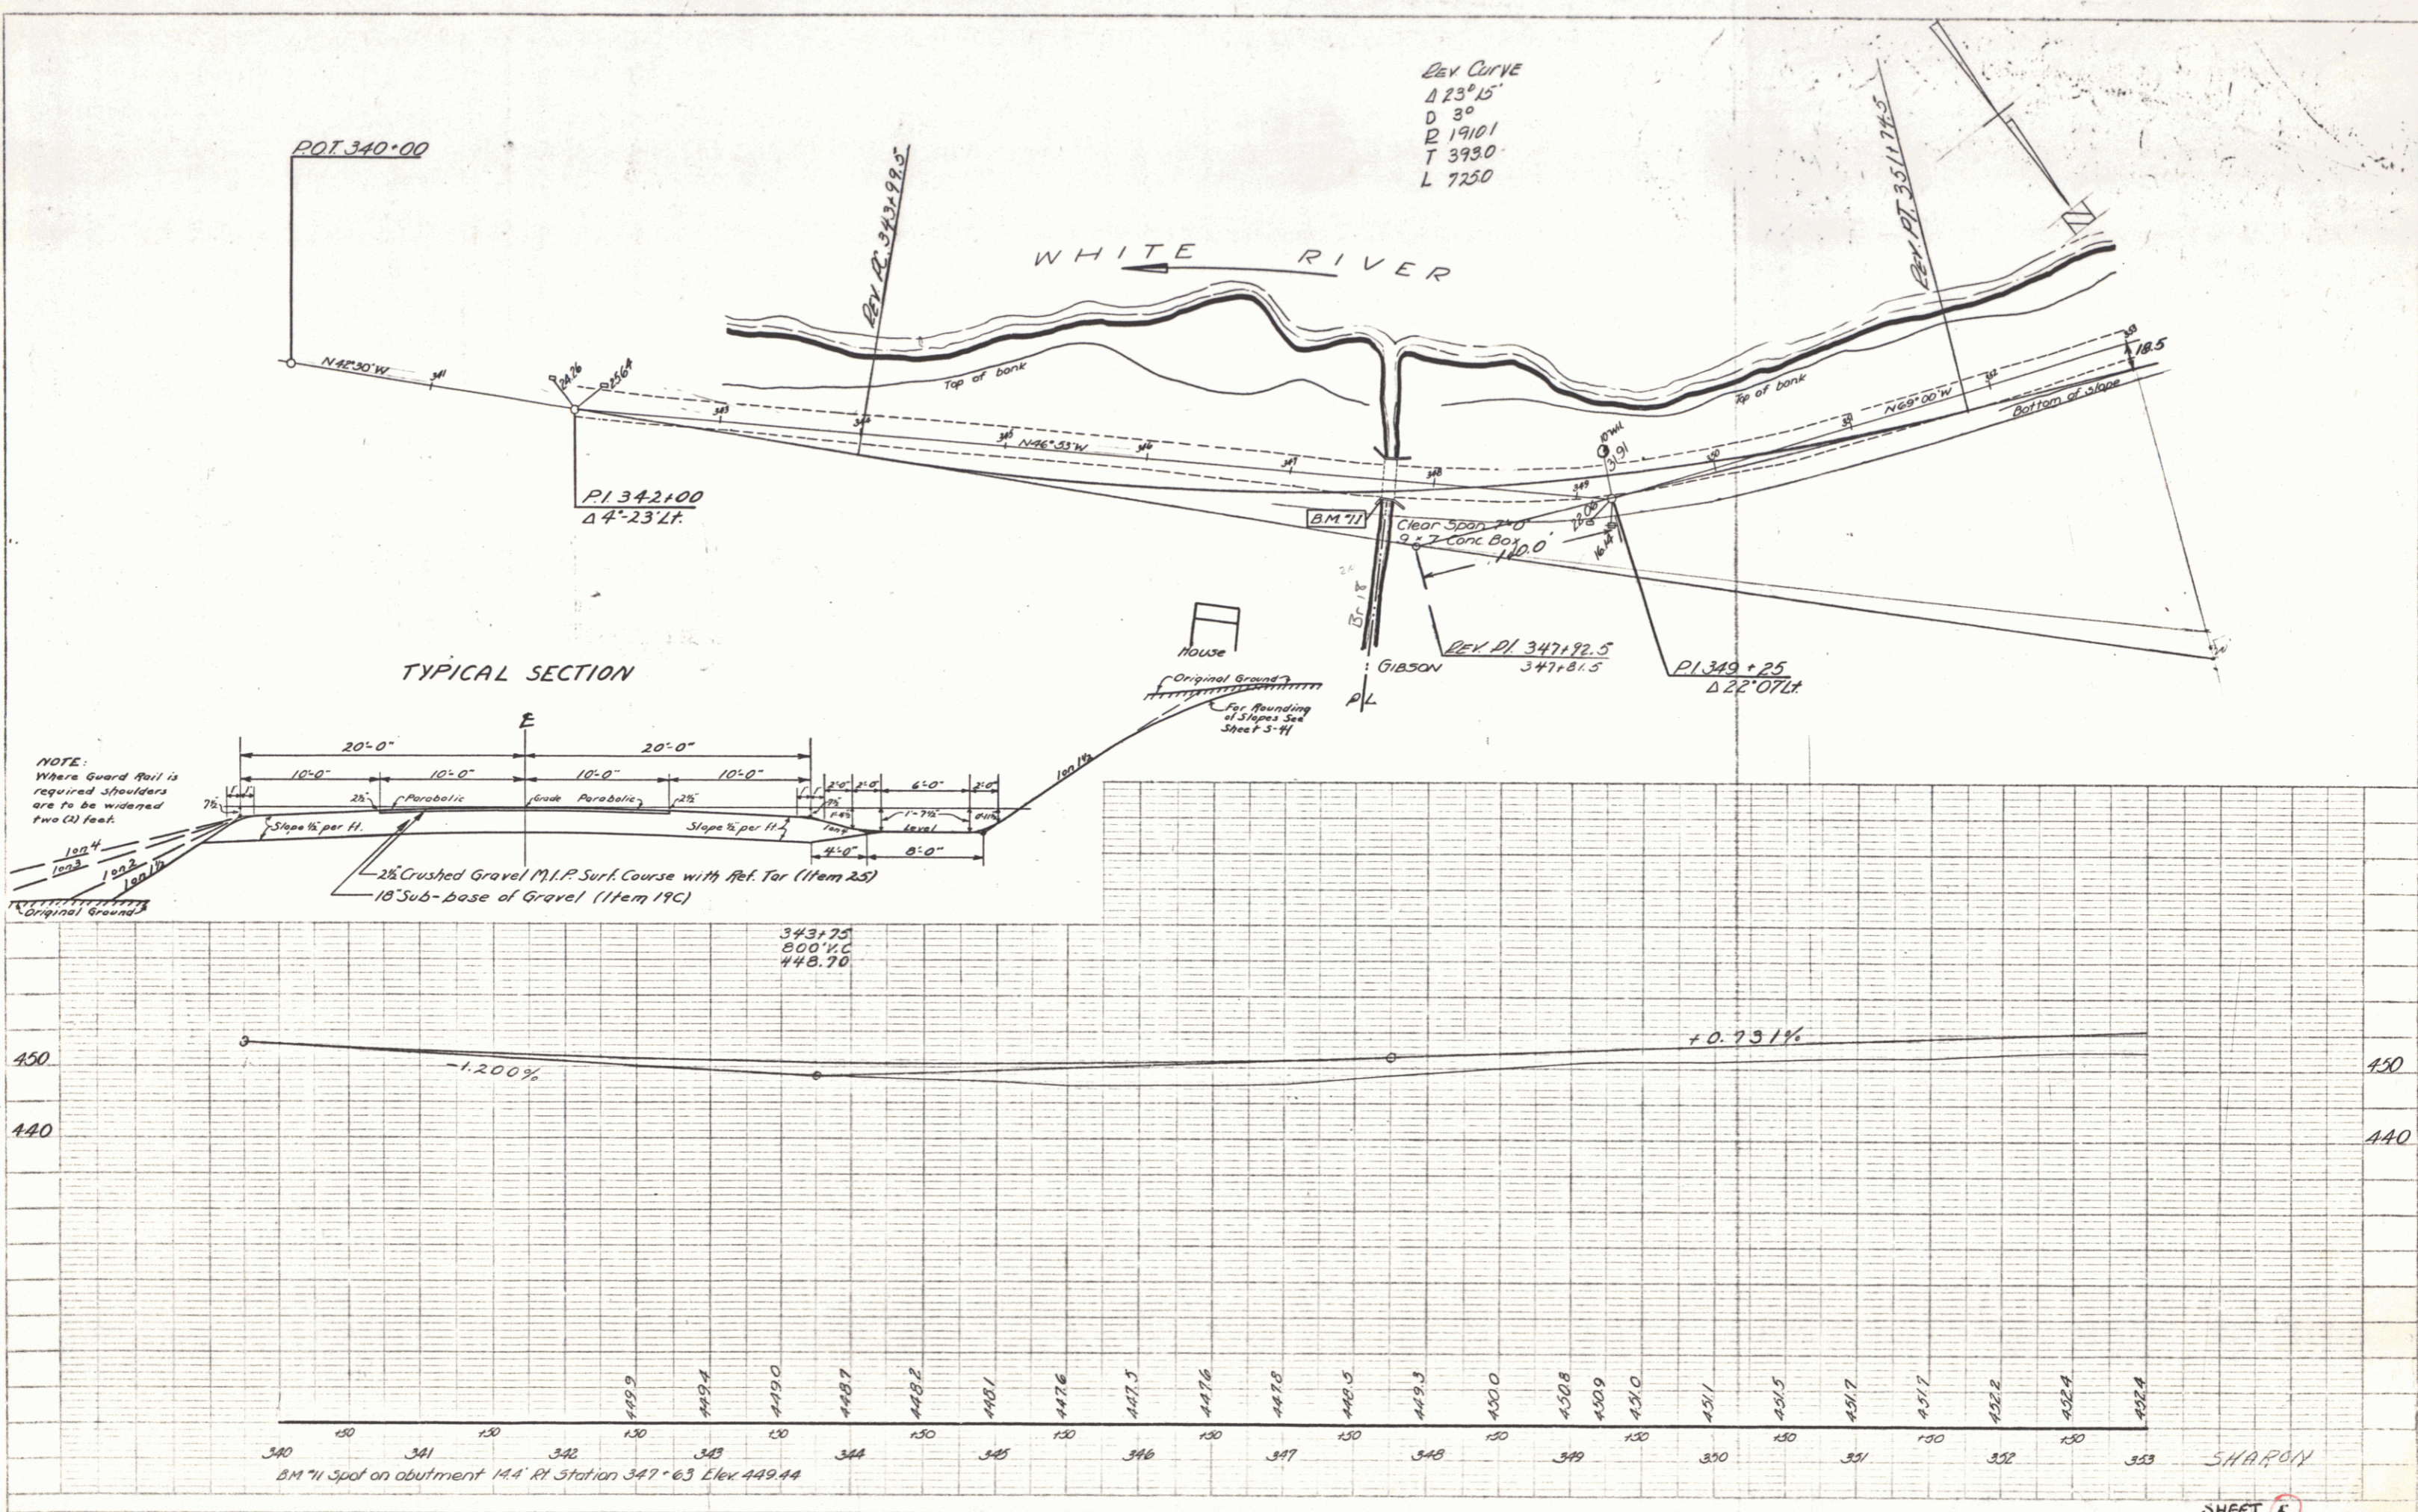

SHEET 5

2