

PLAN  
 DATE 11-20  
 BY B. W. B. / J. R. S.  
 CHECKED BY J. R. S.  
 SCALE 1" = 40'

PROFILE  
 DATE 11-20  
 BY B. W. B. / J. R. S.  
 CHECKED BY J. R. S.  
 SCALE 1" = 10'

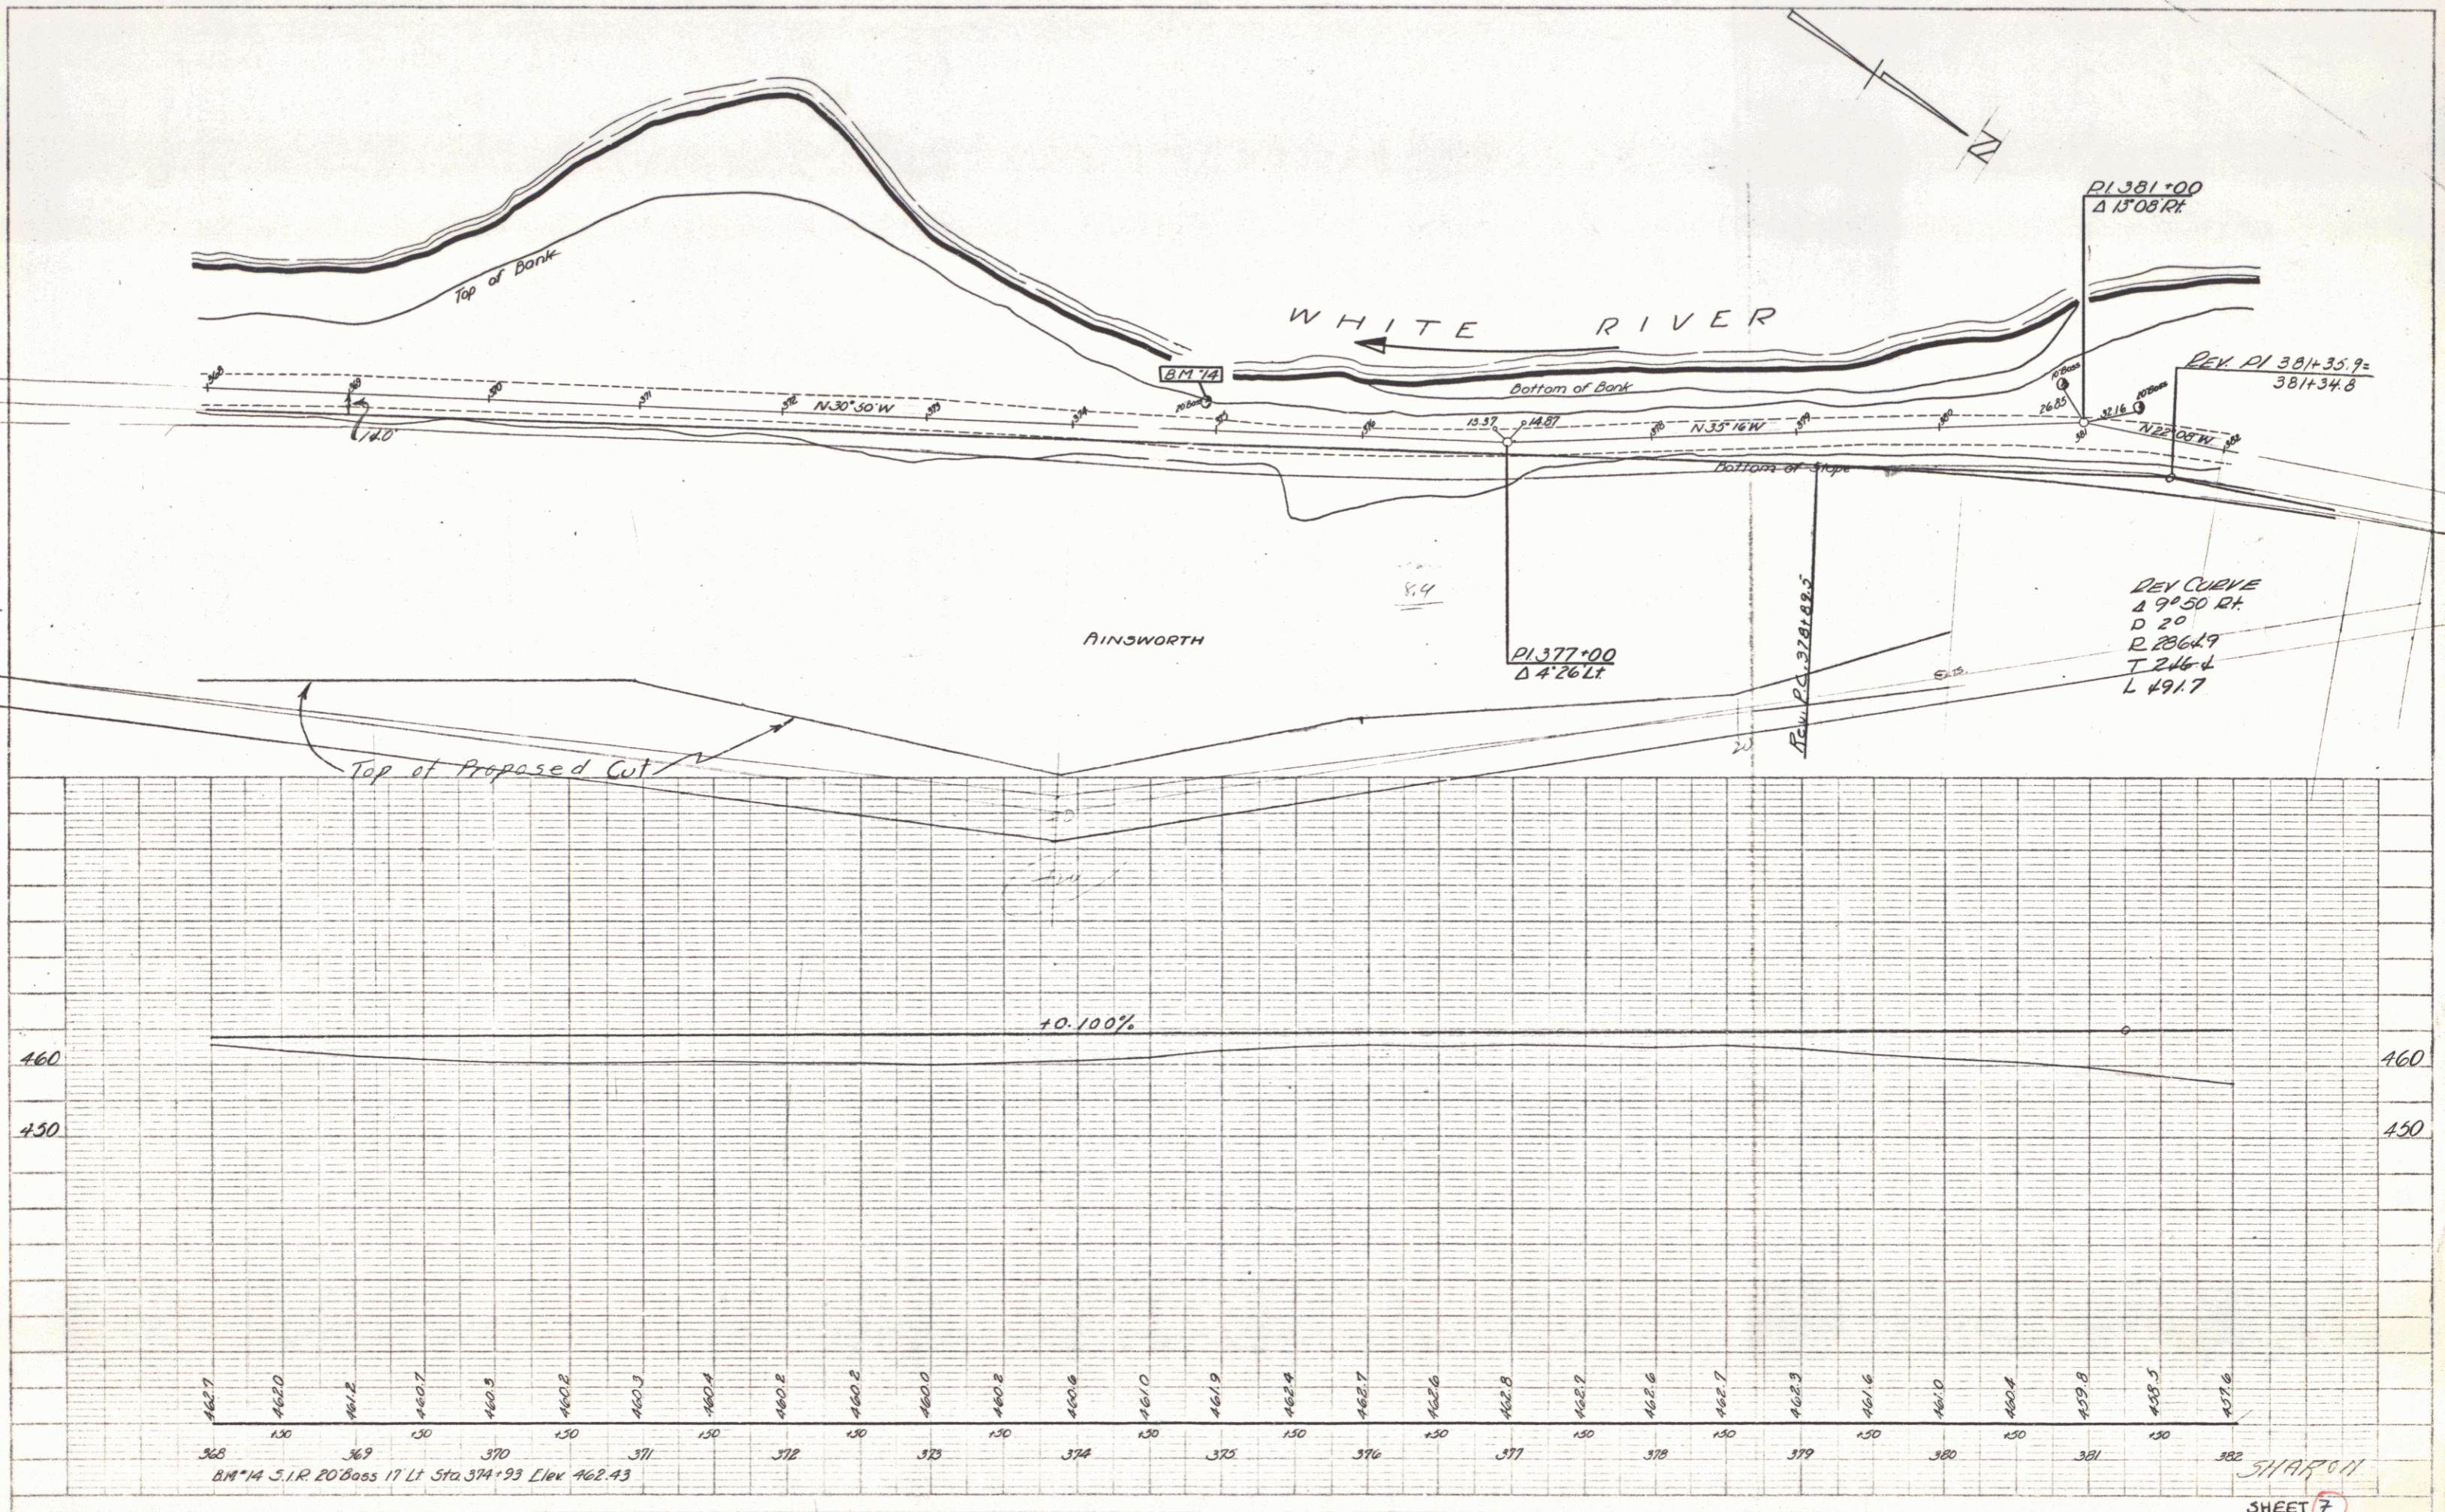


PLATE 1 - PLAN & PROFILE  
 METERS & FEET ON NATIONAL  
 P.A.T. CO. THE DESIGN

SHARON  
 SHEET 7

4