
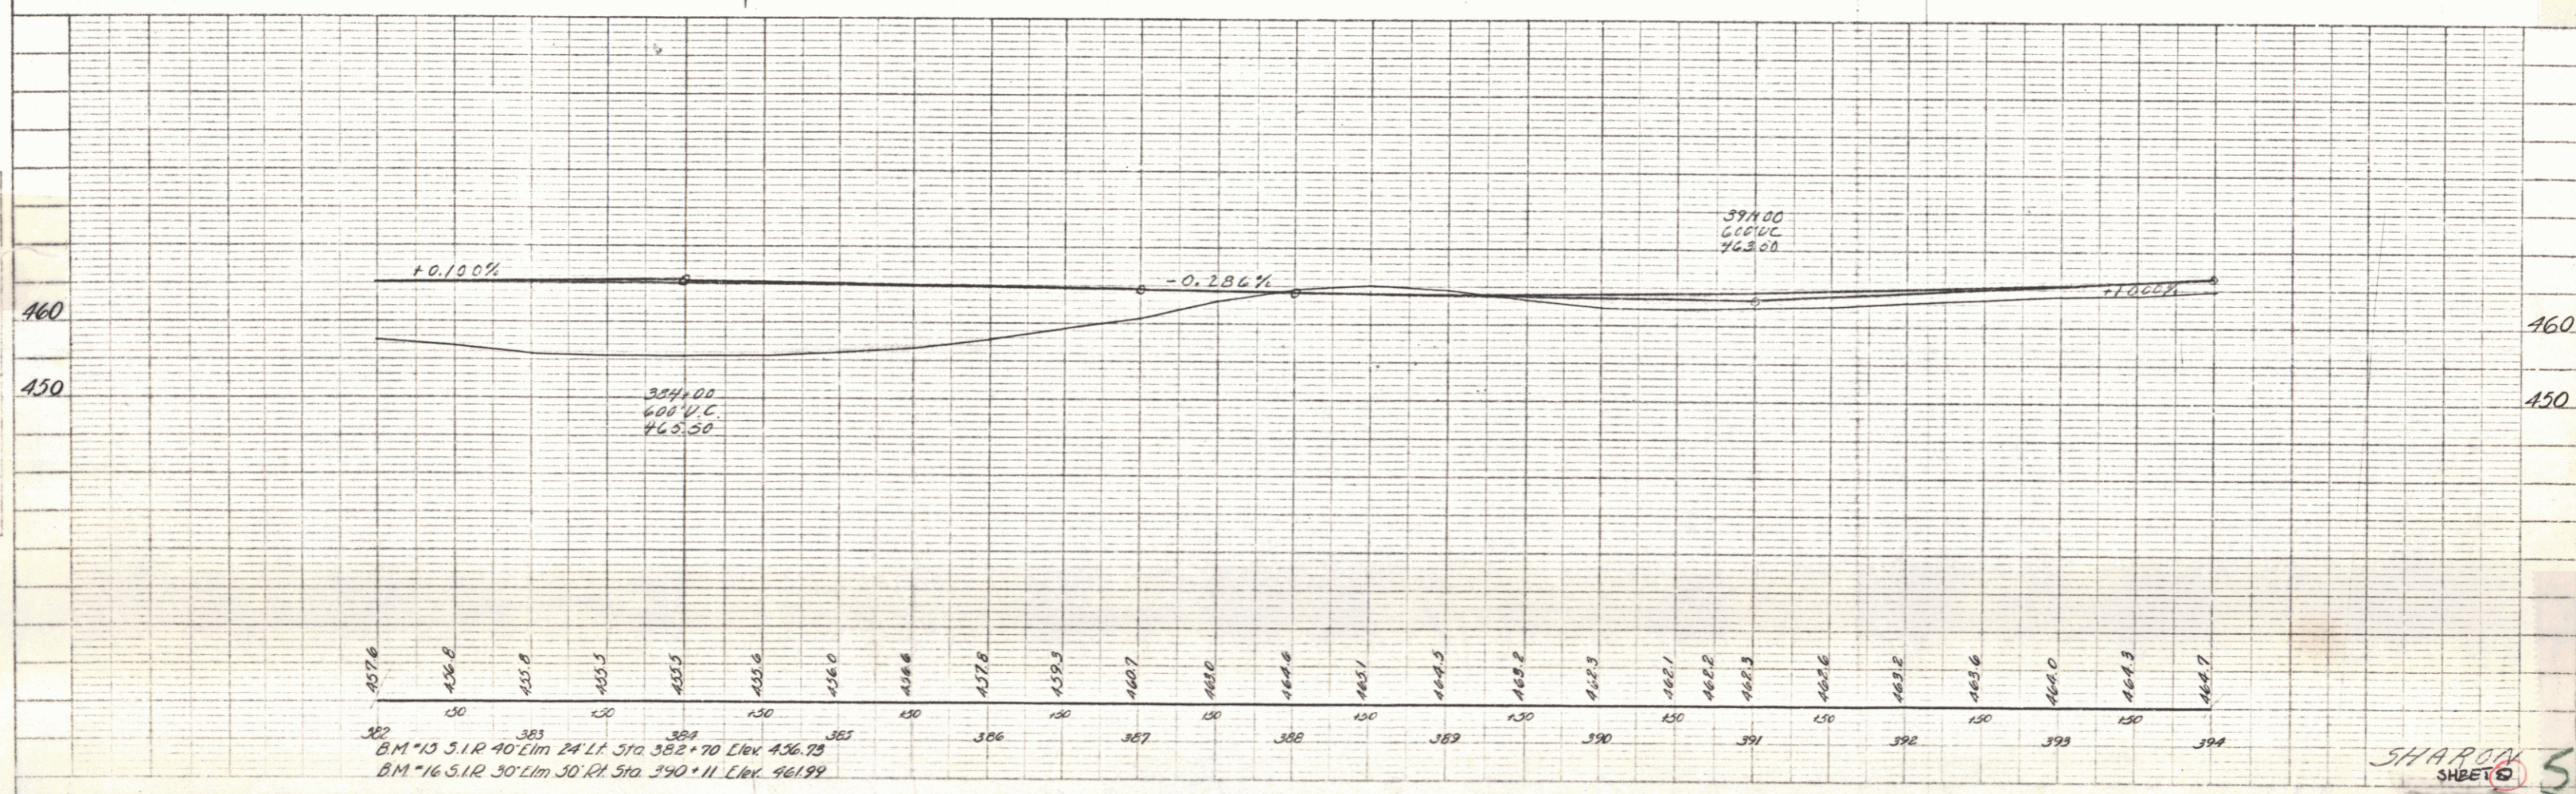


PLAN
 SHEET NO. 11.40
 DATE BOOK 11.40
 CHECKED BY [Signature]
 DRAWN BY [Signature]
 PROJECT [Signature]

PLAN
 SHEET NO. 11.40
 DATE BOOK 11.40
 CHECKED BY [Signature]
 DRAWN BY [Signature]
 PROJECT [Signature]

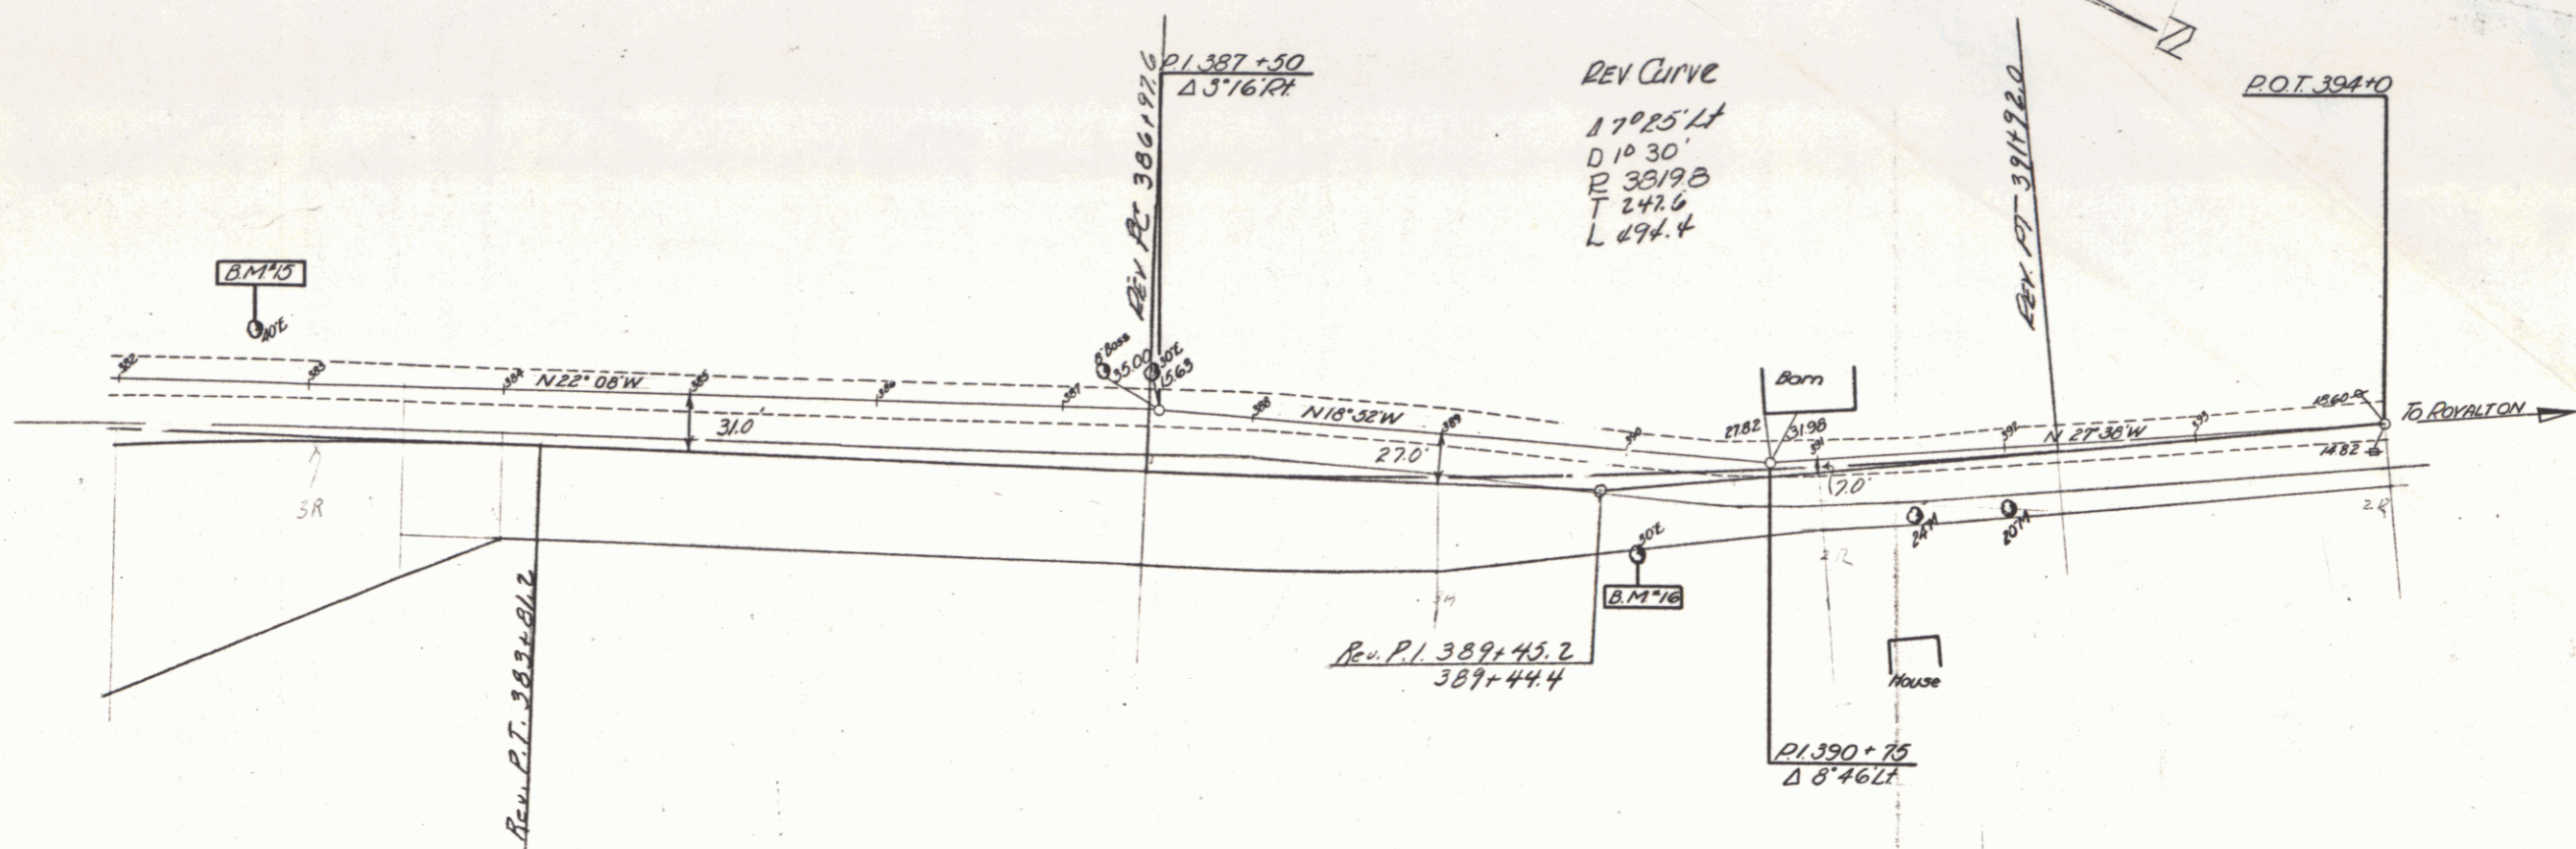

382 B.M. *13 S.I.R. 40' Lim 24' Lt Sta 382+70 Elev 456.78
 383 B.M. *16 S.I.R. 30' Lim 30' Rt Sta 390+11 Elev 461.99

SHARON SHEETS 5