


SPaulding
EXC.
PLAN
DATE
BY
SCALE


SPaulding
EXC.
PROFILE
DATE
BY
SCALE

ALL POLES BELONG TO NET. CO.
NUMBERS REFER TO THEIR PROPERTY NUMBERS

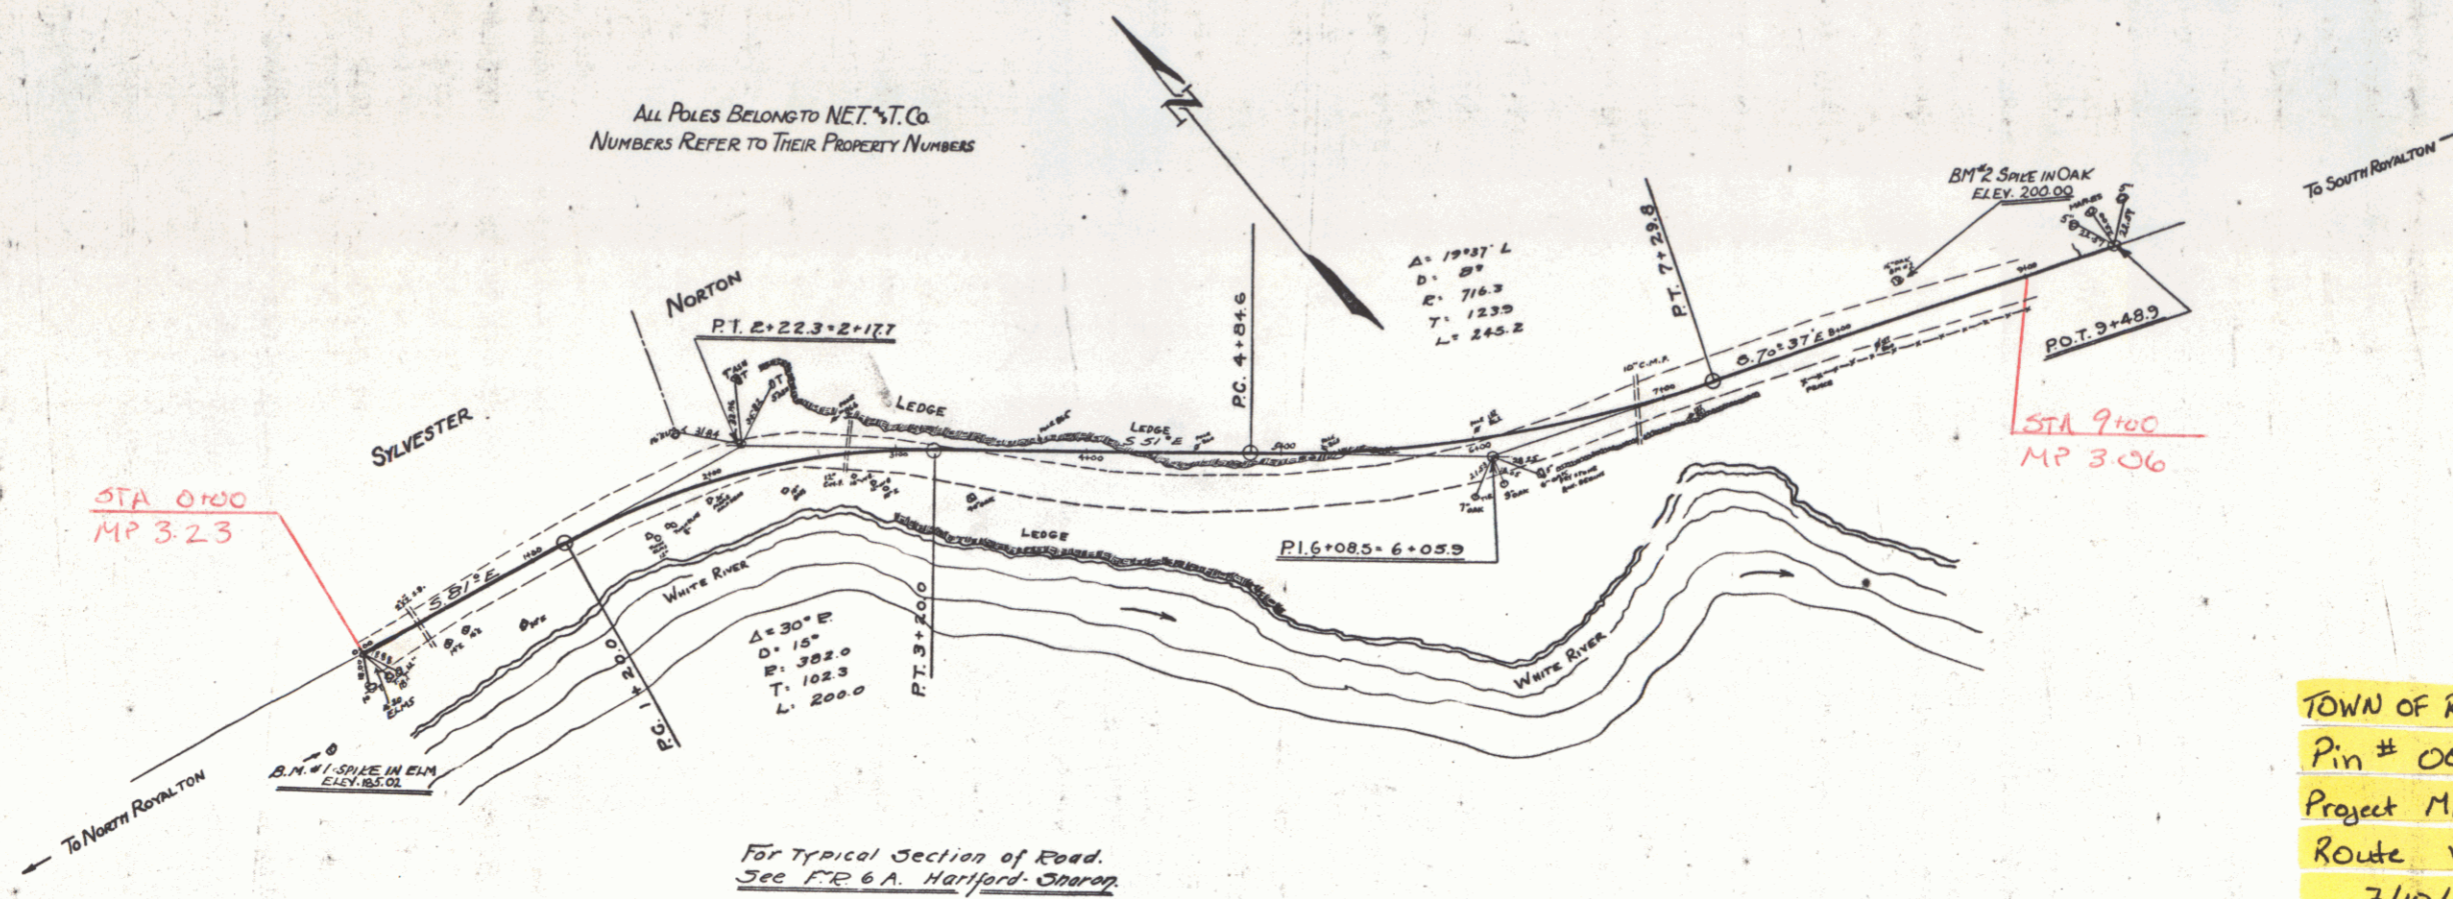

For Typical Section of Road.
See FR 6 A. Hartford. Conn.

TOWN OF ROYALTON
Pin # 00R743
Project MM 0315
Route VT 14
7/10/1929

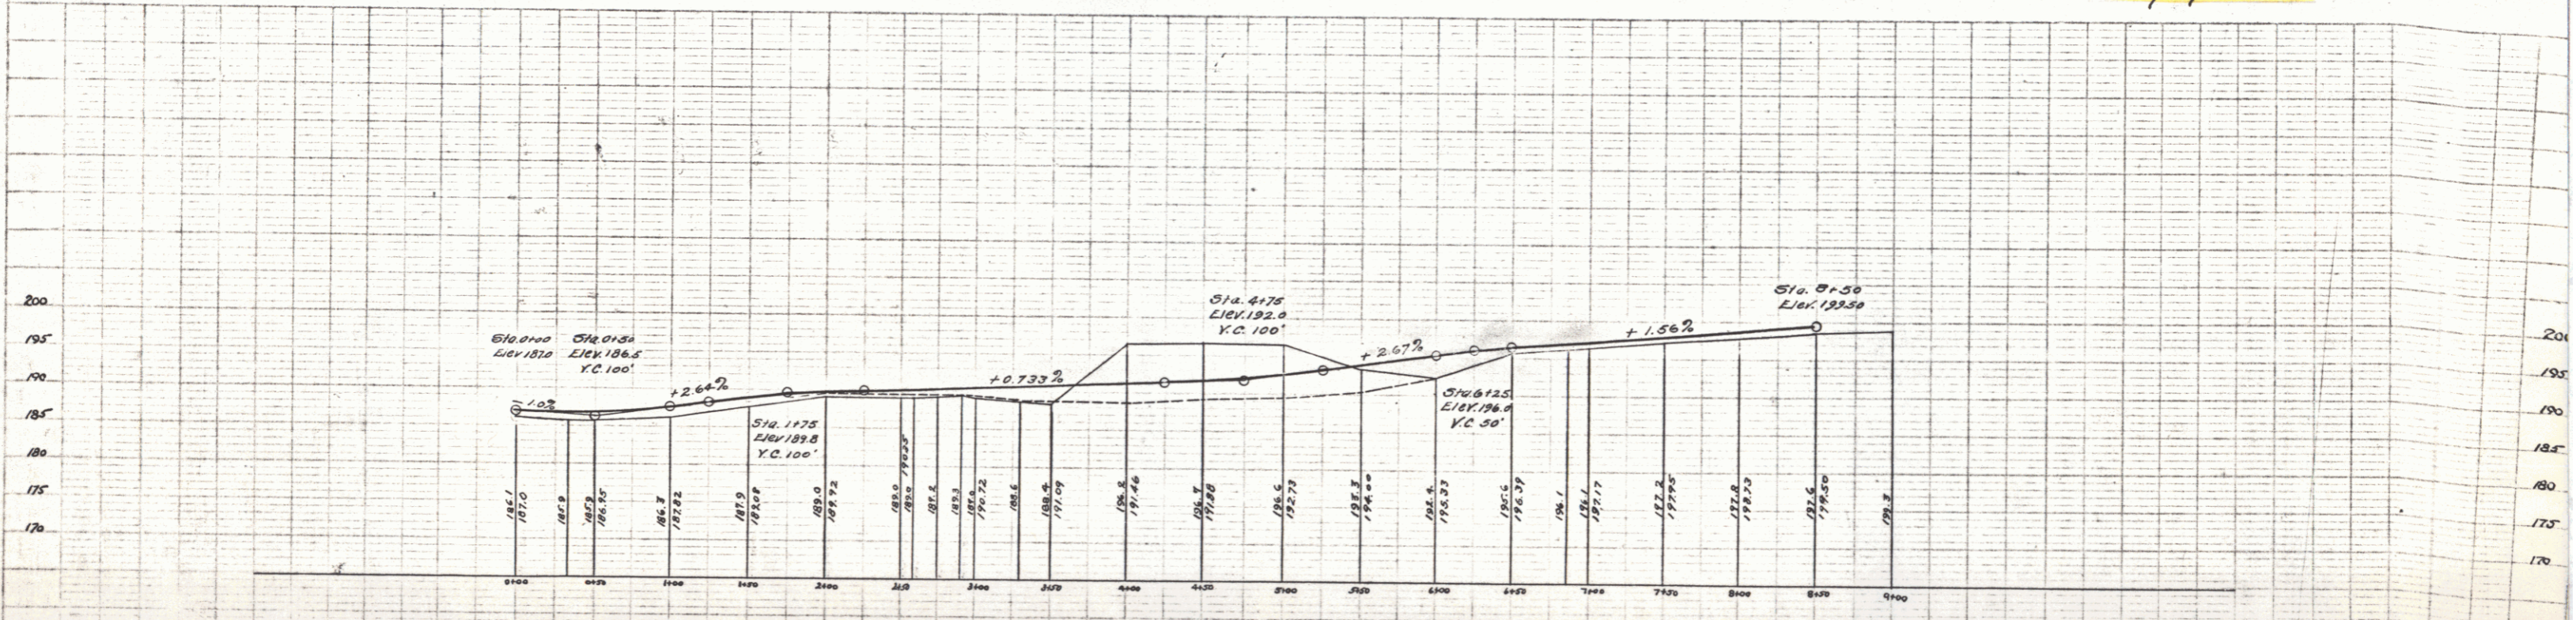

BM#1 SPIKE IN ROOT ELM ET, ELEV. 185.02
BM#2 SPIKE IN ROOT OAK U, ELEV. 200.00

TOWN OF ROYALTON
Route 14

SHEET 1

2