


SPaulding
EXC.


SPaulding
EXC.

ALL POLES BELONG TO NET. CO.
NUMBERS REFER TO THEIR PROPERTY NUMBERS

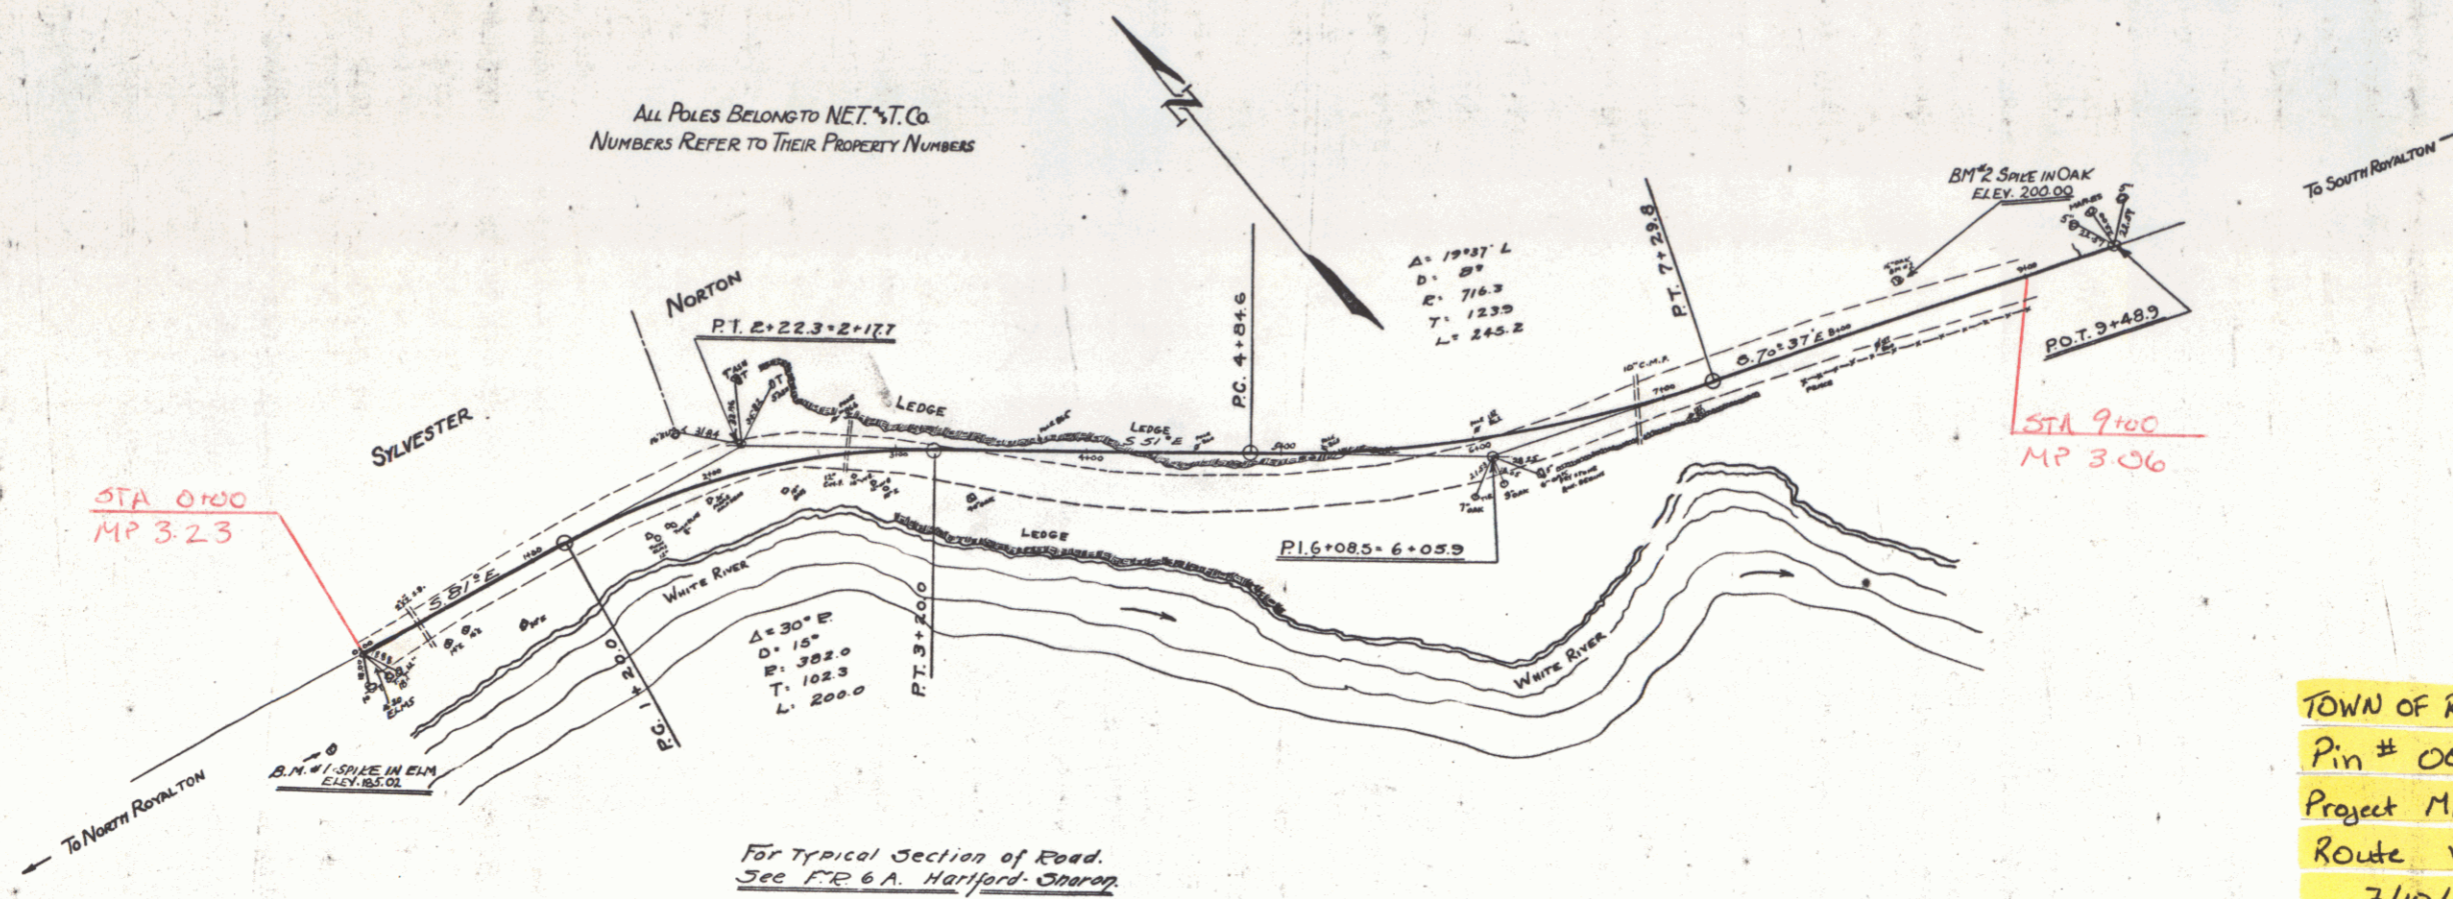

TOWN OF ROYALTON
Pin # 00R743
Project MM 0315
Route VT14
7/10/1929

For Typical Section of Road.
See FR 6 A. Hartford. Conn.

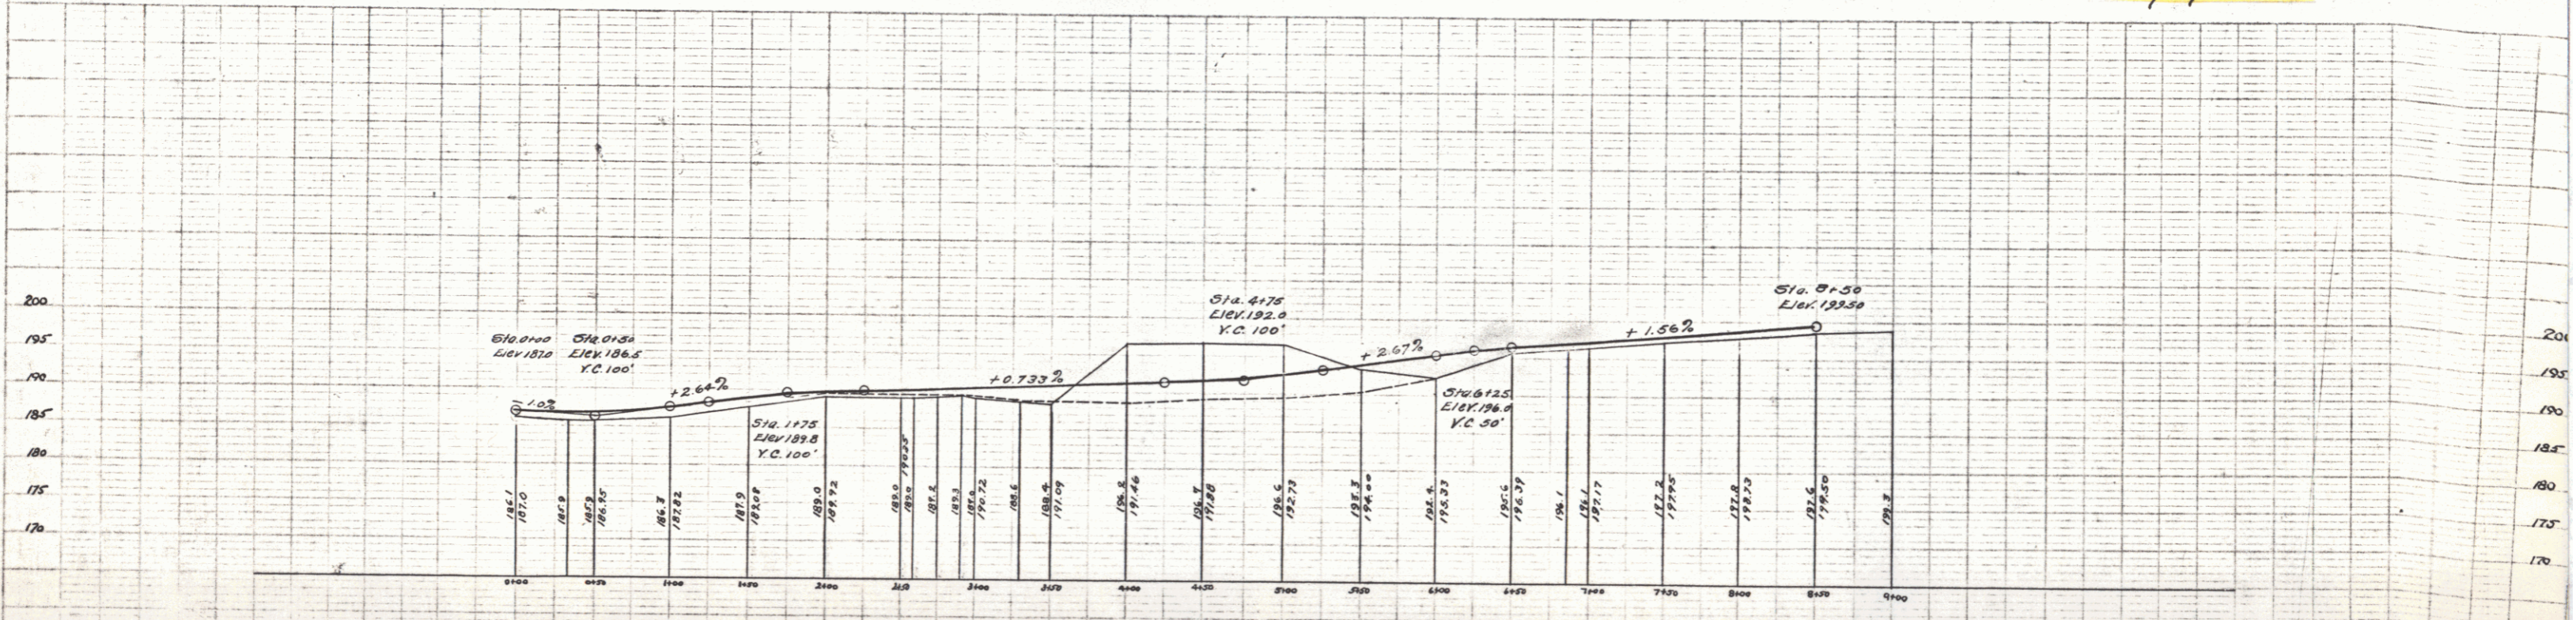

BM#1 SPIKE IN ROOT ELM ET, ELEV. 185.02
BM#2 SPIKE IN ROOT OAK ET, ELEV. 200.00

TOWN OF ROYALTON
Route 14

SHEET 1

2