
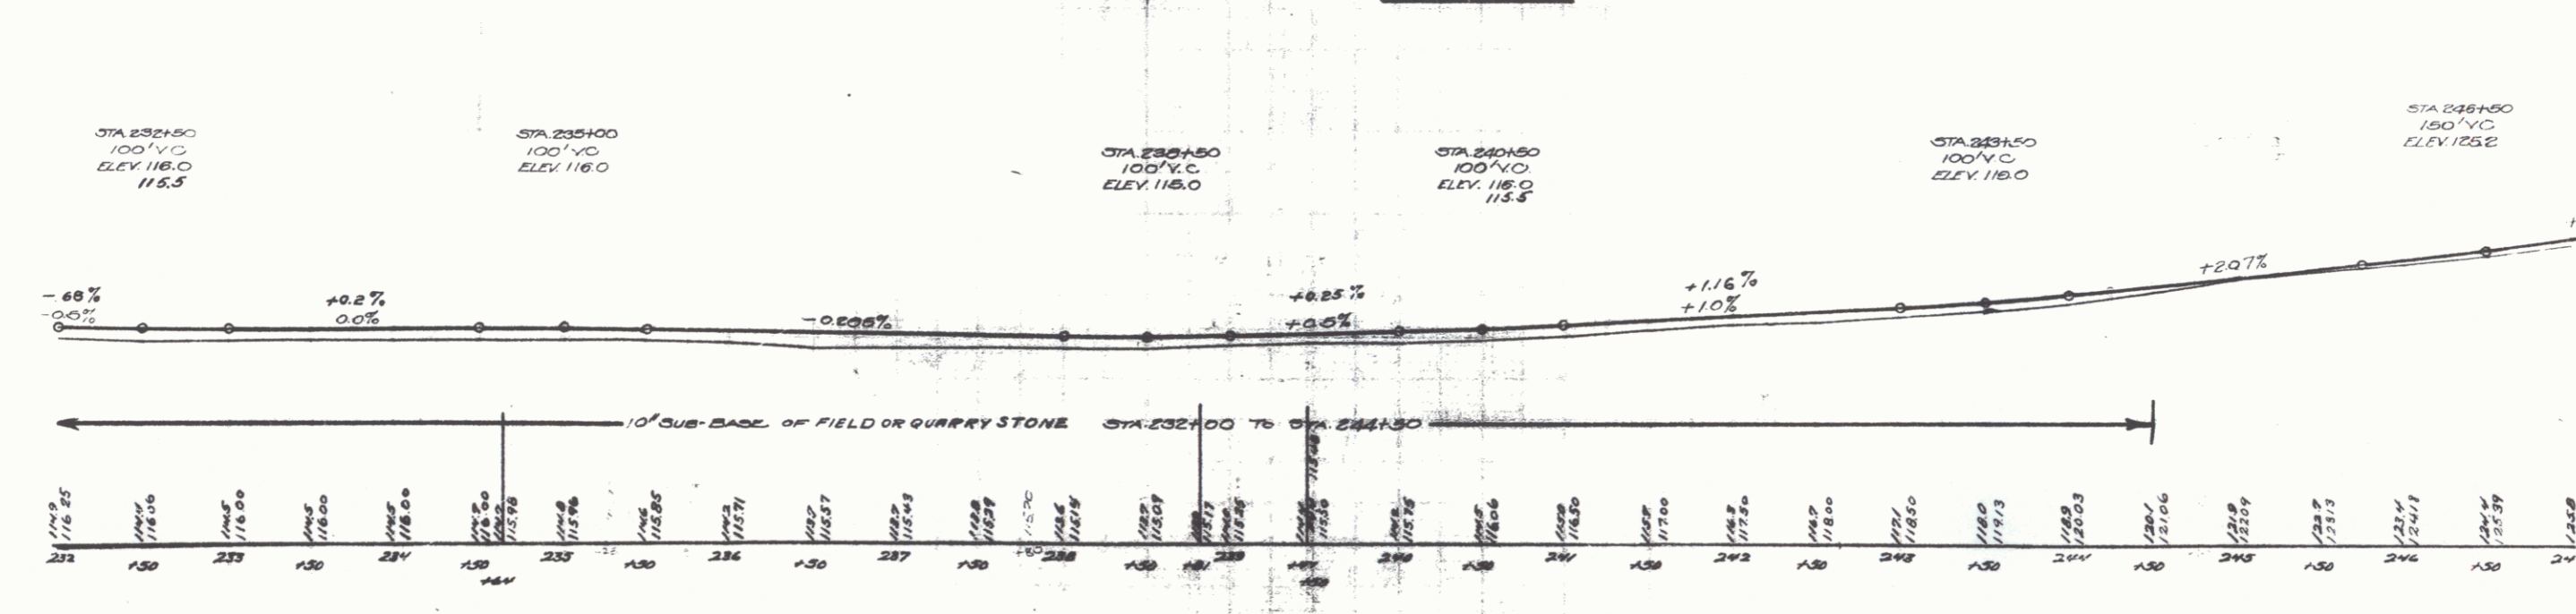


NEW CULVERTS REQUIRED  
 STA 234+50 - 2x2 CONCRETE BOX CULVERT  
 CONC. CLASS A (1-2-4) - 11.7 cu yds  
 REINF. STEEL - 76.3 lbs  
 STA 237+50 - 18" REINF. CONCRETE PIPE 30' LONG  
 CONC. CLASS B (1-2-2) - 1.9 cu yds  
 REINF. STEEL - 33 lbs  
 STA 238+51 - 18" REINF. CONCRETE PIPE 30' LONG  
 CONC. CLASS B (1-2-2) - 1.9 cu yds  
 REINF. STEEL - 33 lbs

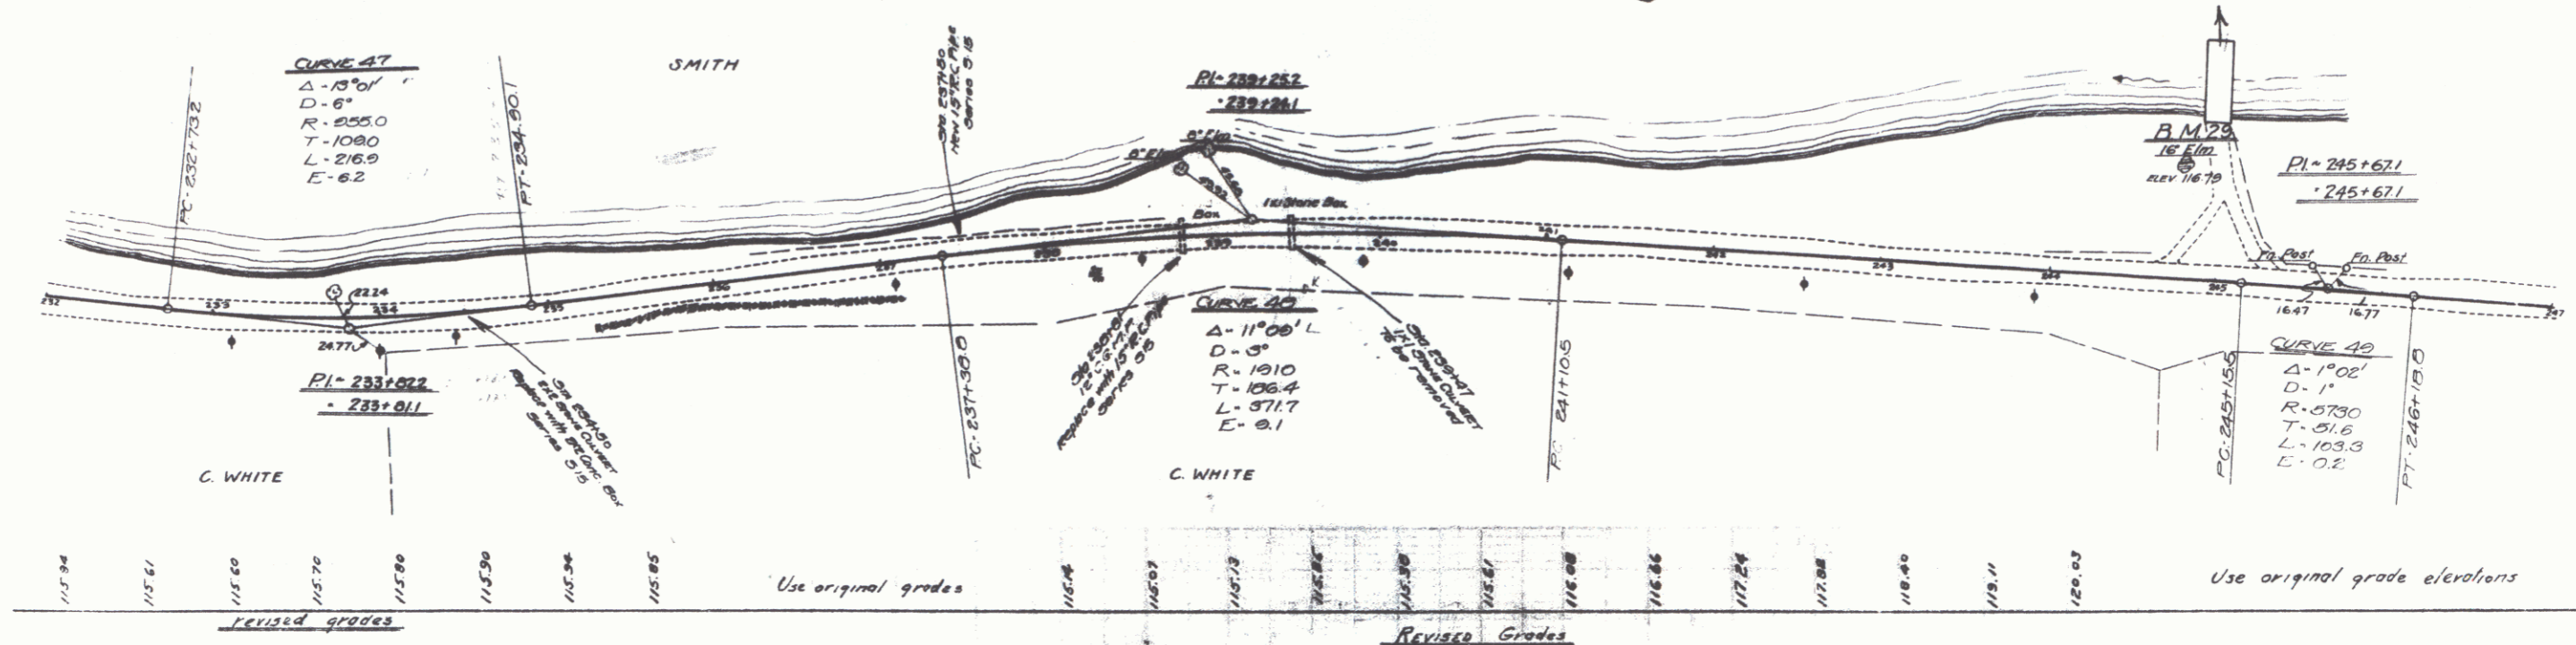

4-55  
 5-27  
 4-5-37  
 NEW  
 M.C.  
 M.C.

18