



NEW CURBERS REQUIRED
 STA 265+30 - 13' REINP CONCRETE PINE 30' LONG
 Conc. Class B(-2 1/2" - 3) - 5.3 cu yds
 Reinf. Steel - 331 lbs.

DATE: 1957 20 87

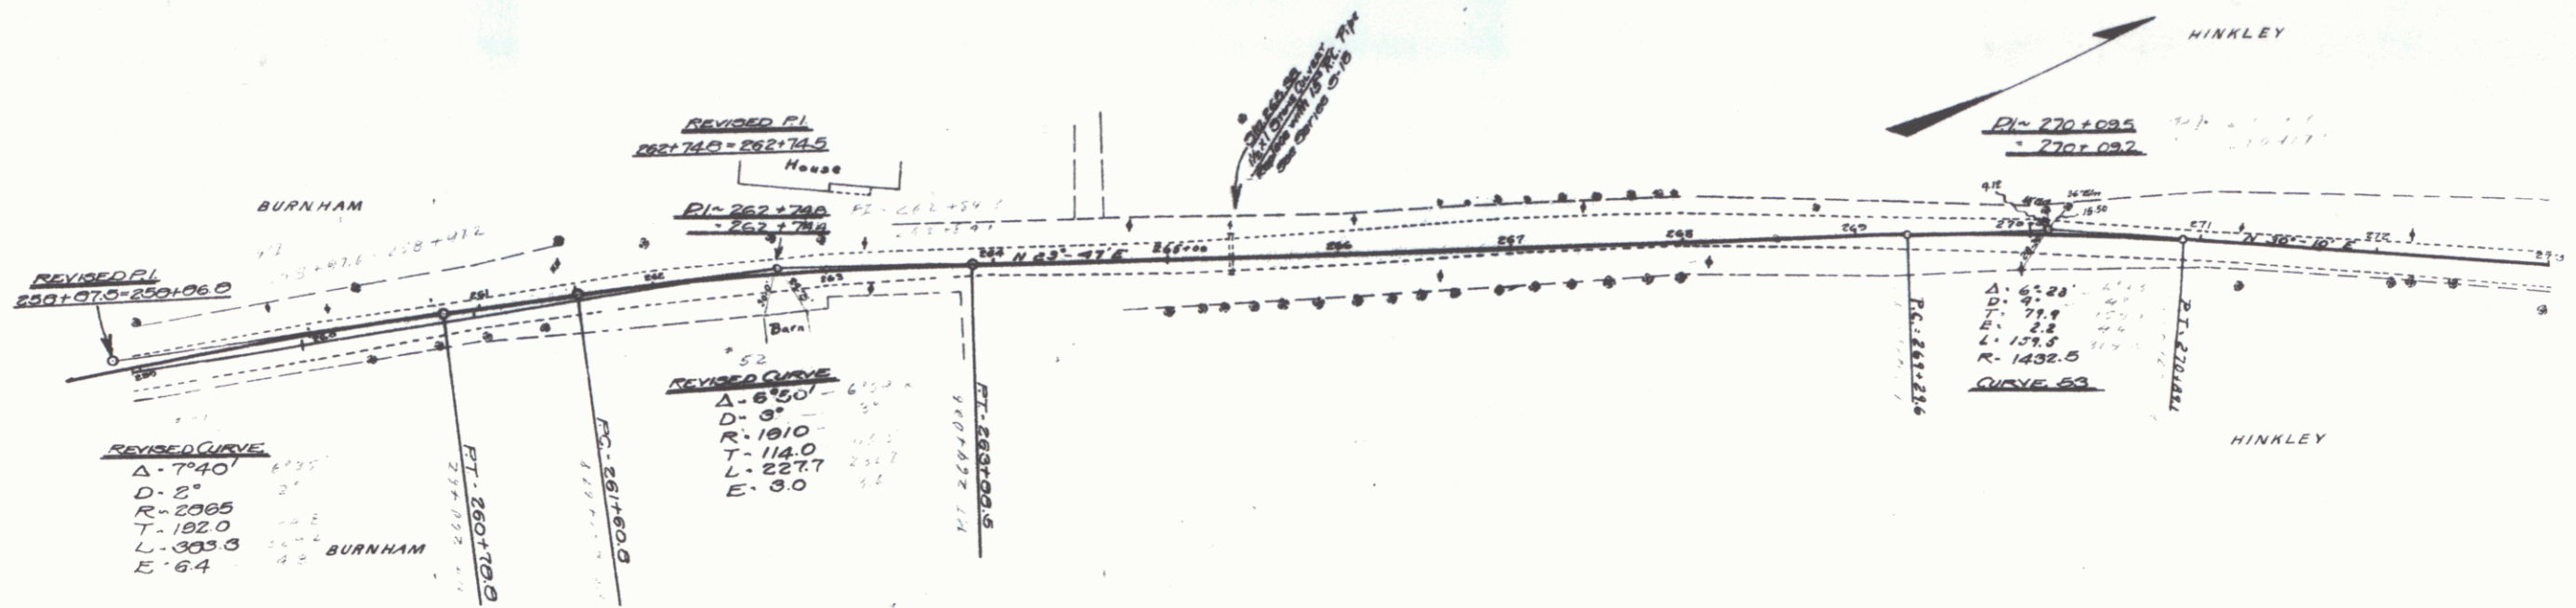

Use original grade elevations

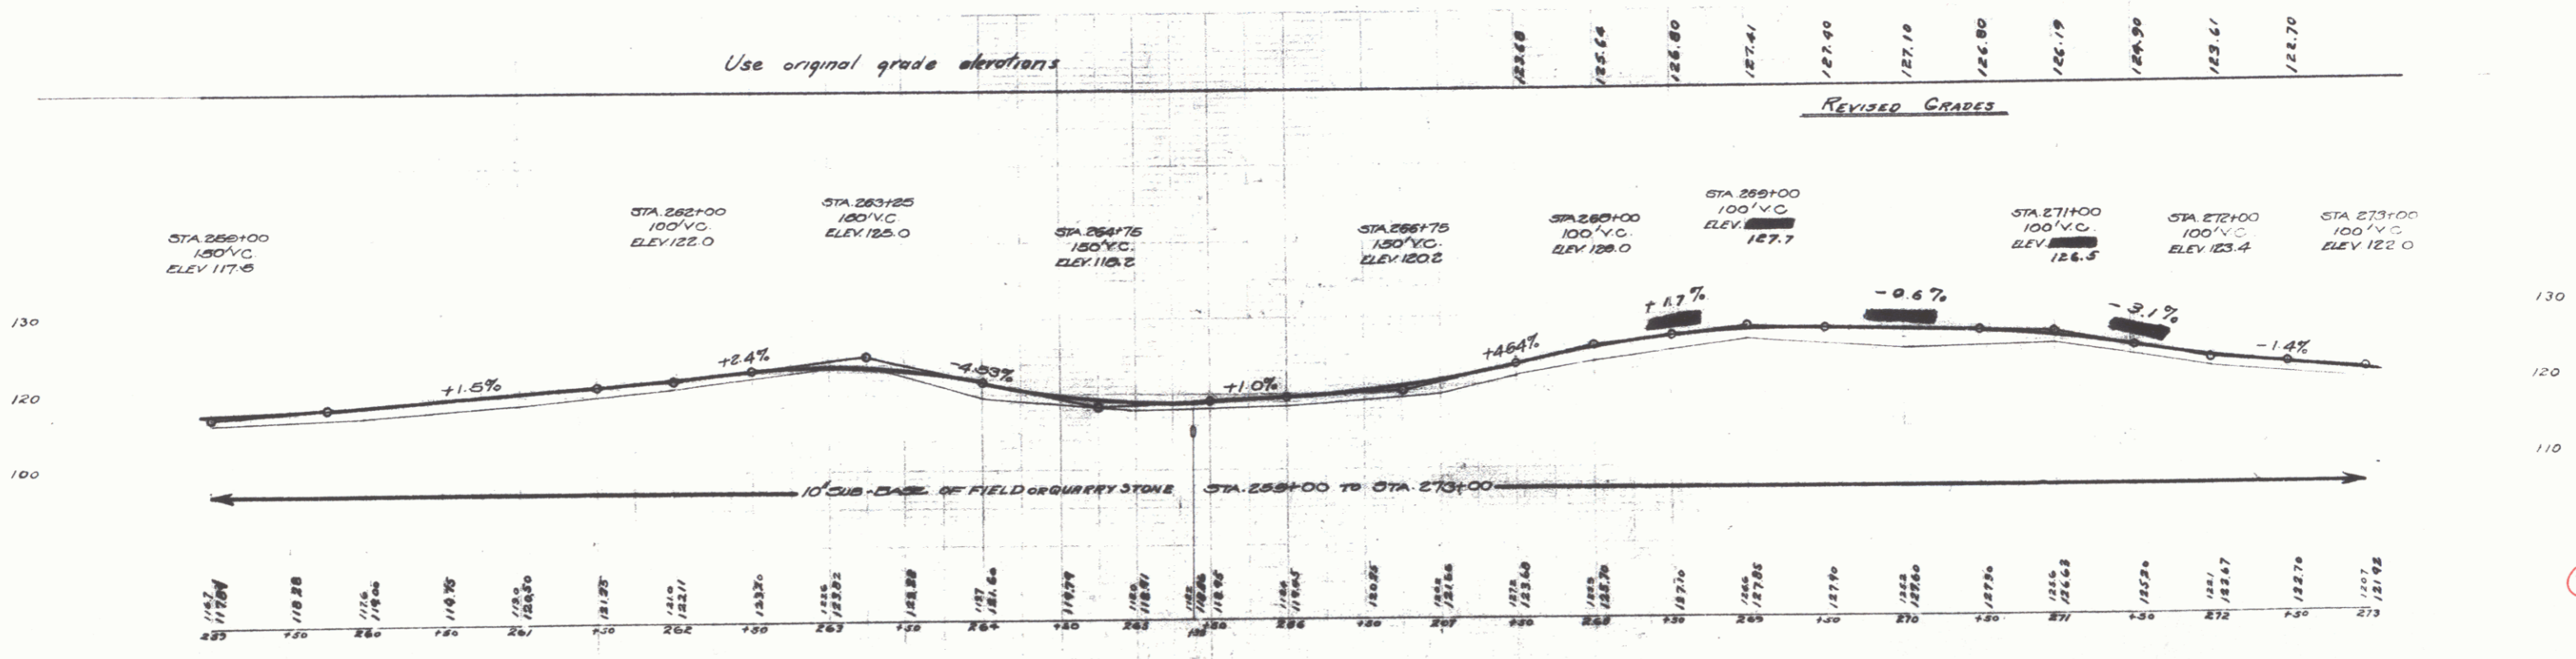

20