

INDEX OF SHEETS

SHEET NO.	TITLE	PAGE
2M	PLAN & PROFILE (BRIDGE NO.2)	
3M	SLAG SQUARE-30" WINGS (MODIFIED FOR 13'0" H)	
4M	SLB 20-CABLE RAIL (15' CLEAR SPAN)	
5M	SB.2 DETAILS S-204-S-220-S-221	
6M	SB.2A S-222-S-227	
7M	SB.2B S-241	
8M	SB.8 CROUTED COBBLE GUTTER	
9M	CROSS SECTIONS	
10M	PLAN & PROFILE (BRIDGE NO.1)	
11M	10'x8' BOX CULVERT PLANS	
12M	SB.5	
13M	CROSS SECTIONS	

FED. ROAD DIST. NO.	STATE	DIST. NO.	PROJECT NO.	SHEET NO.	TOTAL SHEETS
9	VT.	60M	1932	1	13-M

STATE OF VERMONT  
STATE HIGHWAY DEPARTMENT

PLAN AND PROFILE OF PROPOSED  
STATE HIGHWAY  
STATE AID PROJECT


**TOWN OF RANDOLPH** Pin# **000749**

**ROUTE NO. 14** Project No. **SA 80M**

WILLIAMSTOWN GULF ROAD  
BRIDGES LOCATED AT  
9.6 AND 7.4 MILES NORTHERLY  
FROM THE  
JUNCTION OF ROUTE NO. 107

LENGTH OF BRIDGE NO.1 - 12 FEET + 0.002 MILES  
BRIDGE NO.2 - 176 " + 0.003 "

SCALES  
PLAN - - - - - 1 INCH = 50 FEET  
PROFILE HORIZONTAL - - - - - 1 " = 50 "  
" " VERTICAL - - - - - 1 " = 50 "  
CROSS SECTIONS - - - - - 1 " = 5 "

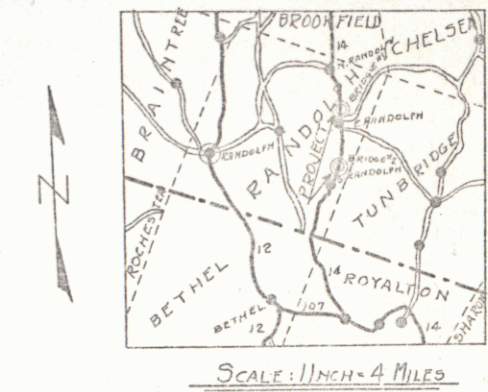

APPROVED: 3/11/32

BY ORDER OF THE STATE HIGHWAY DEPARTMENT  
*W. D. ...*  
COMMISSIONER OF HIGHWAYS

CONVENTIONAL SIGNS

SYMBOL	DESCRIPTION
[Symbol]	GROUND ELEVATION
[Symbol]	GRADE ELEVATION
[Symbol]	CURVE DATA

MILEAGE STA. 1567+65-BRIDGE NO. 1  
.. .. 1454+81 .. .. 2

Bridge 37  
MM 5.407

Bridge 33  
MM 3.264

CORRECTED  
*A. D. ...*  
ENGINEER

SERIES G.A.R.N.O. 60-1150  
SHEET 1 OF 13-M

DIST. # 4 Plans