



POOR ORIGINAL COPY

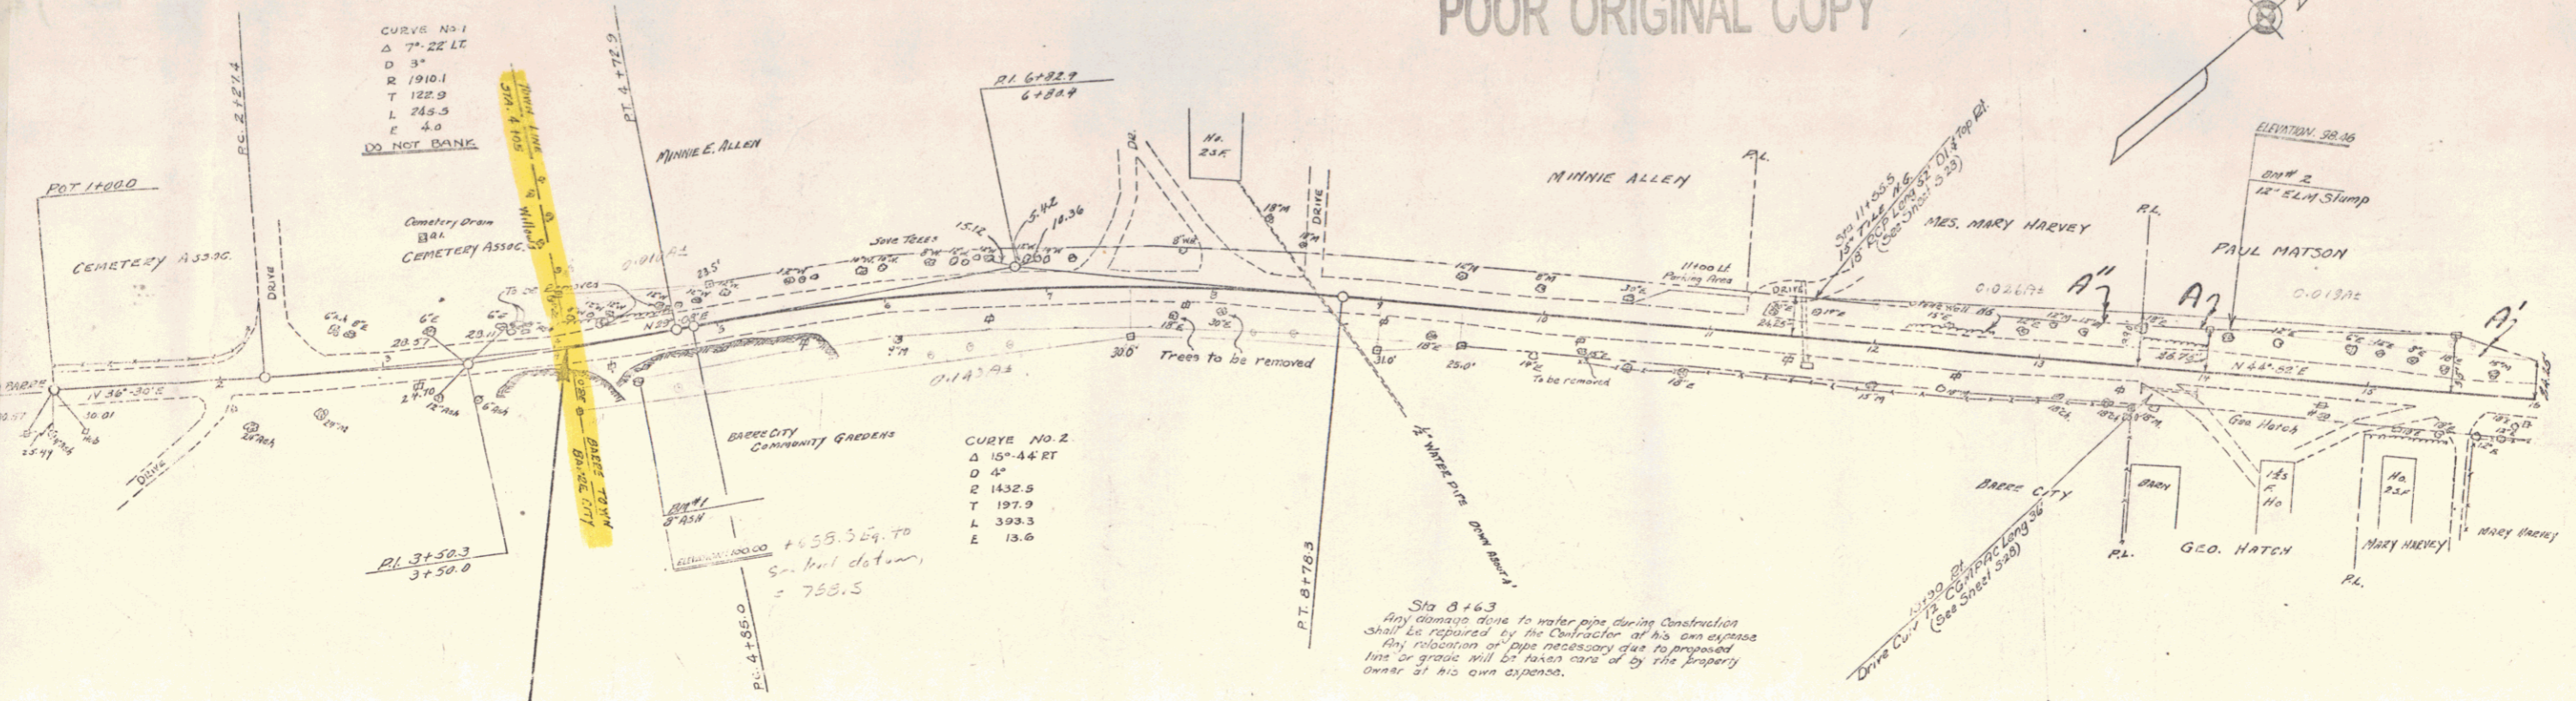

STA. 4+05
BEGIN PROJECT WORK 181-B
FEDERAL AID MARKER ERECTED

Note: Grade Revised
Sta. 4+00 to 16+00
May 7, 1934

Profile	Kind of Data or Instrument/Instrument	Date	Genitor	Genitor Elected	Revised
A	O.C.D.	6-22-36	PAUL MATSON & FRANK M. DUNK	20	2.33 6-23-36
A'	O.C.D.	3-9-36	"	20	2.34 3-7-36
A''	O.C.D.	6-13-36	MARY C. HARVEY	20	2.35 6-7-36

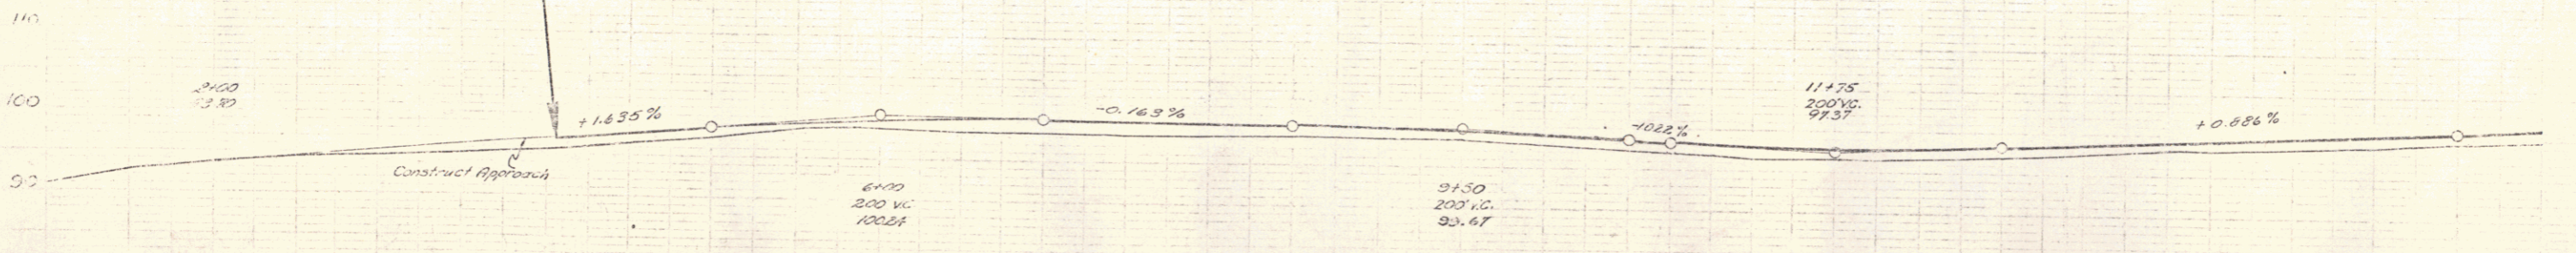

FOR INFO: GRADE IN LOT OF BUN LON, CORNER 181-B, IS 4.45. ELEVATION 92.55. BEING 2.00' ABOVE 12.00' ELEVATION 100.55. ELEVATION 100.55.