


Sta. 18+30 & 20+70 & 25+60  
 Any damage done to water pipe during construction shall be repaired by the Contractor at his own expense. Any relocation of pipe necessary due to proposed line or grade will be taken care of by the property owner at his own expense.

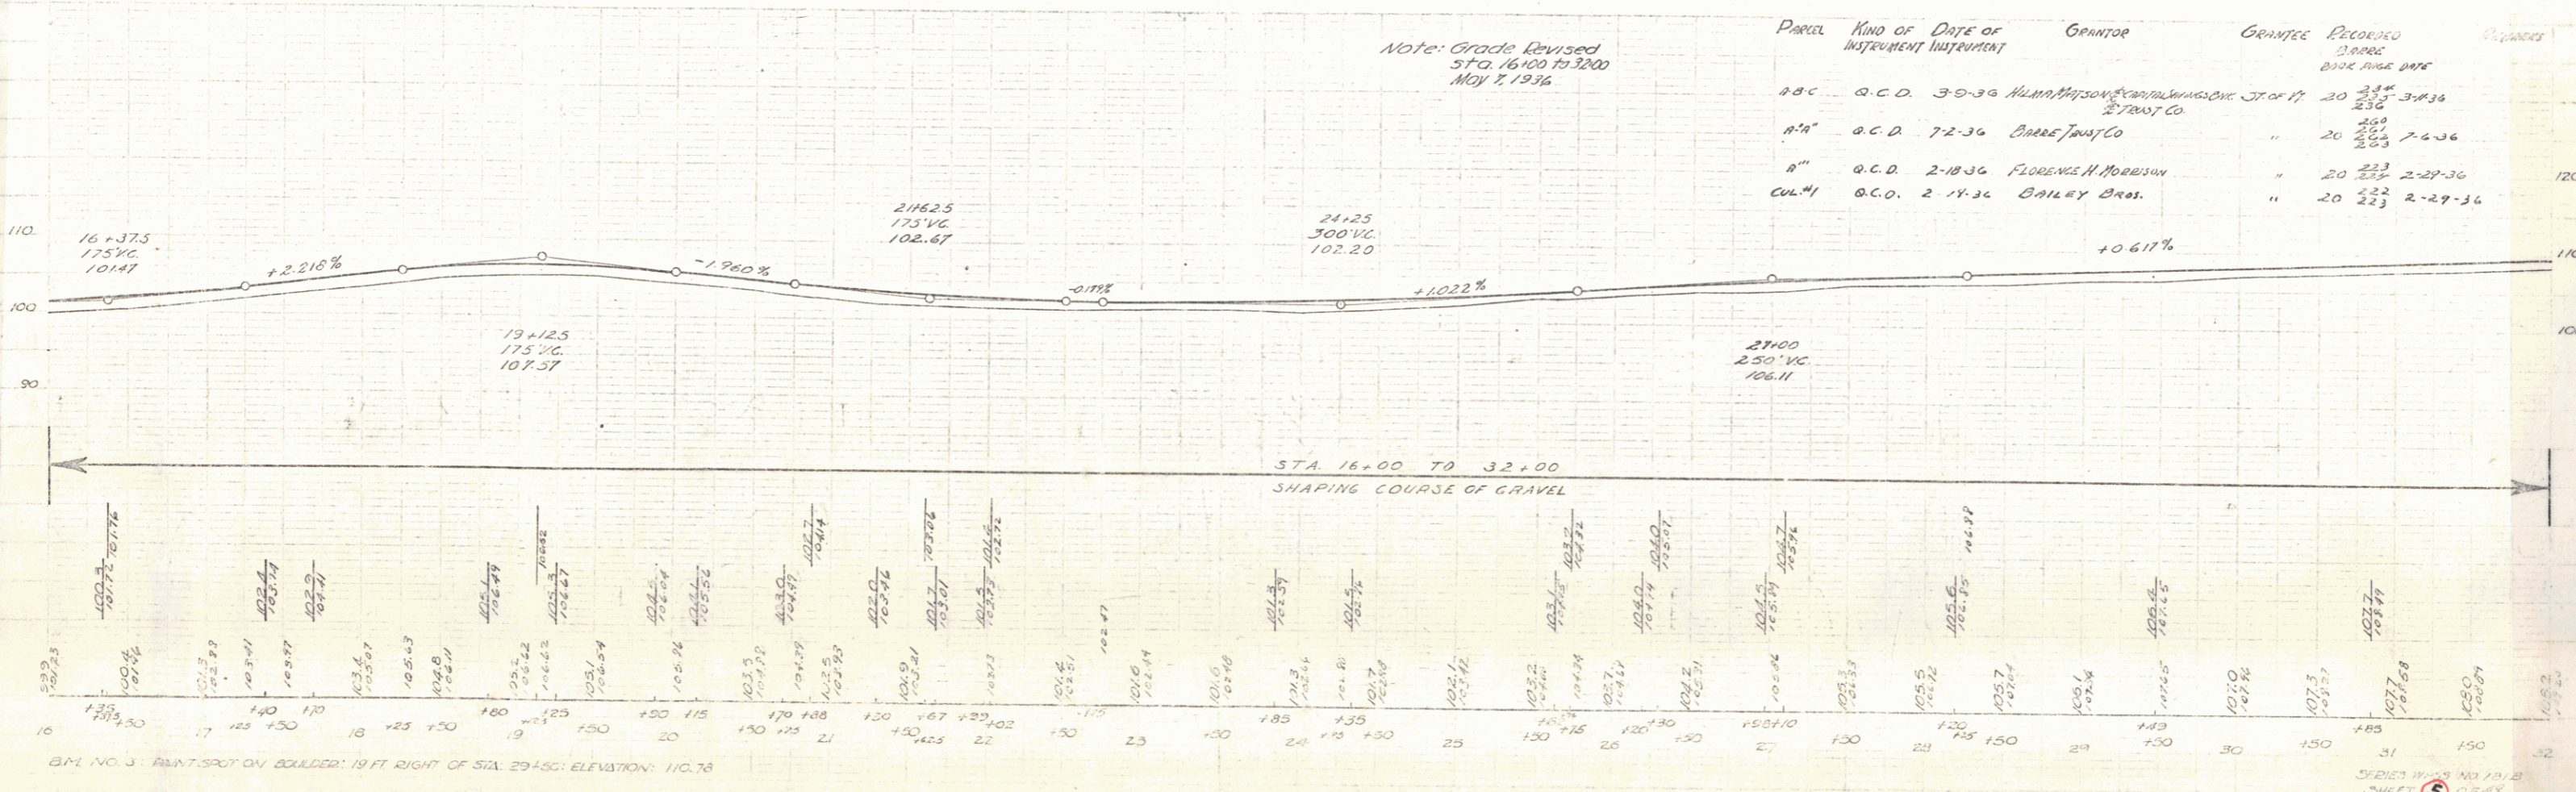

PARCEL	KIND OF INSTRUMENT	DATE OF INSTRUMENT	GRANTOR	GRANTEE	RECORDED BOOK PAGE DATE	REMARKS
18C	O.C.D.	3-0-36	HILMA MATSON & HARRY HOLT	BARRE TRUST CO.	20 234 3-4-36	
18A	O.C.D.	7-2-36	BARRE TRUST CO.	"	20 235 7-4-36	
18B	O.C.D.	2-18-36	FLORENCE H. MORRISON	"	20 233 2-27-36	120
CUL. #1	O.C.D.	2-14-36	BAILEY BROS.	"	20 223 2-27-36	

B.M. NO. 3: PAINT-SPOT ON BOULDER: 19 FT. RIGHT OF STA. 29+50; ELEVATION: 110.78