


NOTE: GRADE ON INSIDE OF CURVE 9 FT RIGHT

NOTE: GRADE DEvised FROM Δ TO INSIDE OF CURVE STA 47+00 TO 51+18 MAY 7, 1936

Grade Devised STA 50+00 TO 53+50 NOV 7, 1936

Parcel	Kind of	Date of	Owner	Grantee	Recorded	Remarks
A-B-C	O.C.D.	3-9-36	Leo J. & Rose Brosette Capital Savings Bank & Trust Co.	Storff	20336	3-11-36
A-B-C	O.C.D.	3-9-36	Leo J. & Rose Brosette Capital Savings Bank & Trust Co.	"	20337	3-11-36
A-B-C	O.C.D.	2-21-36	Leo J. & Rose Brosette Capital Savings Bank & Trust Co.	"	20338	3-29-36

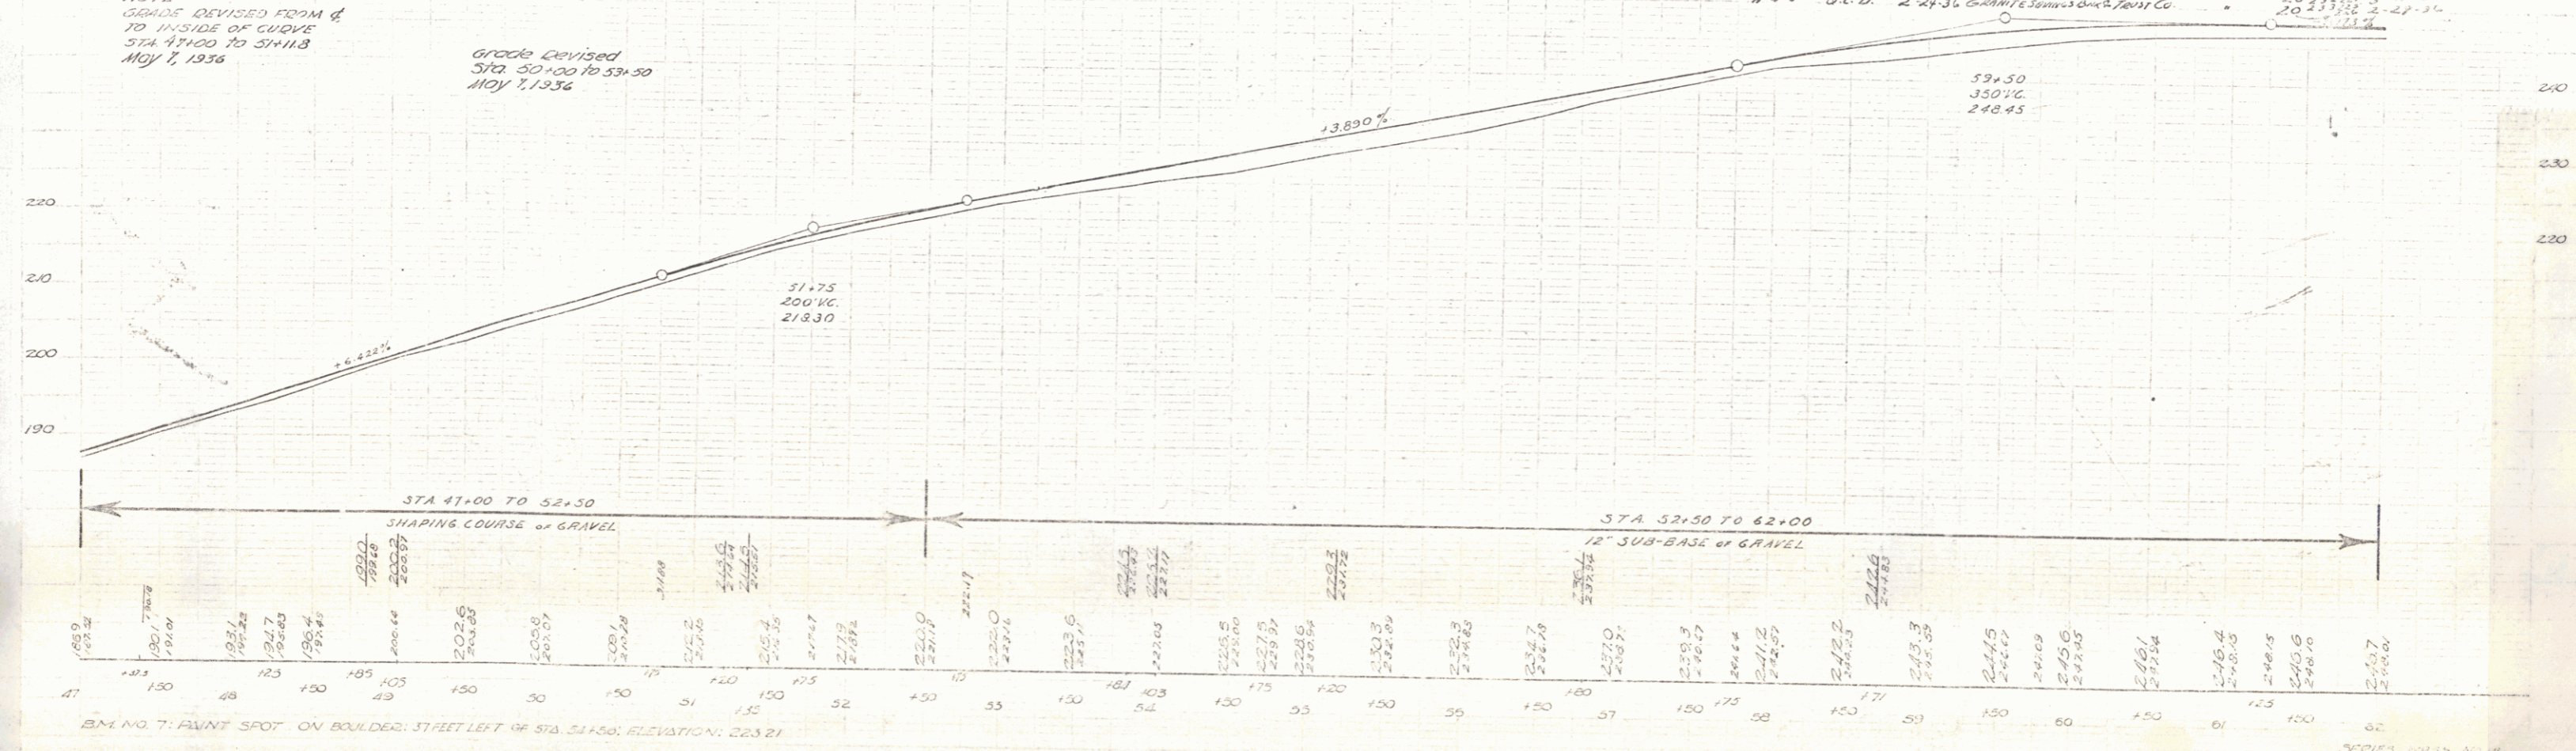

BM NO. 7: AVANT SPOT ON BOULDER: 27 FEET LEFT OF STA 51+50; ELEVATION: 223.21