


PARCEL	NO. OF DATE OF GRANTOR INSTRUMENT	GRANTEE	RECORDED BOOKS
A B C	Q.C.D. 224-36	GRANITE SAVINGS BANK TRUST CO.	BOOK PAGE 2416
			225
			226
			227

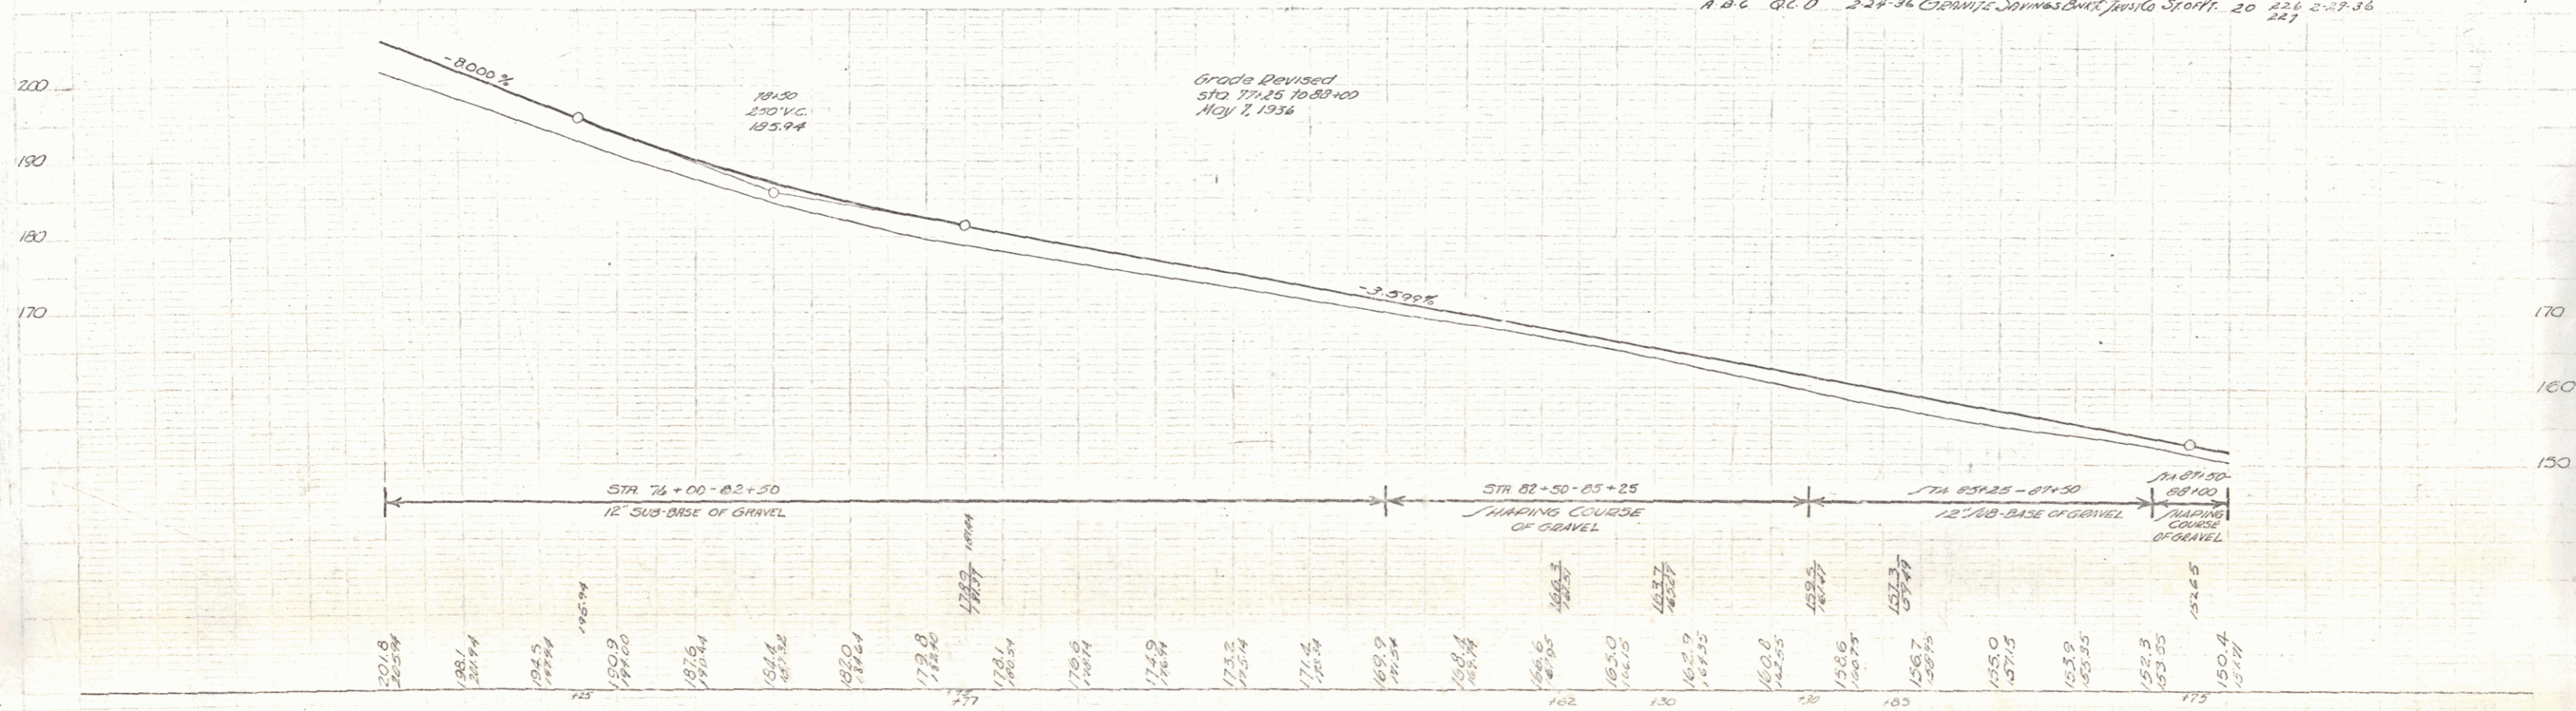

B.M. NO. 10: SPOT ON BOULDER 18' LT. STA. 76+84. ELEVATION: 193.07  
 B.M. NO. 11: NAIL IN ROOT OF 36" SPURGE 19' LT. STA. 84+77. ELEVATION: 163.99.