
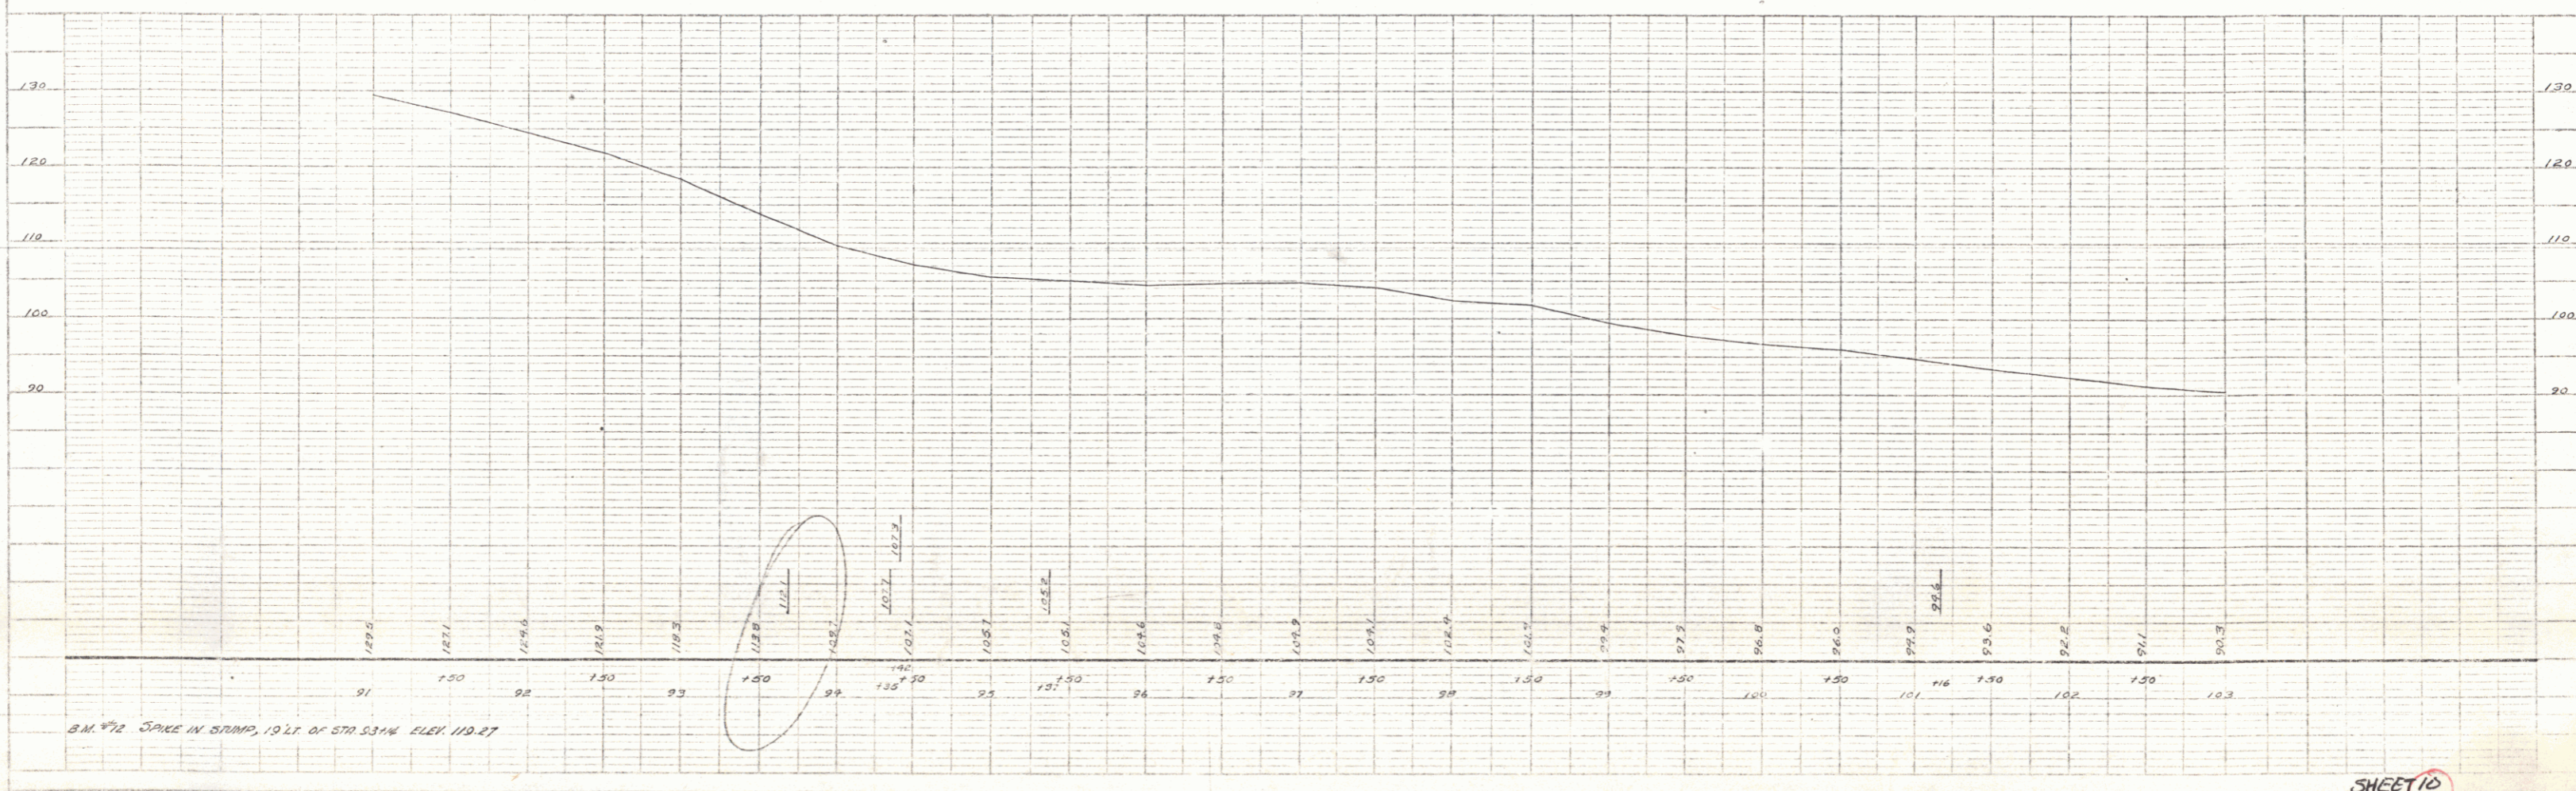


PLAN
 SHEET NO. 534
 DATE 1934
 DRAWN BY D. MACCHI
 CHECKED BY

PROFILES
 SHEET NO. 534
 DATE 1934
 DRAWN BY
 CHECKED BY

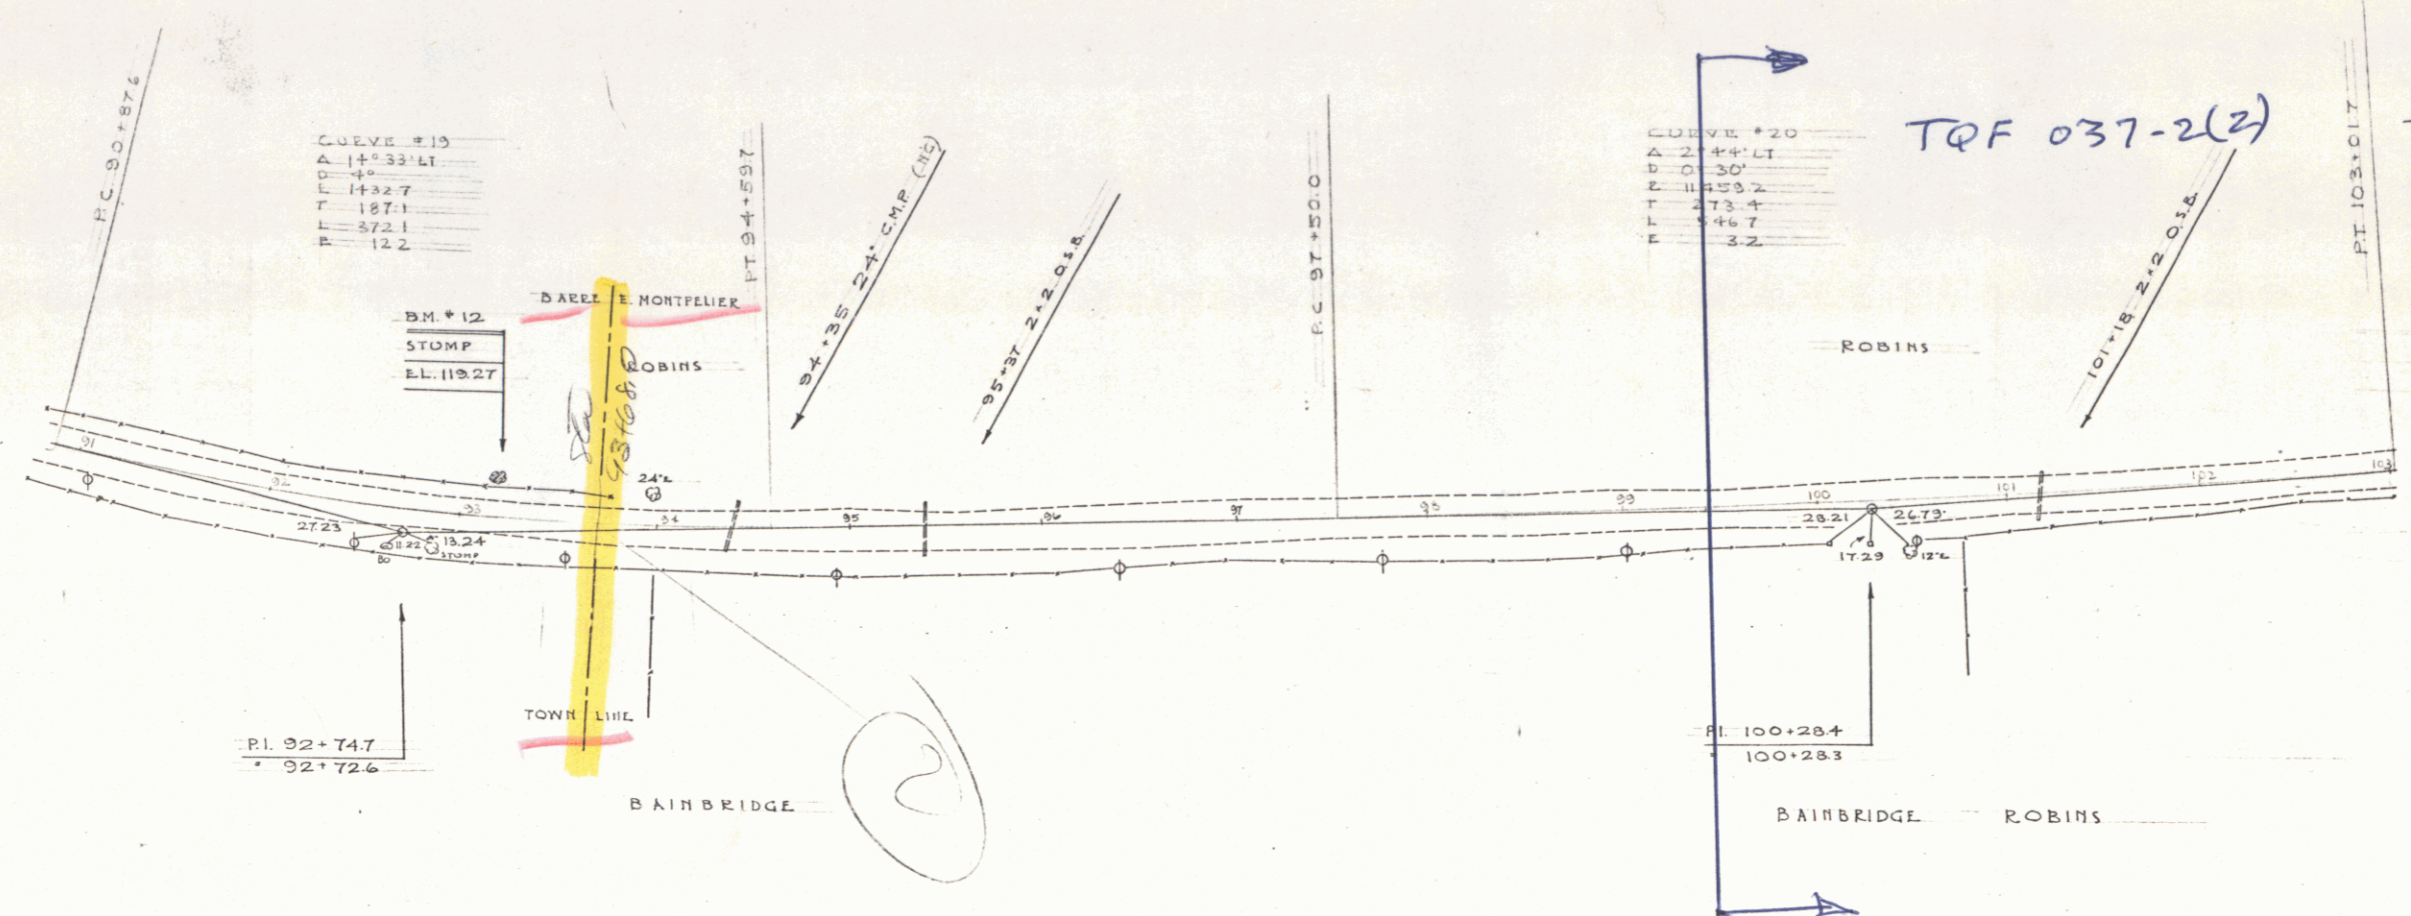

B.M. #72 Same in ground, 1921 of STA 5314 ELEV. 110.27

PLATE 1-PLAN, PROFILE & P.C. & C.L. LINES
 SCALE: 1" = 20' HORIZ. 1" = 10' VERT.

SHEET 10