
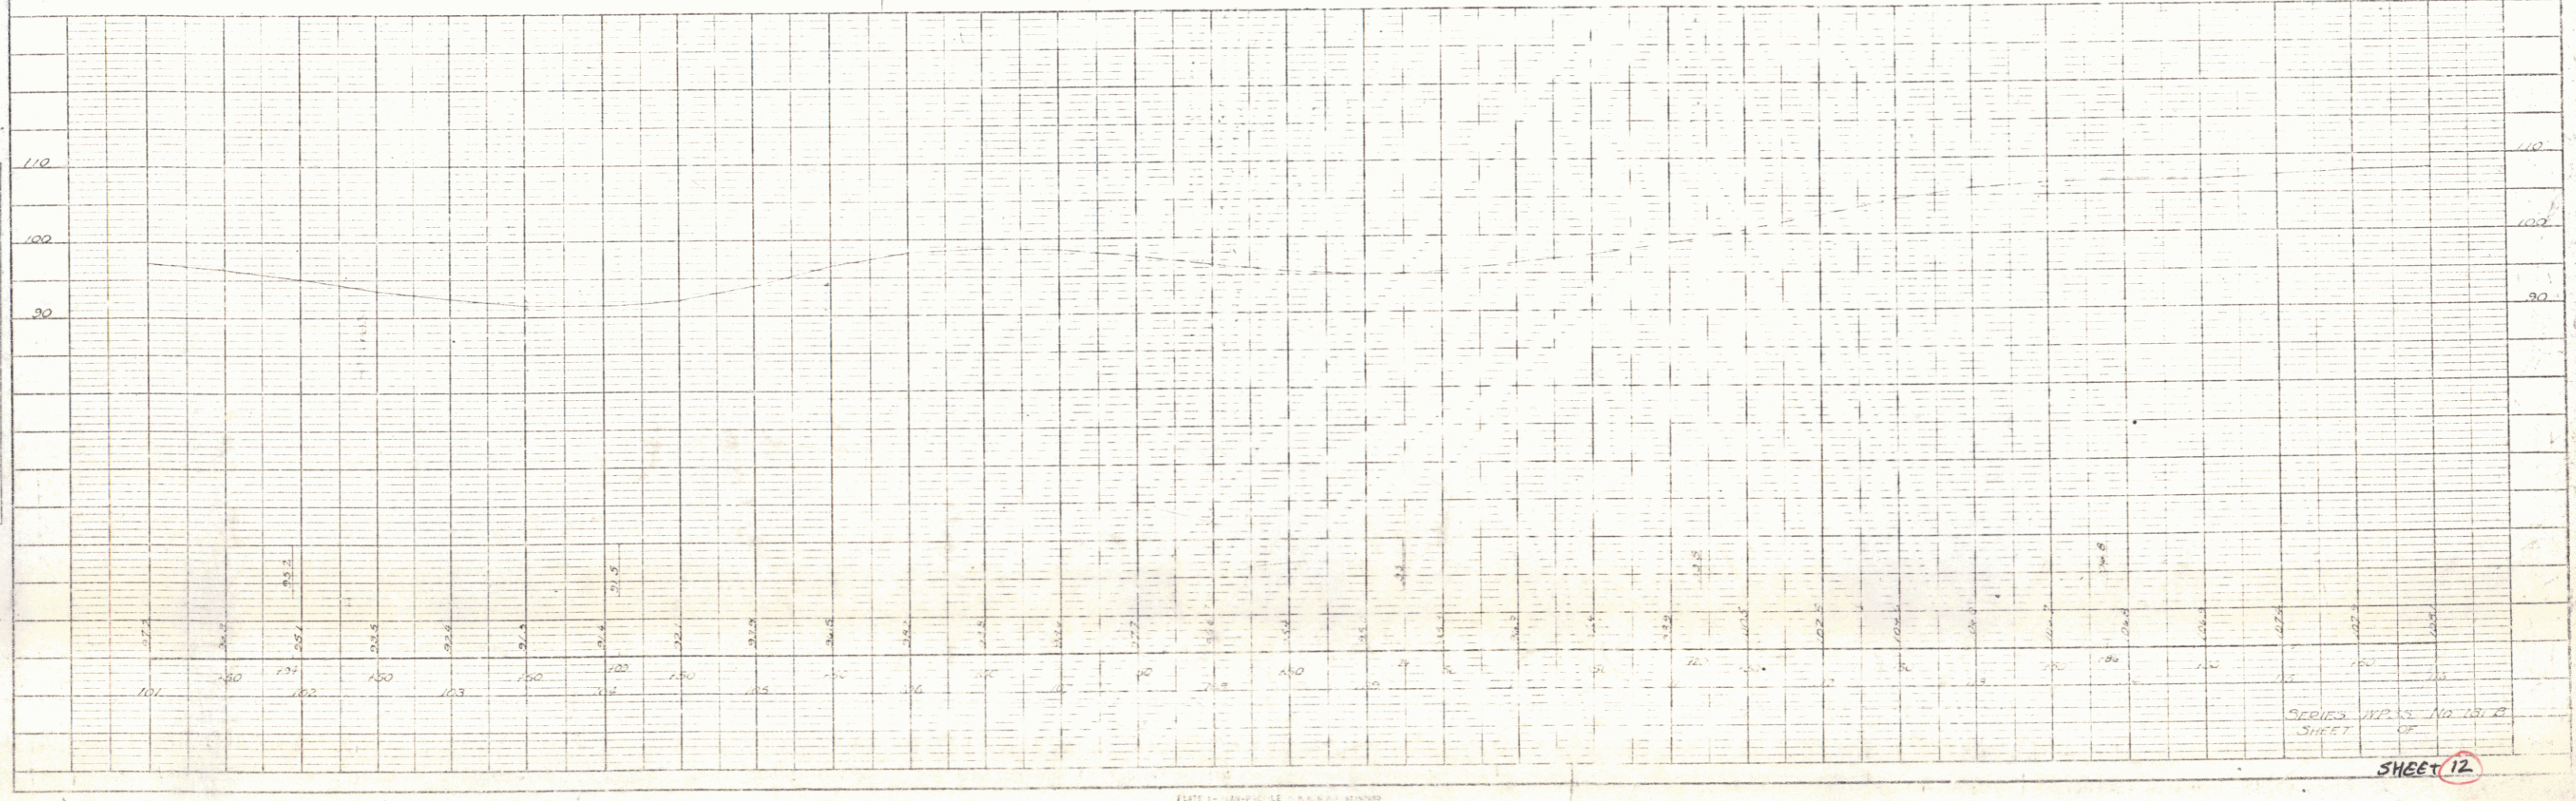


PLAN  
 DATE: 1942  
 DRAWN BY: [Signature]  
 CHECKED BY: [Signature]  
 PROJECT: [Illegible]  
 SHEET NO.: 12

FILE NO.: [Illegible]  
 DATE: [Illegible]  
 DRAWN BY: [Illegible]  
 CHECKED BY: [Illegible]  
 PROJECT: [Illegible]  
 SHEET NO.: 12

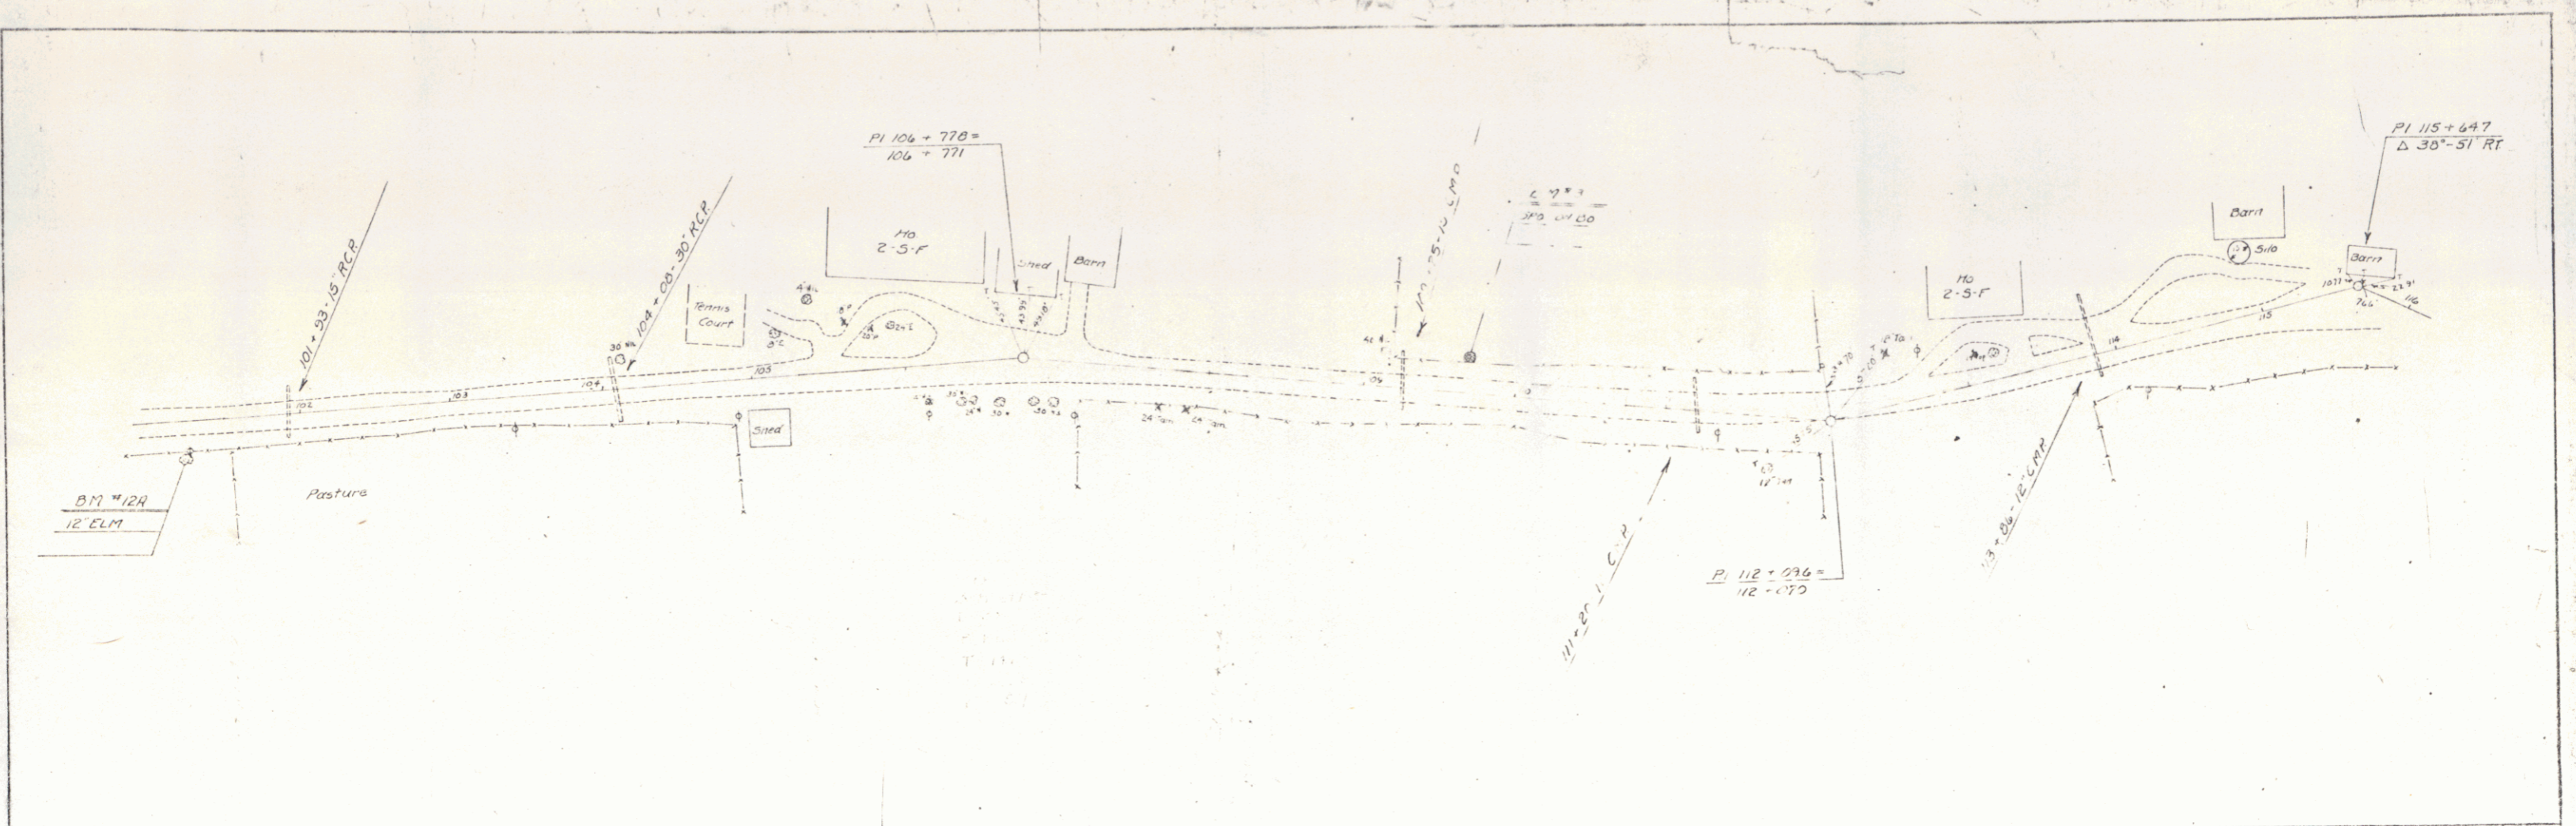

SERIES: [Illegible]  
 SHEET: 12