


PLAN
 DRAWN BY: NARDOLSI, D. MACCHI
 CHECKED BY: TEASED, D. BRACCHI
 DATE: 9/58

PROFILE
 DRAWN BY: NARDOLSI, D. MACCHI
 CHECKED BY: TEASED, D. BRACCHI
 DATE: 9/58

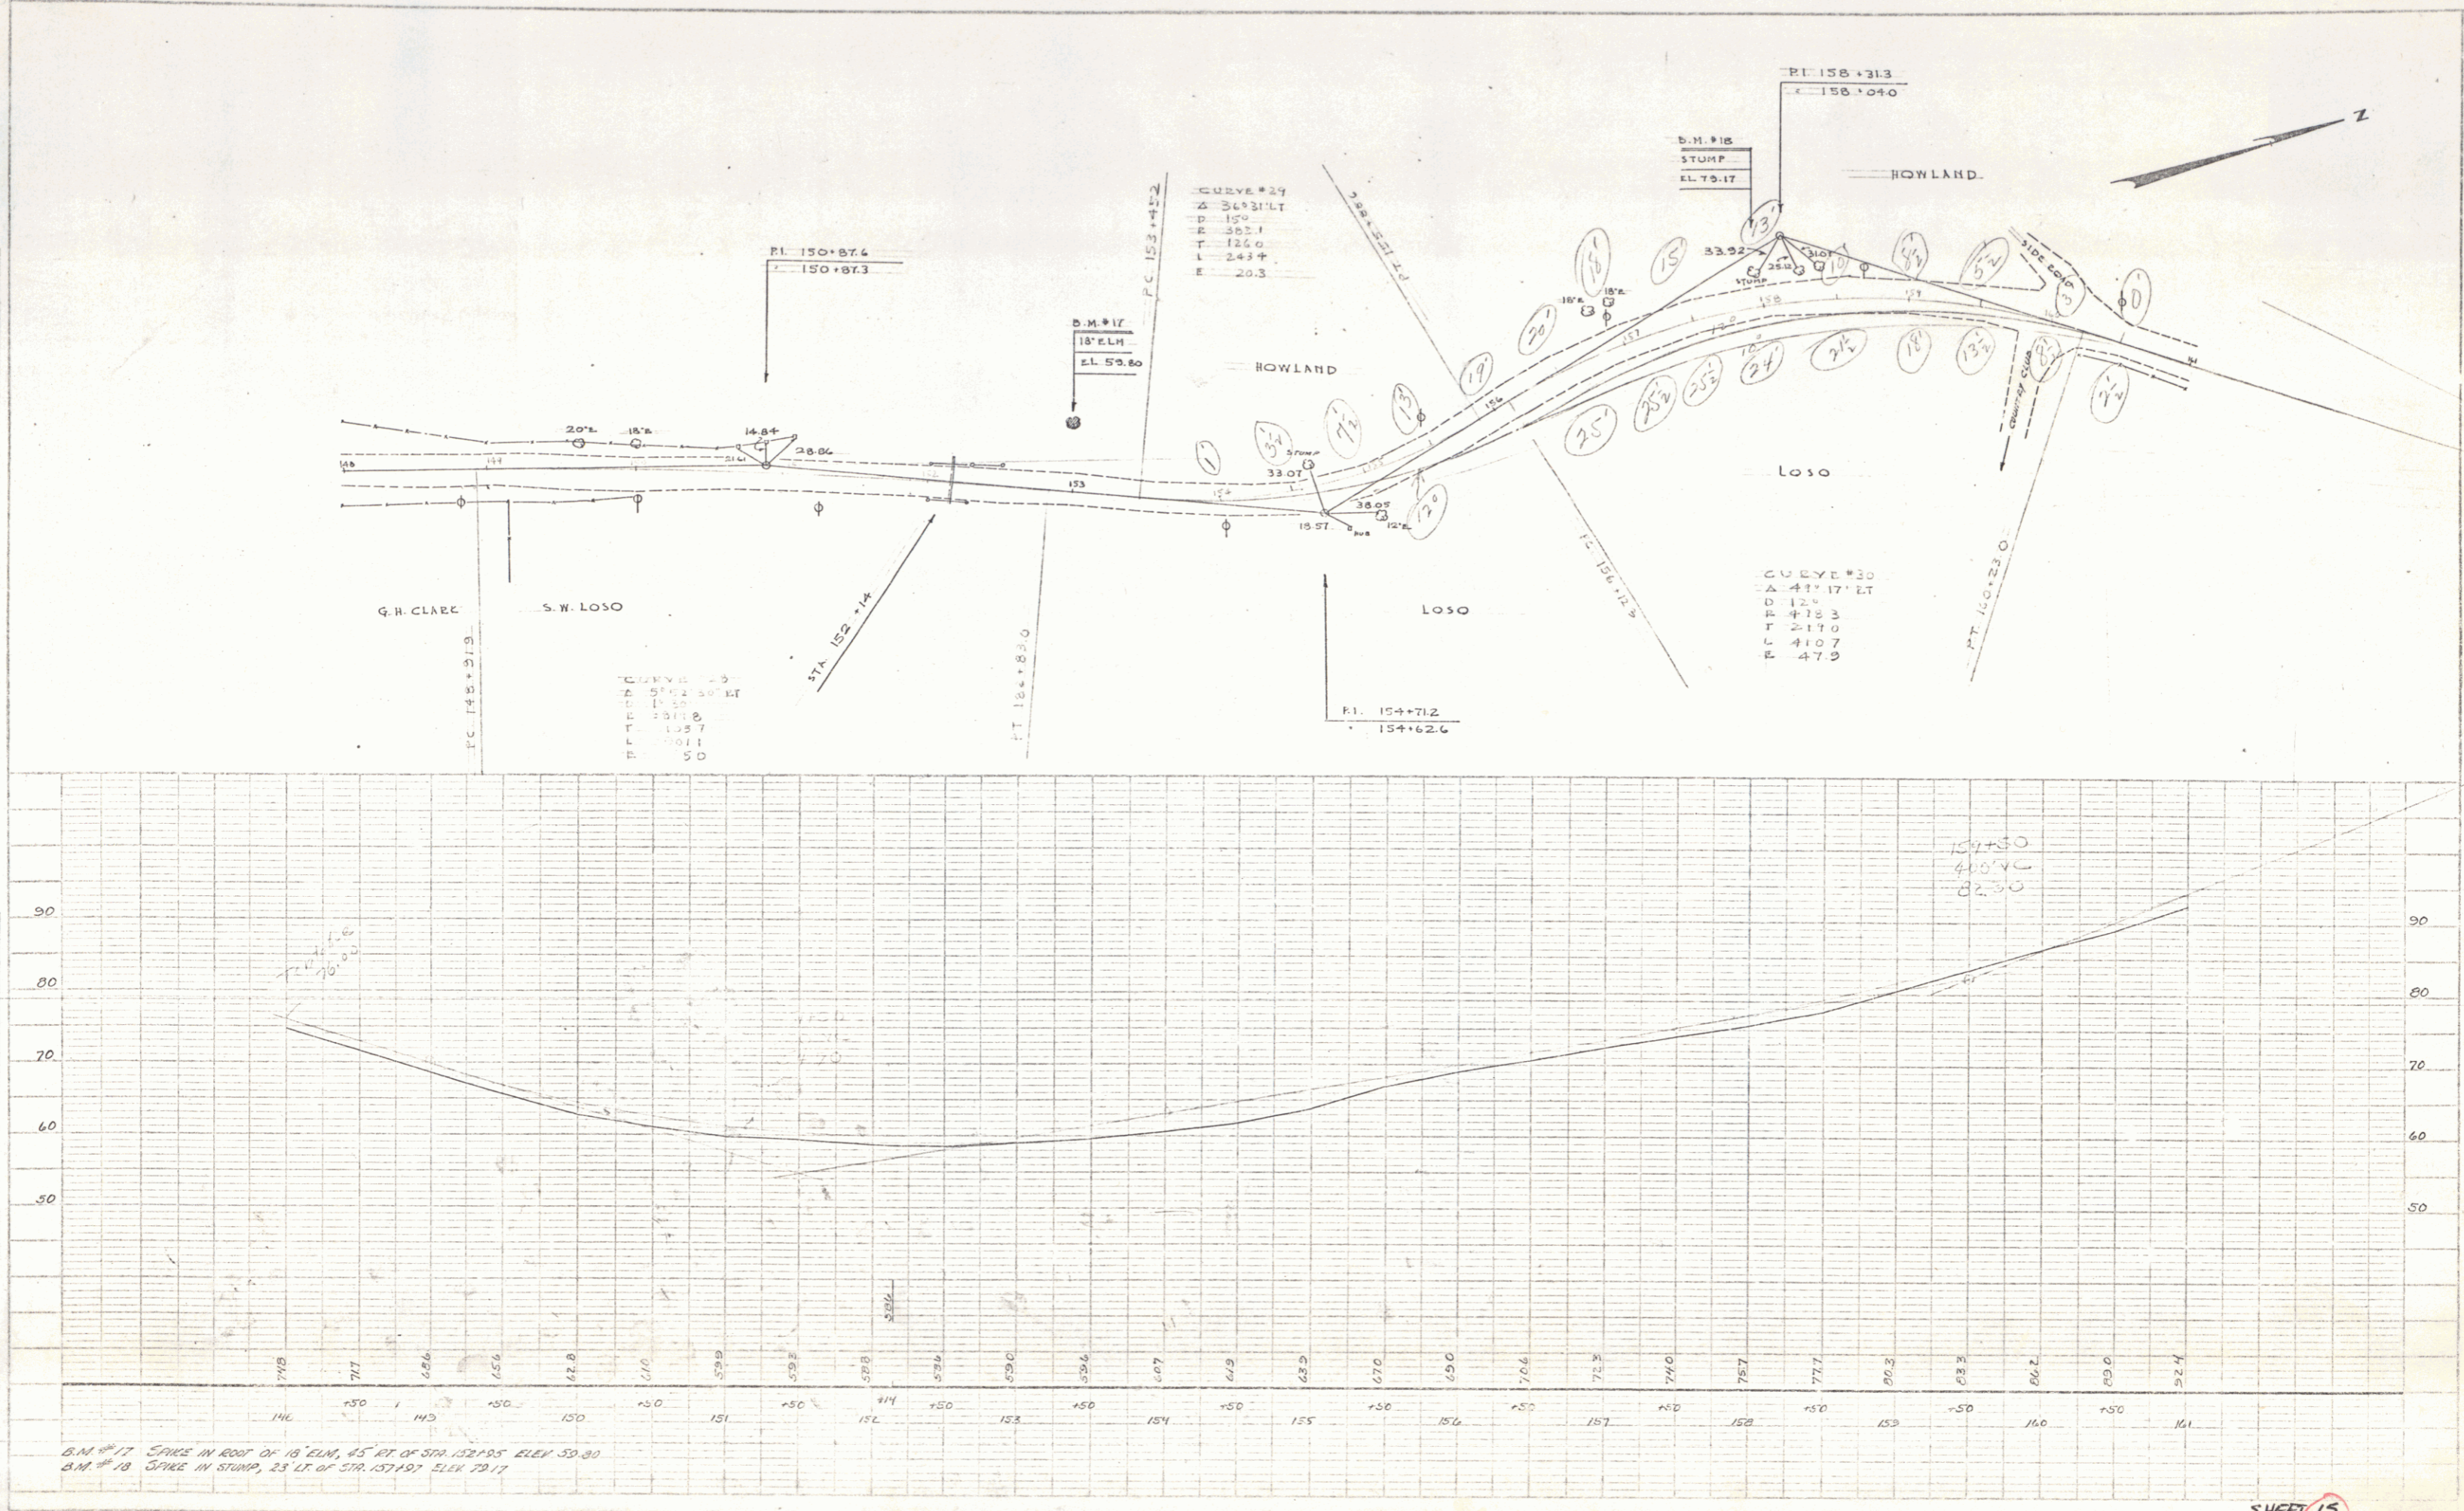

D.M.#17 SPIKE IN ROOT OF 18' ELH, 45' RT OF STA. 152+14.5 ELEV. 30.00
 D.M.#18 SPIKE IN STUMP, 23' LT OF STA. 157+10.5 ELEV. 79.17

SHEET 13