


FIELD BOOK
 PROJECT: MADOLETT
 MAP: 1000
 DATE: 1/24/54
 DRAWN BY: D. MASCHI
 CHECKED BY:

PROJECT: MADOLETT
 MAP: 1000
 DATE: 1/24/54
 DRAWN BY: D. MASCHI
 CHECKED BY:

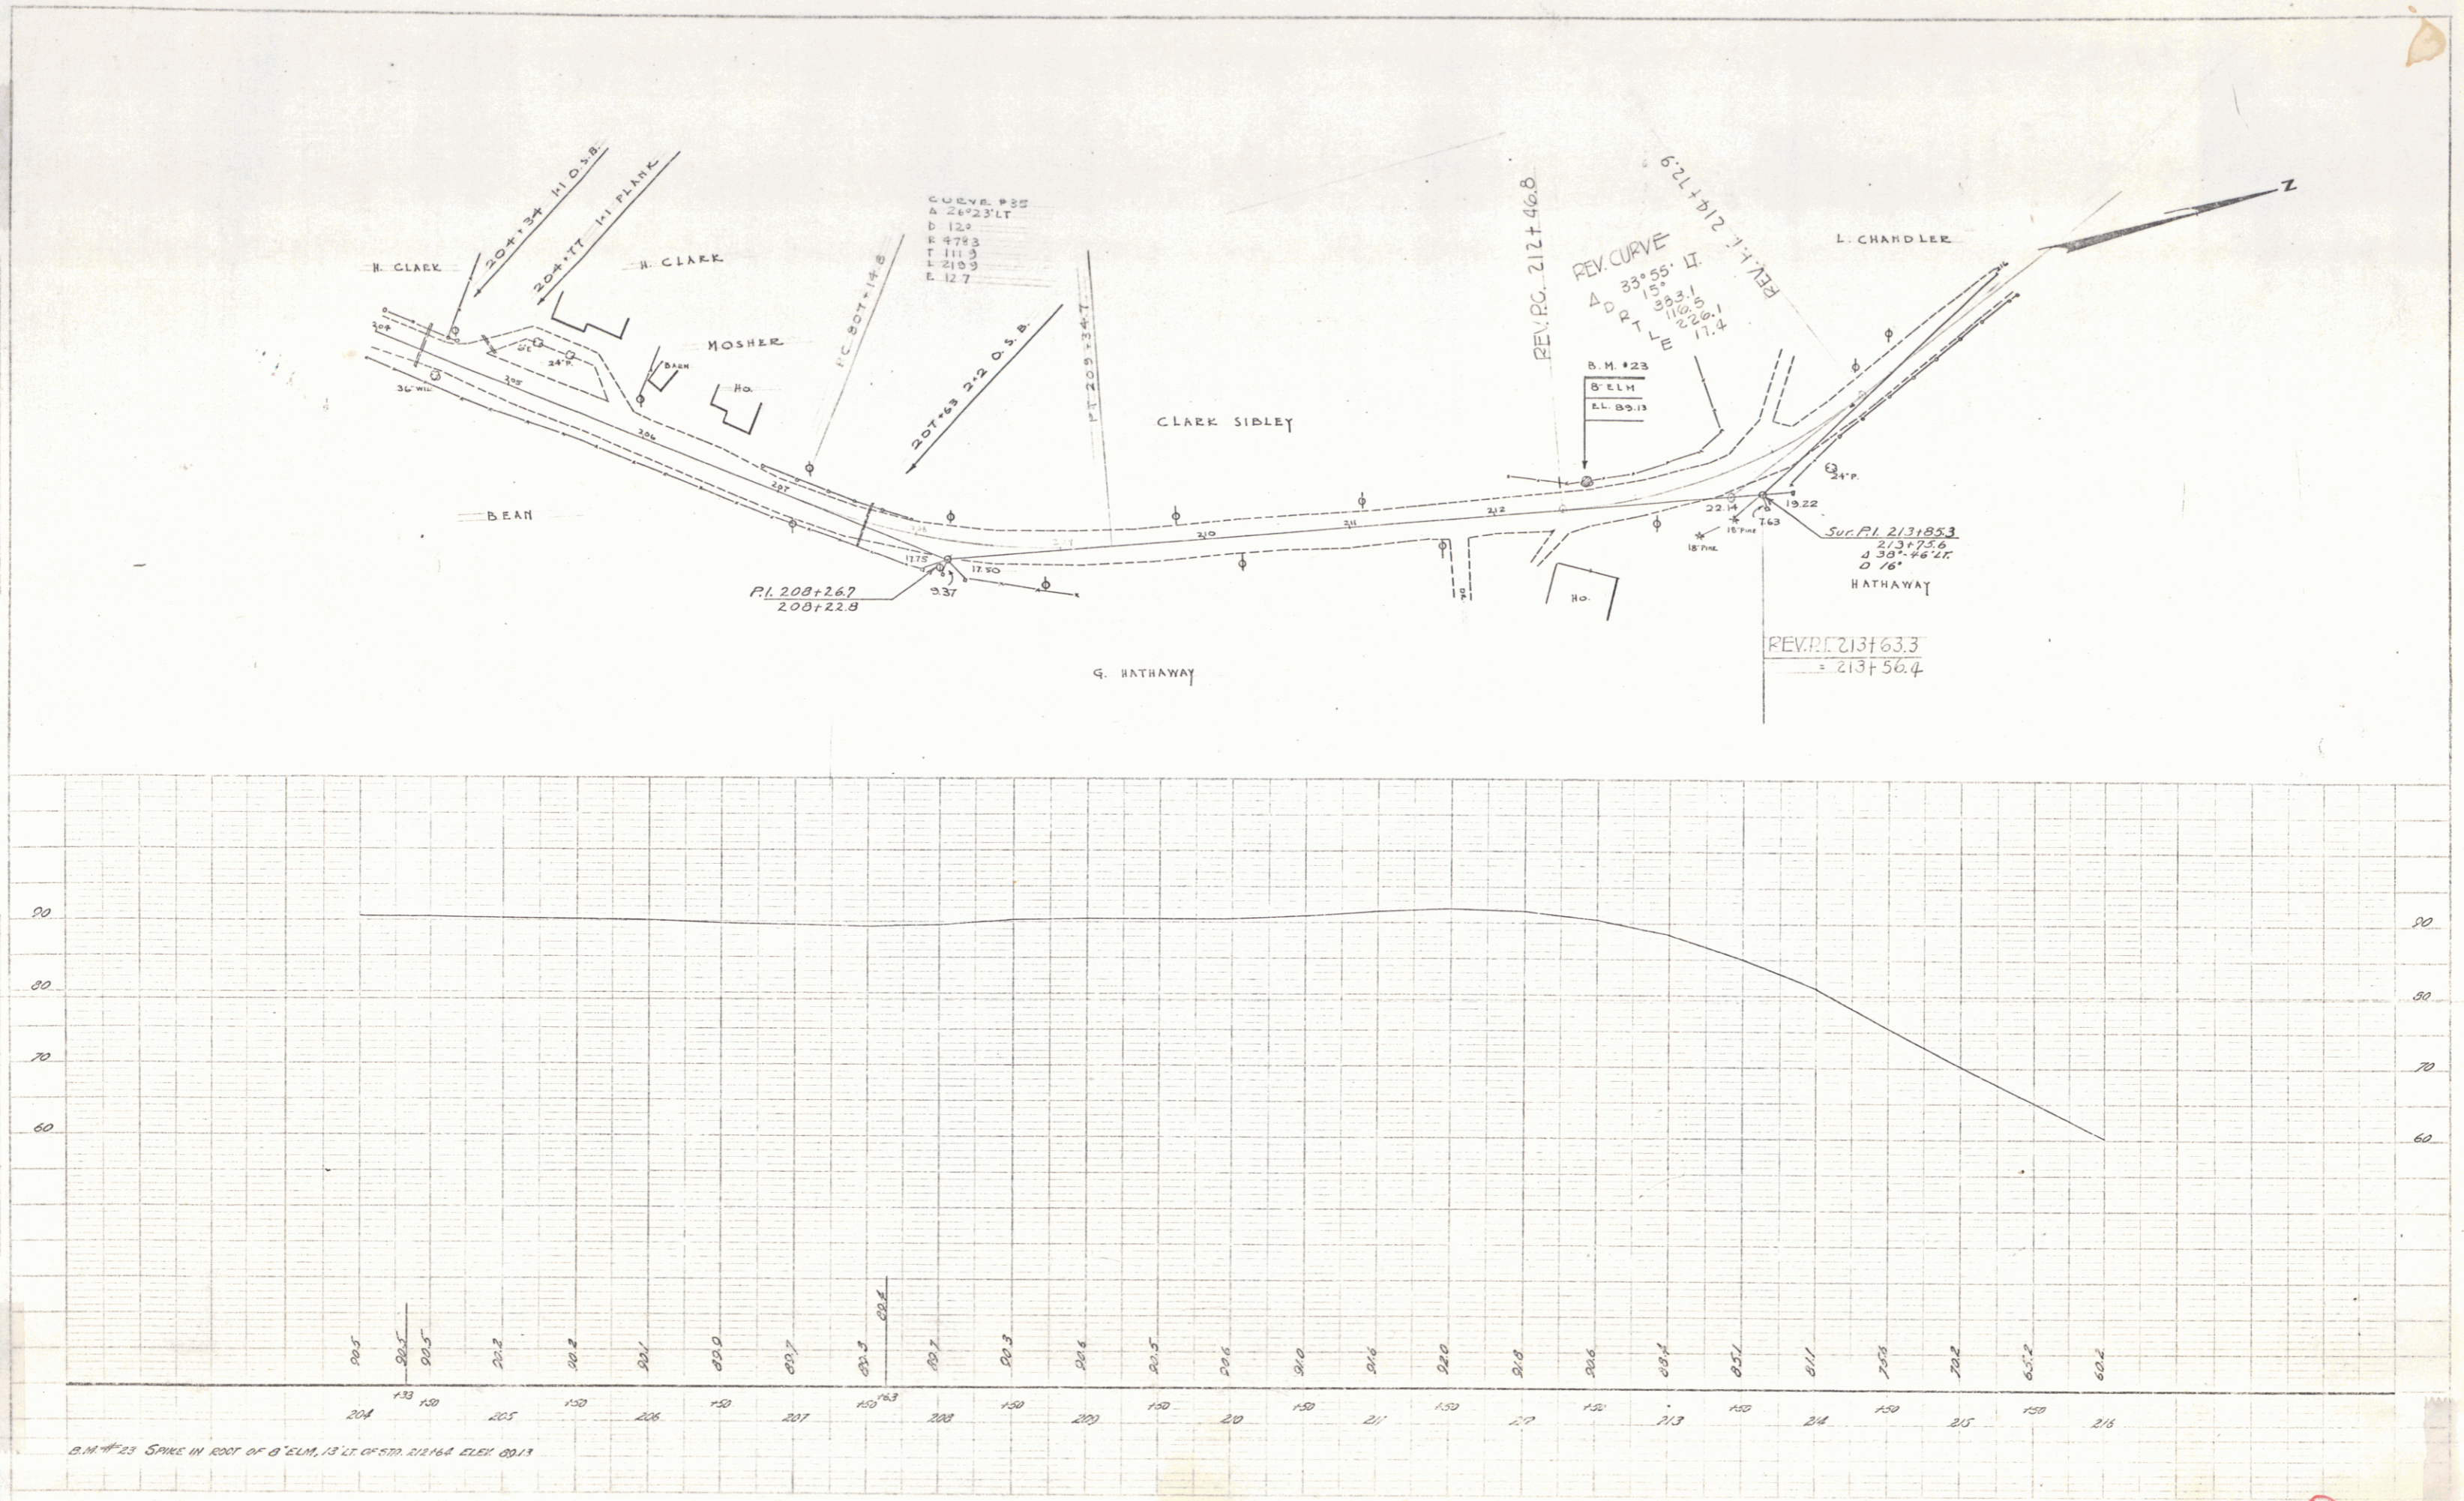

SHEET 19