


Note: Before going ahead with this about have Mr. Pursey check with Property Owner on his desire to give up this about
 May 1934

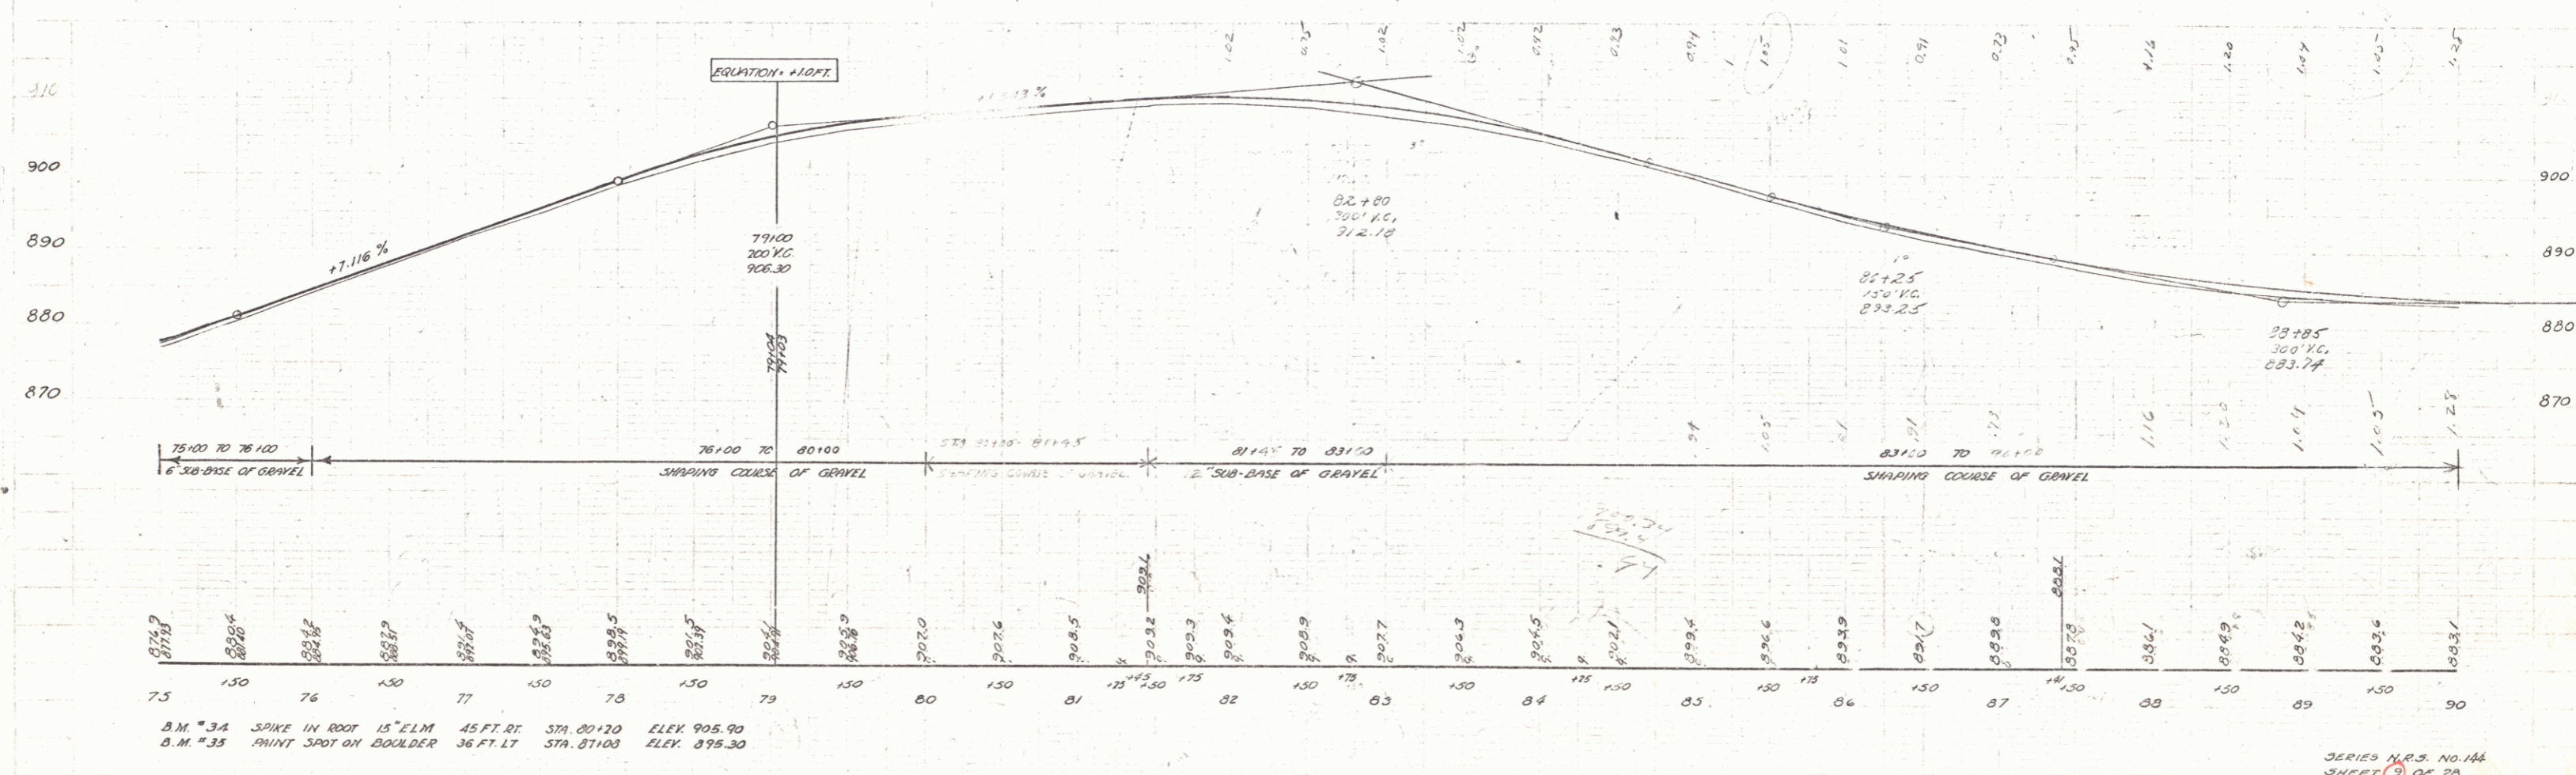

B.M. #34 SPIKE IN ROOT 15' ELM 45 FT. RT. STA. 80+20 ELEV. 905.90
 B.M. #35 PAINT SPOT ON BOULDER 36 FT. LT. STA. 87+00 ELEV. 875.30