
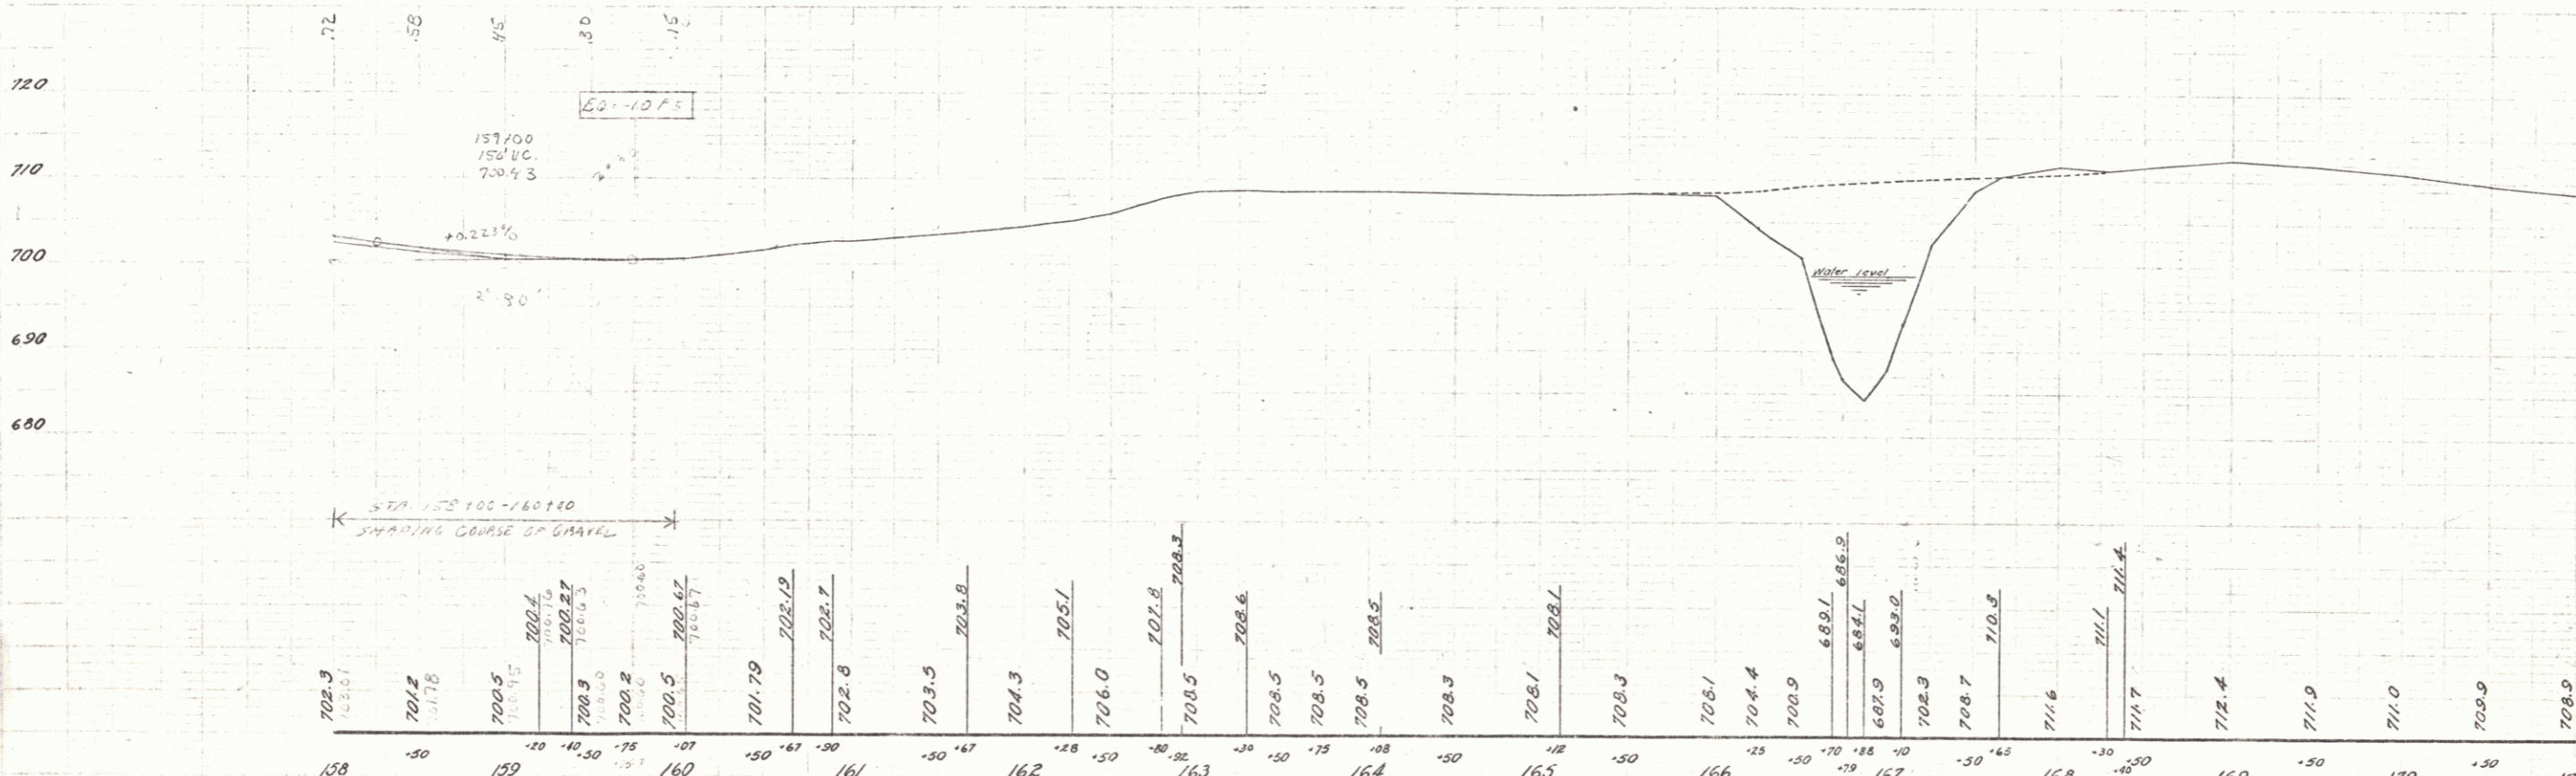


Hobson
Buckley
Griggs
REPLACED

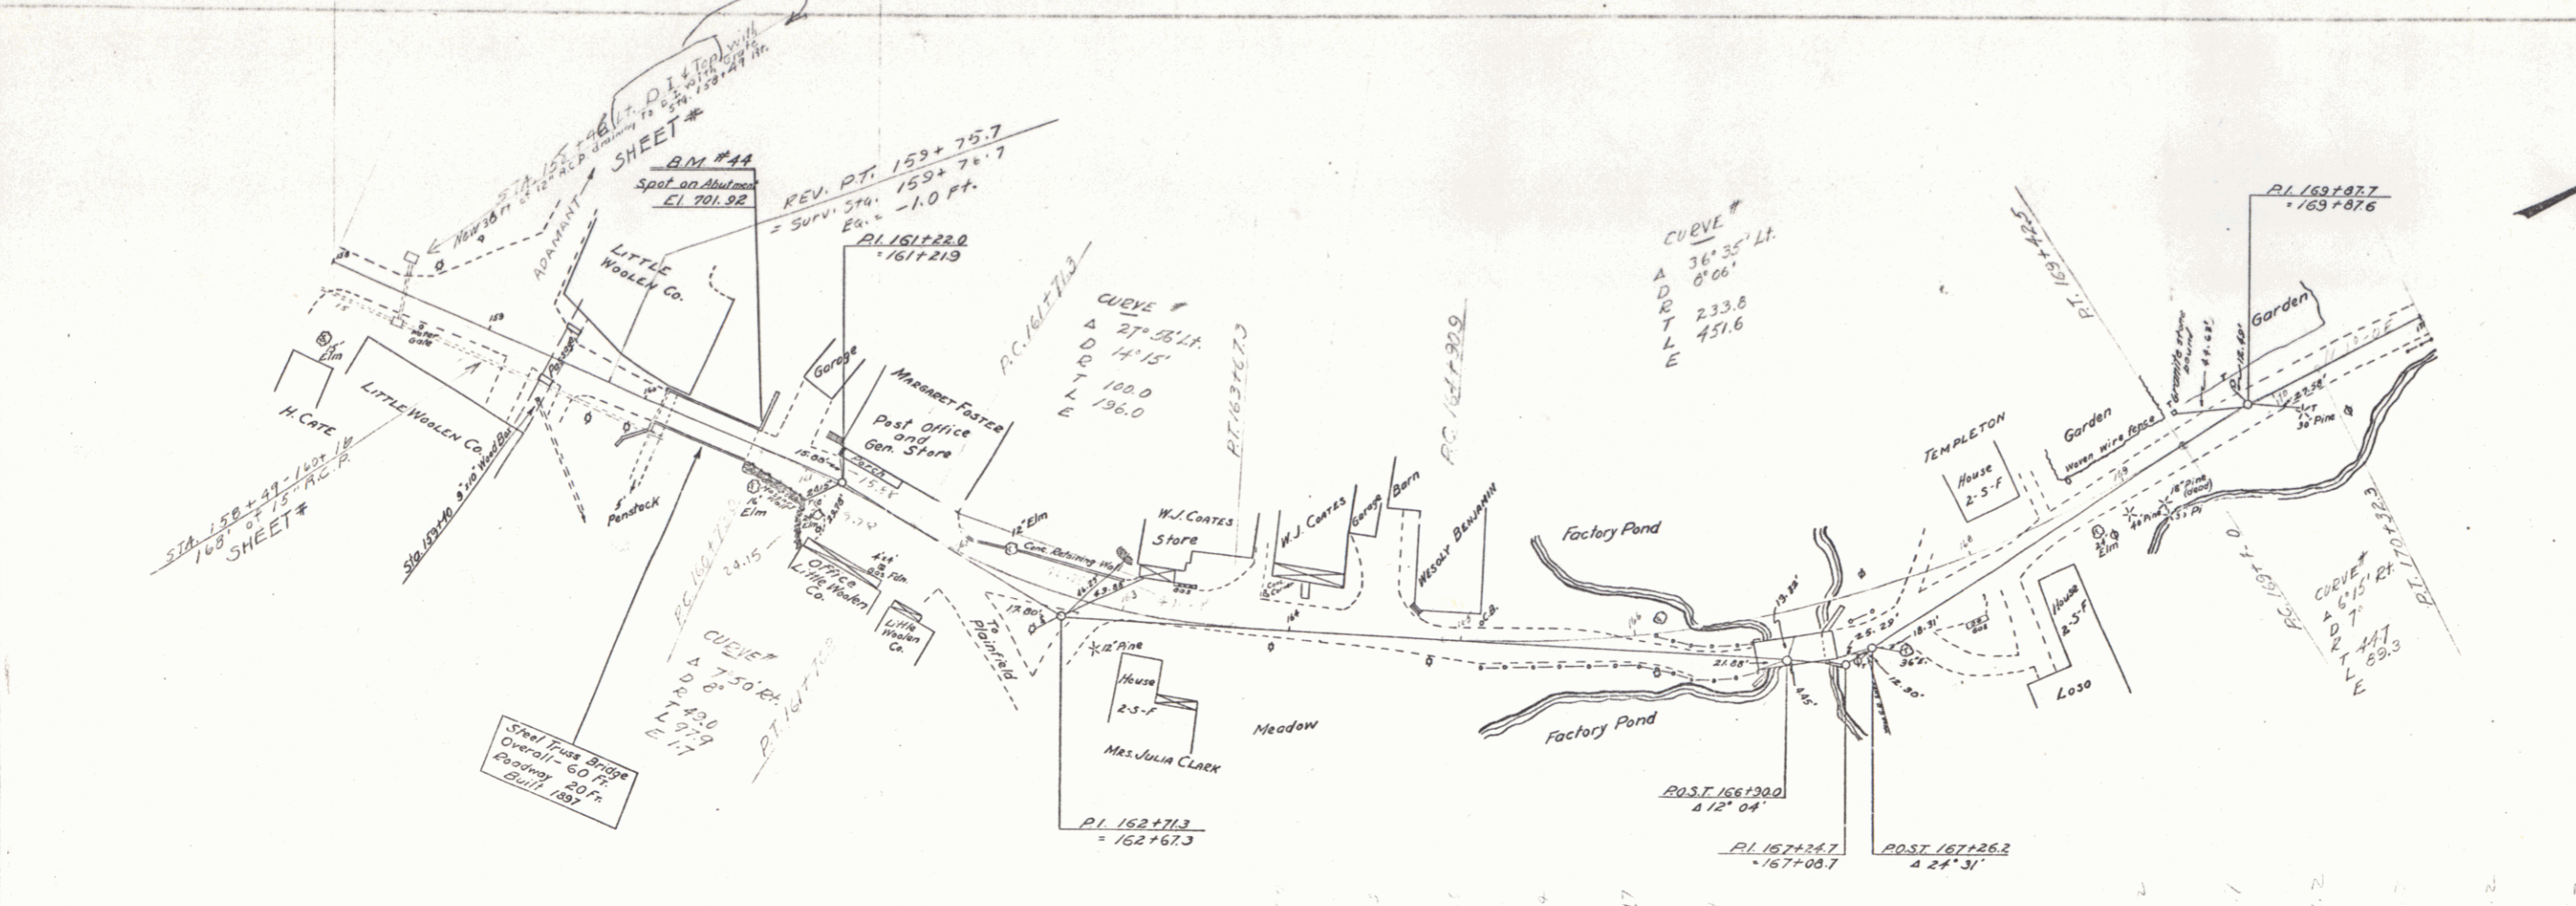

B.M. #44 Spot on Abut. 12 Ft. Lt. of Sta. 160+65.5 Elev. 701.92

SHEET 15

13