
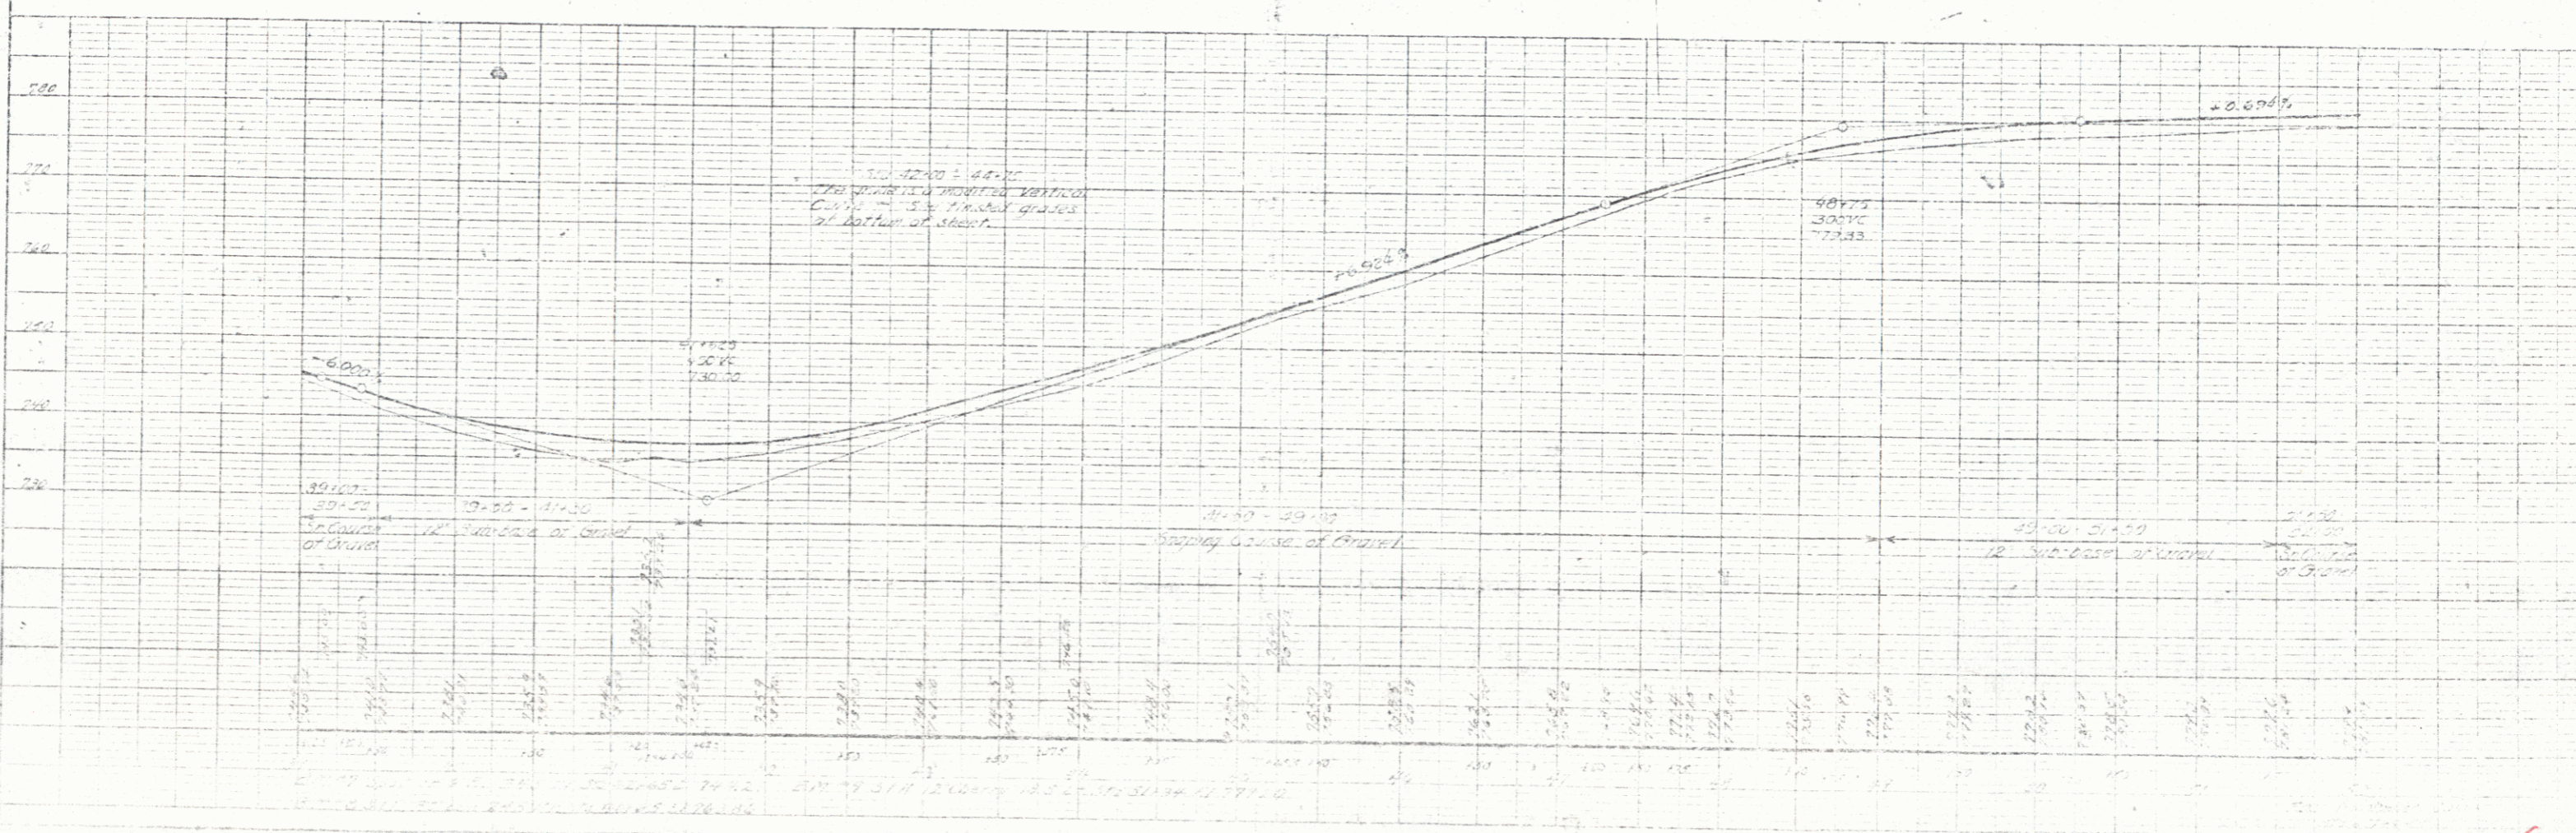


POOR ORIGINAL COPY

DATE	BY	REVISION
10-10-39	E. J.
10-4-39

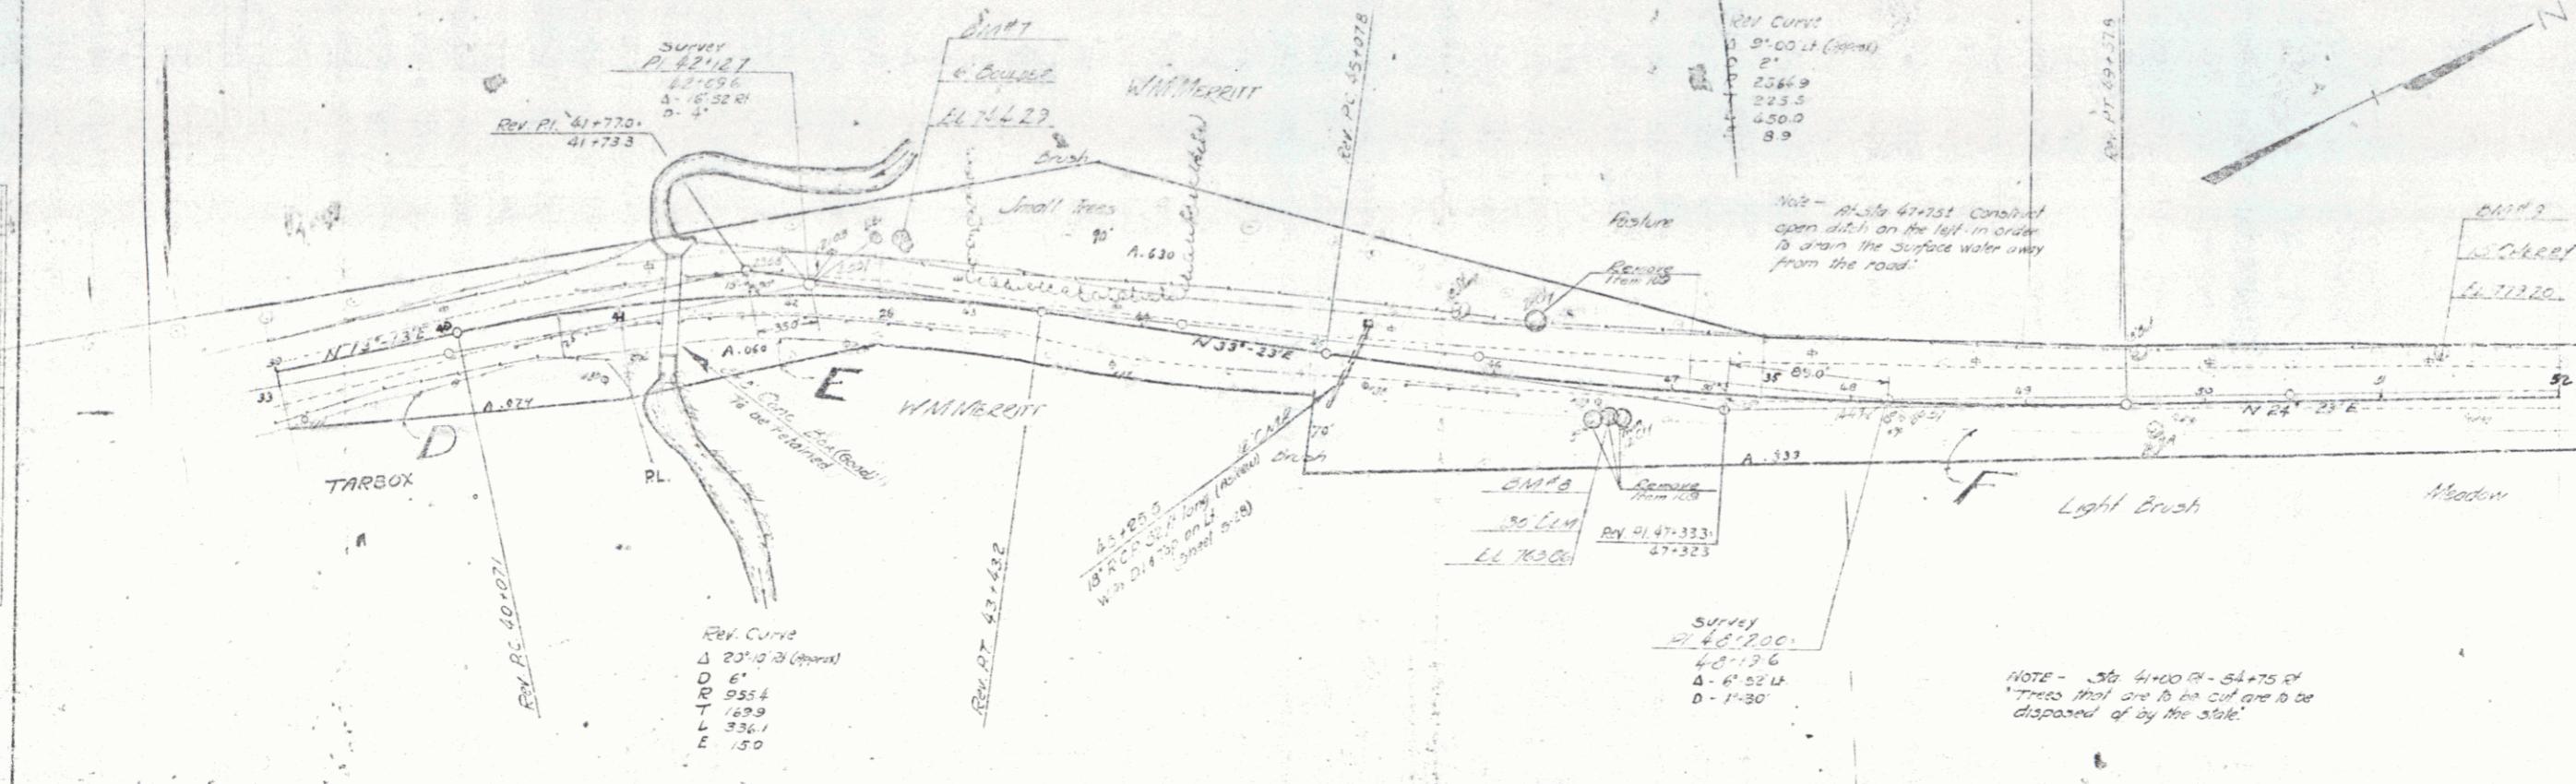

SHEET 4