
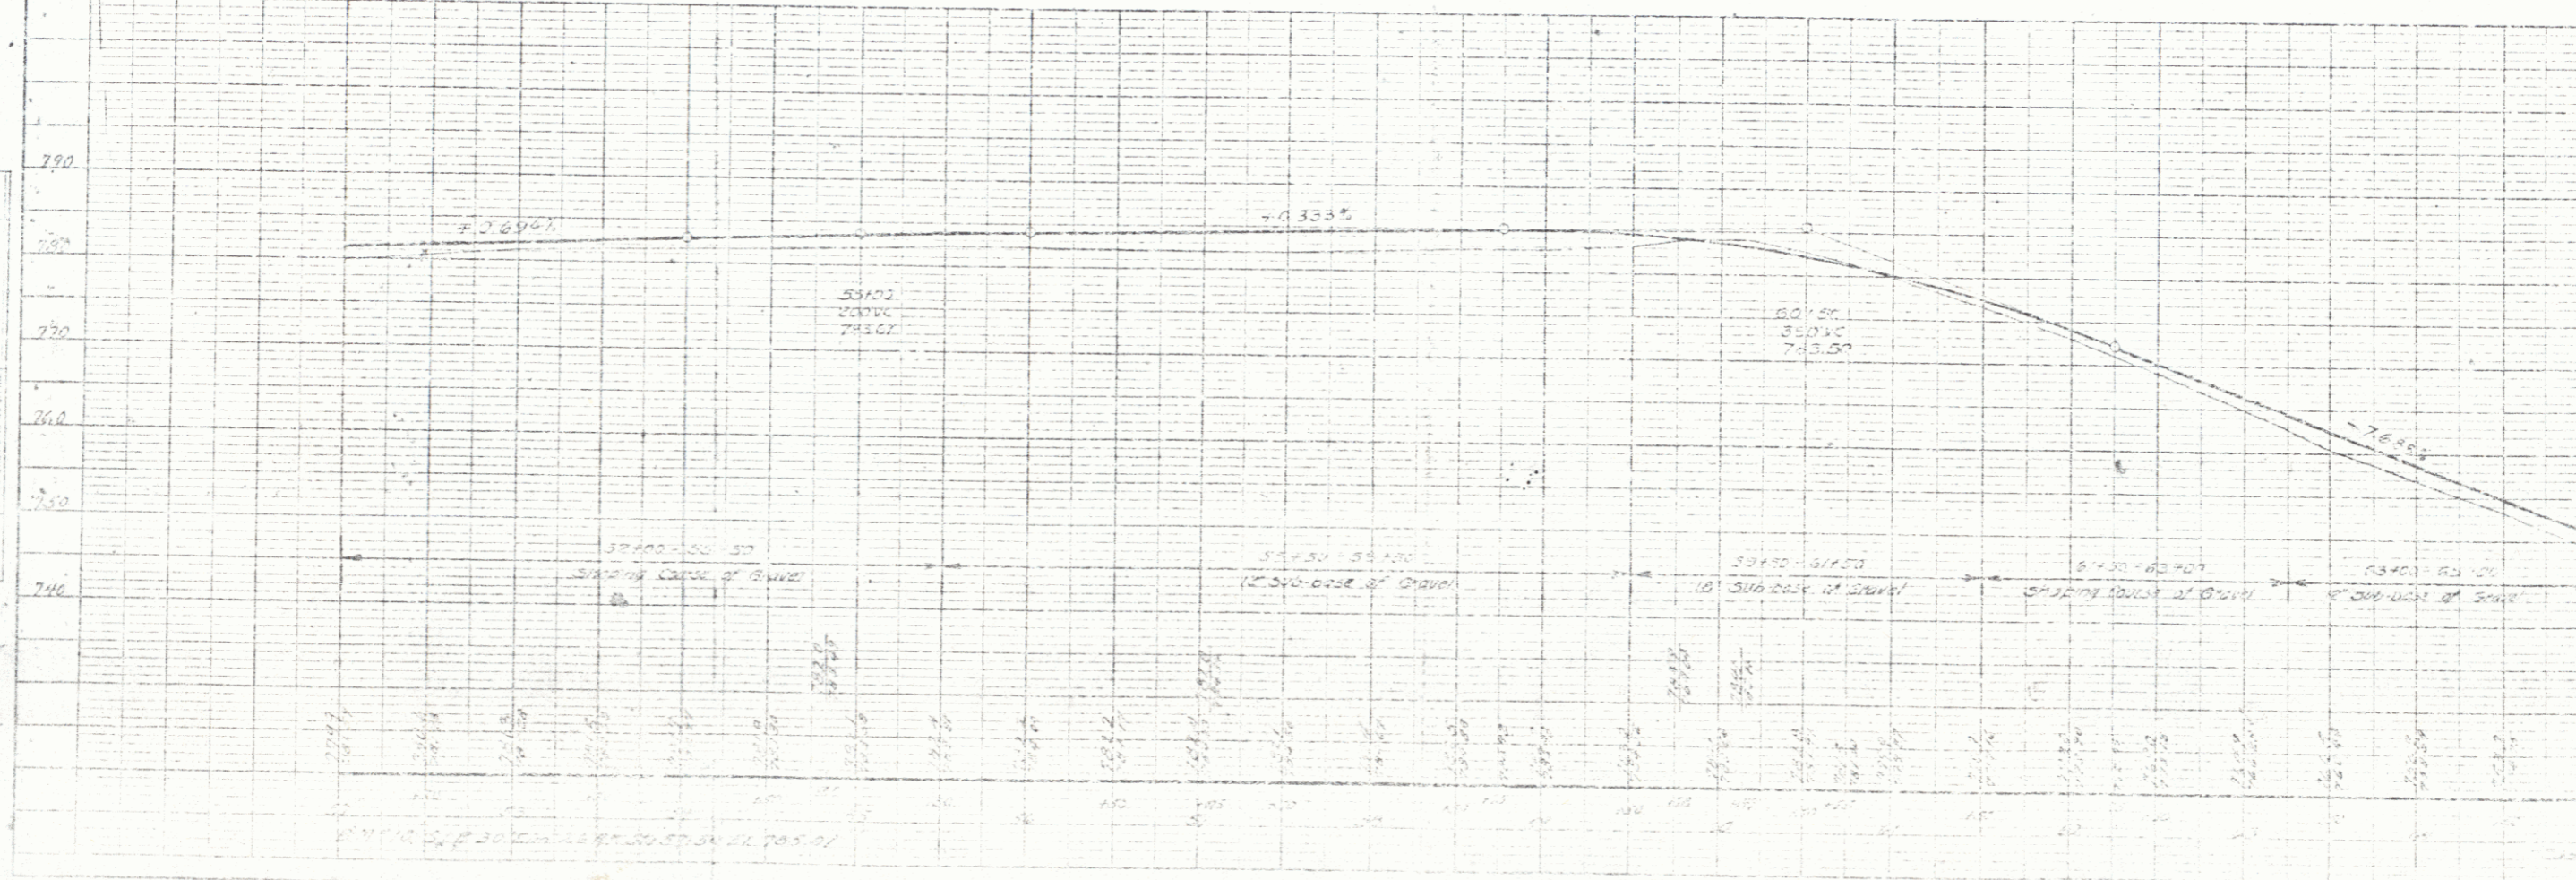


POOR ORIGINAL COPY.

| NO. | DATE | BY | REVISION |
|-----|---------|-------------------------|----------|
| 1 | 10-1-33 | W. H. L. & SONS INCORP. | PLAN |
| 2 | 10-1-33 | W. H. L. & SONS INCORP. | PLAN |

REV. CURVES
 3 - 2120 (Approx)
 4 - 1'
 5 - 2760
 6 - 1250
 7 - 2500
 8 - 14

| | | |
|------|------|----|
| PLAN | DATE | BY |
| | | |

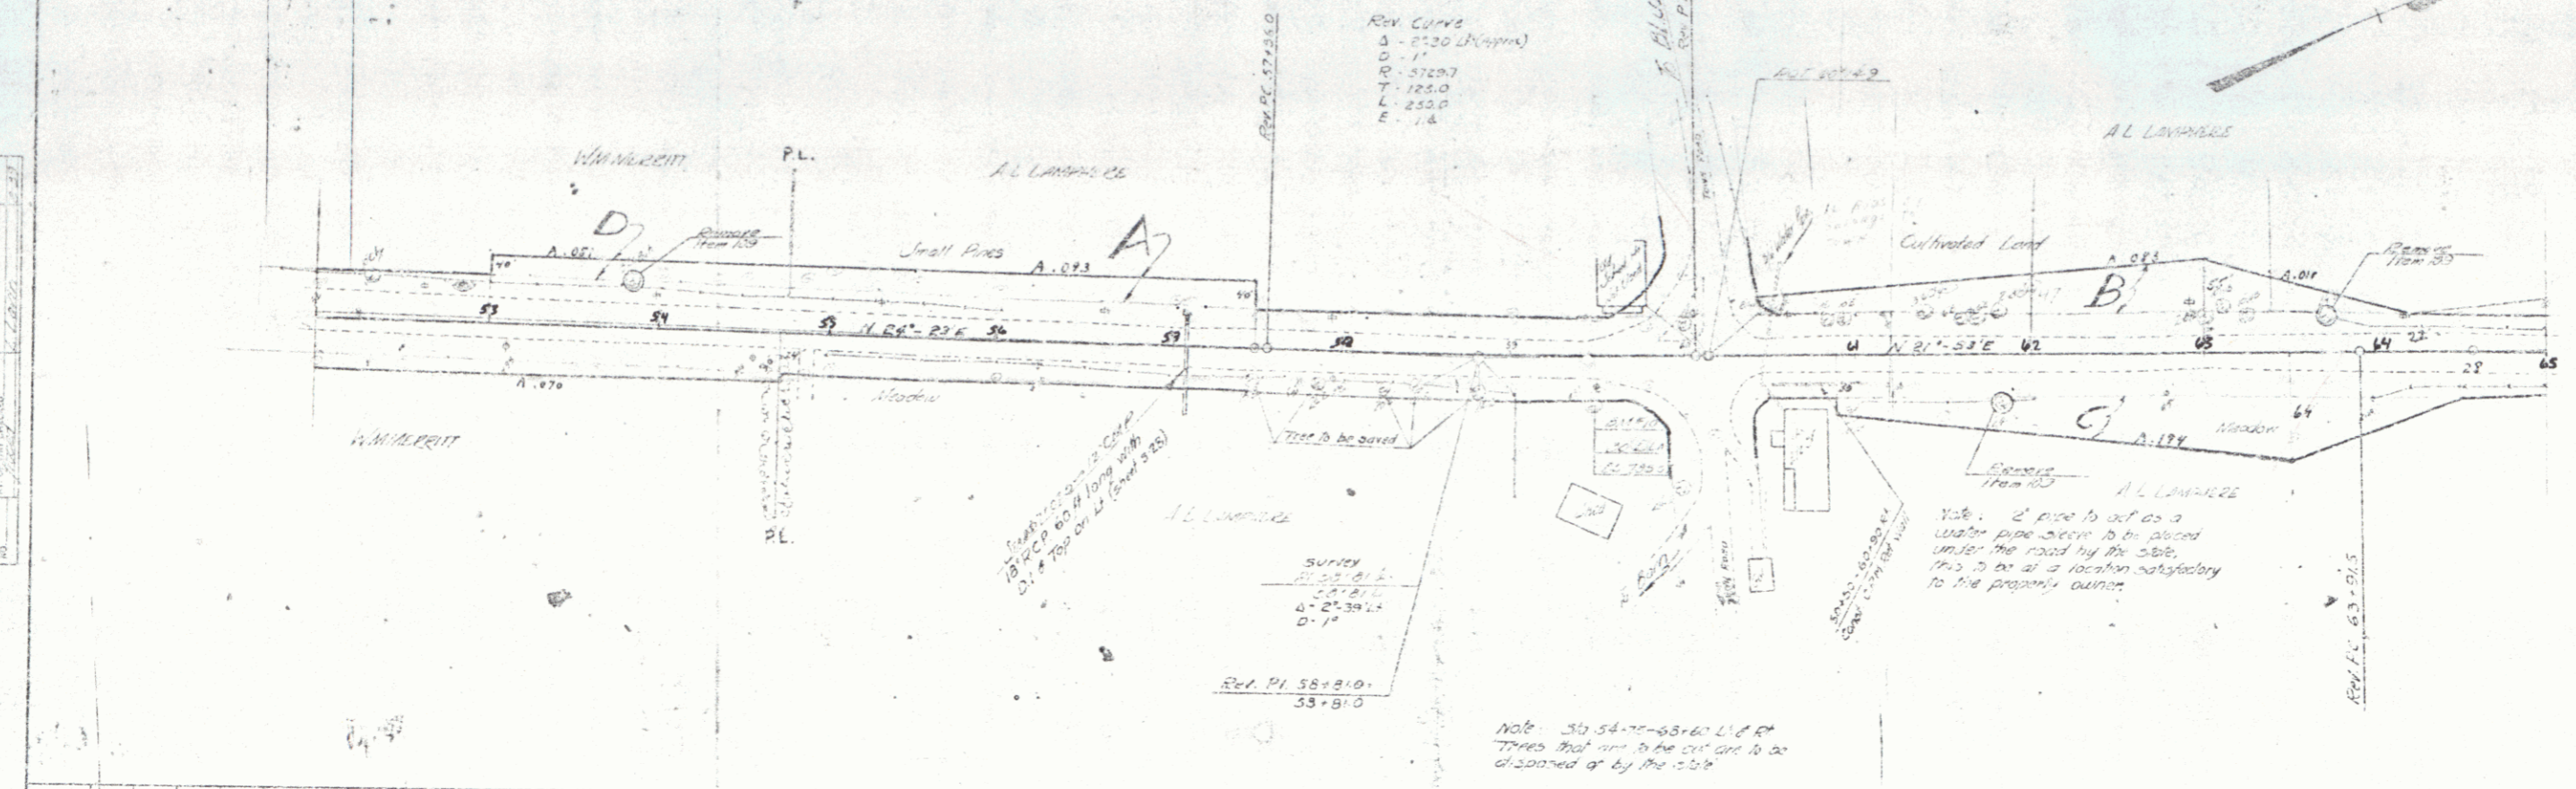

SHEET 5

5