


POOR ORIGINAL COPY

PLAN
 1/4" = 100'
 1/8" = 50'
 1/16" = 25'

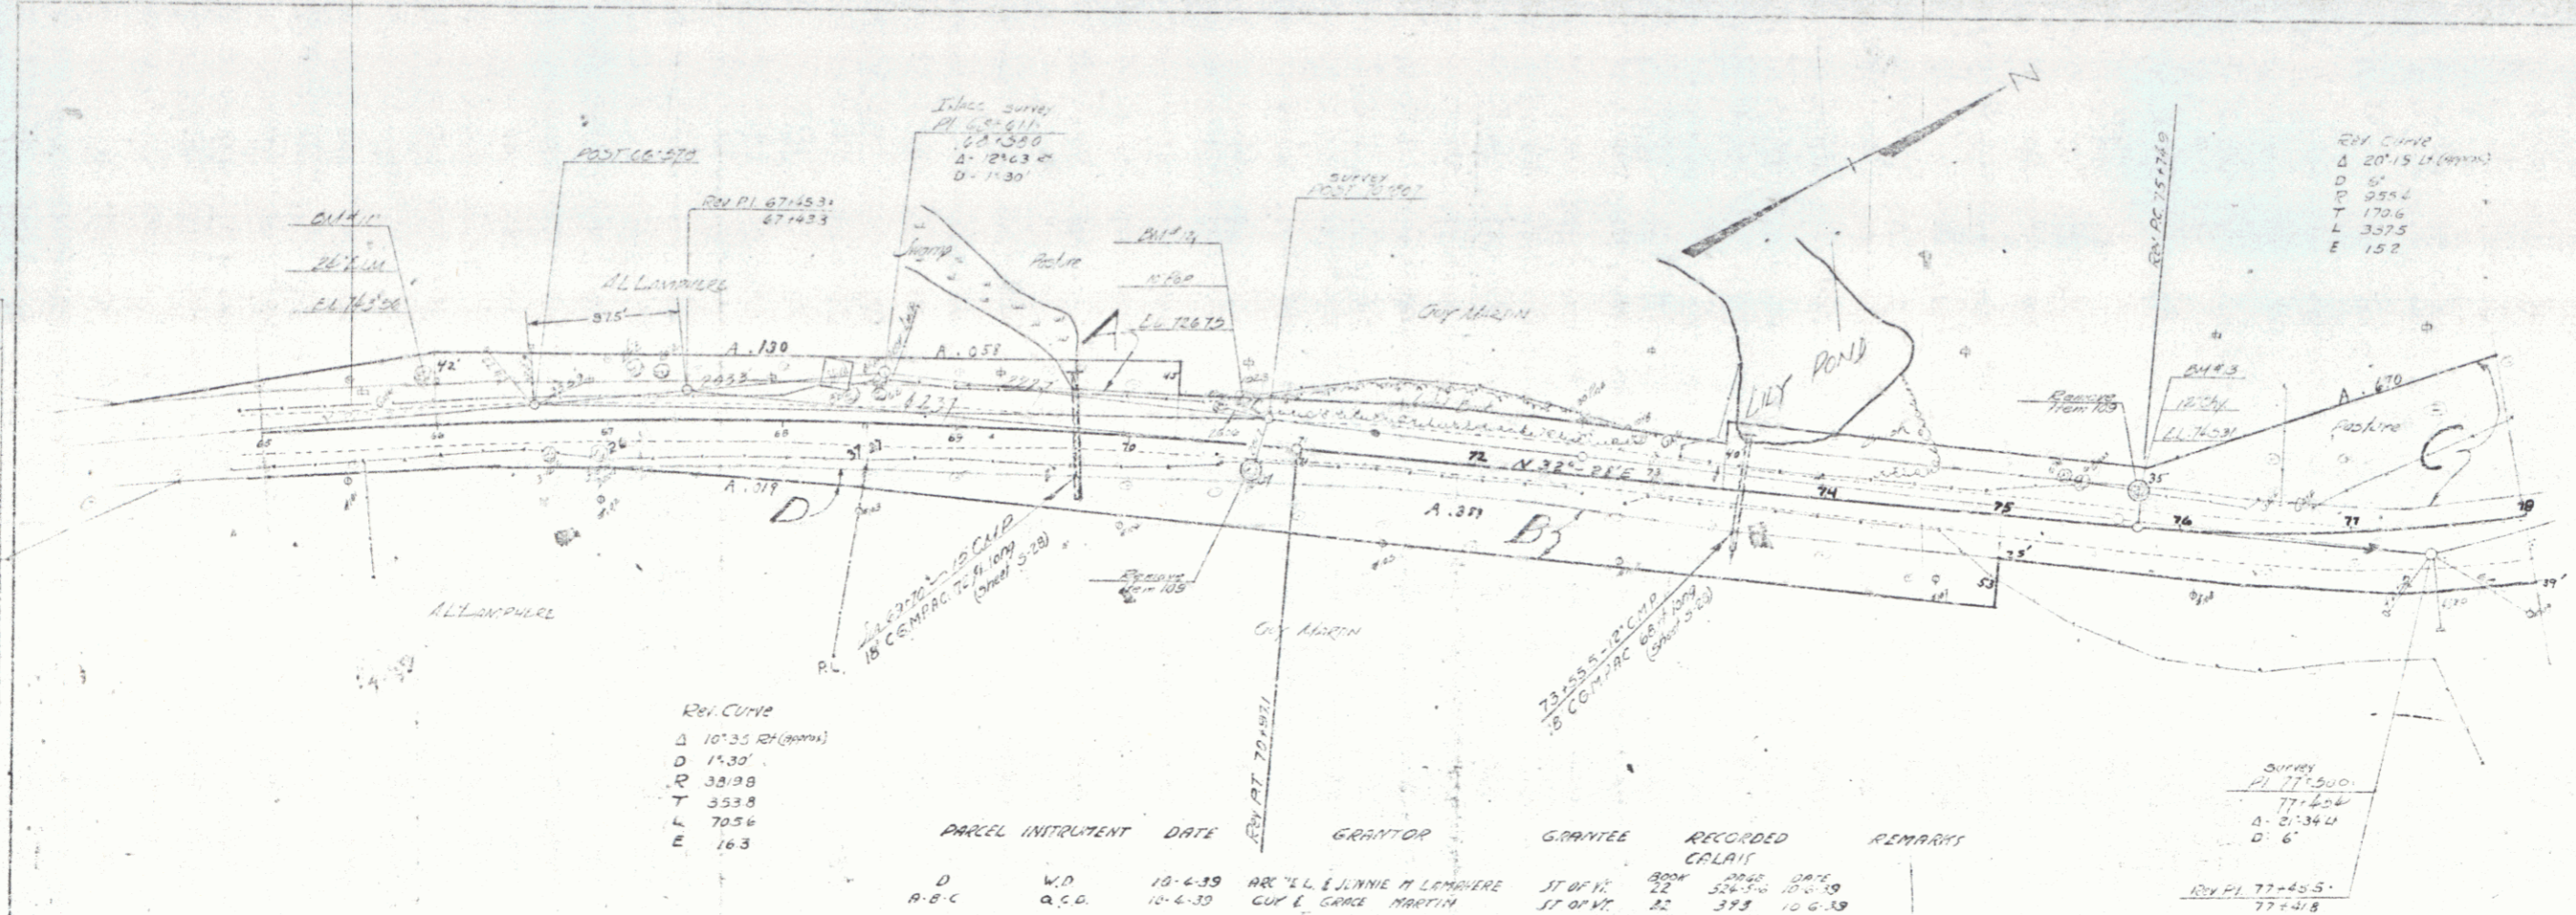


REV. CURVE
 Δ 101.35 21 (approx)
 D 15.30'
 R 381.98
 T 353.8
 L 705.6
 E 16.3

REV. CURVE
 Δ 201.15 21 (approx)
 D 5'
 R 355.4
 T 170.6
 L 357.5
 E 15.2

PARCEL	INTRUSION	DATE	GRANTOR	GRANTEE	RECORDED	REMARKS
D	W.D.	10-6-39	AR & L LYNNE H LEMBIERE	ST OF VT	BOOK 22 PAGE 524	10-6-39
A-B-C	Q.C.D.	10-6-39	CUP & CAROL MARTIN	ST OF VT	BOOK 22 PAGE 528	10-6-39

REV. CURVE
 Δ 111.50
 D 31.34
 R 77.48

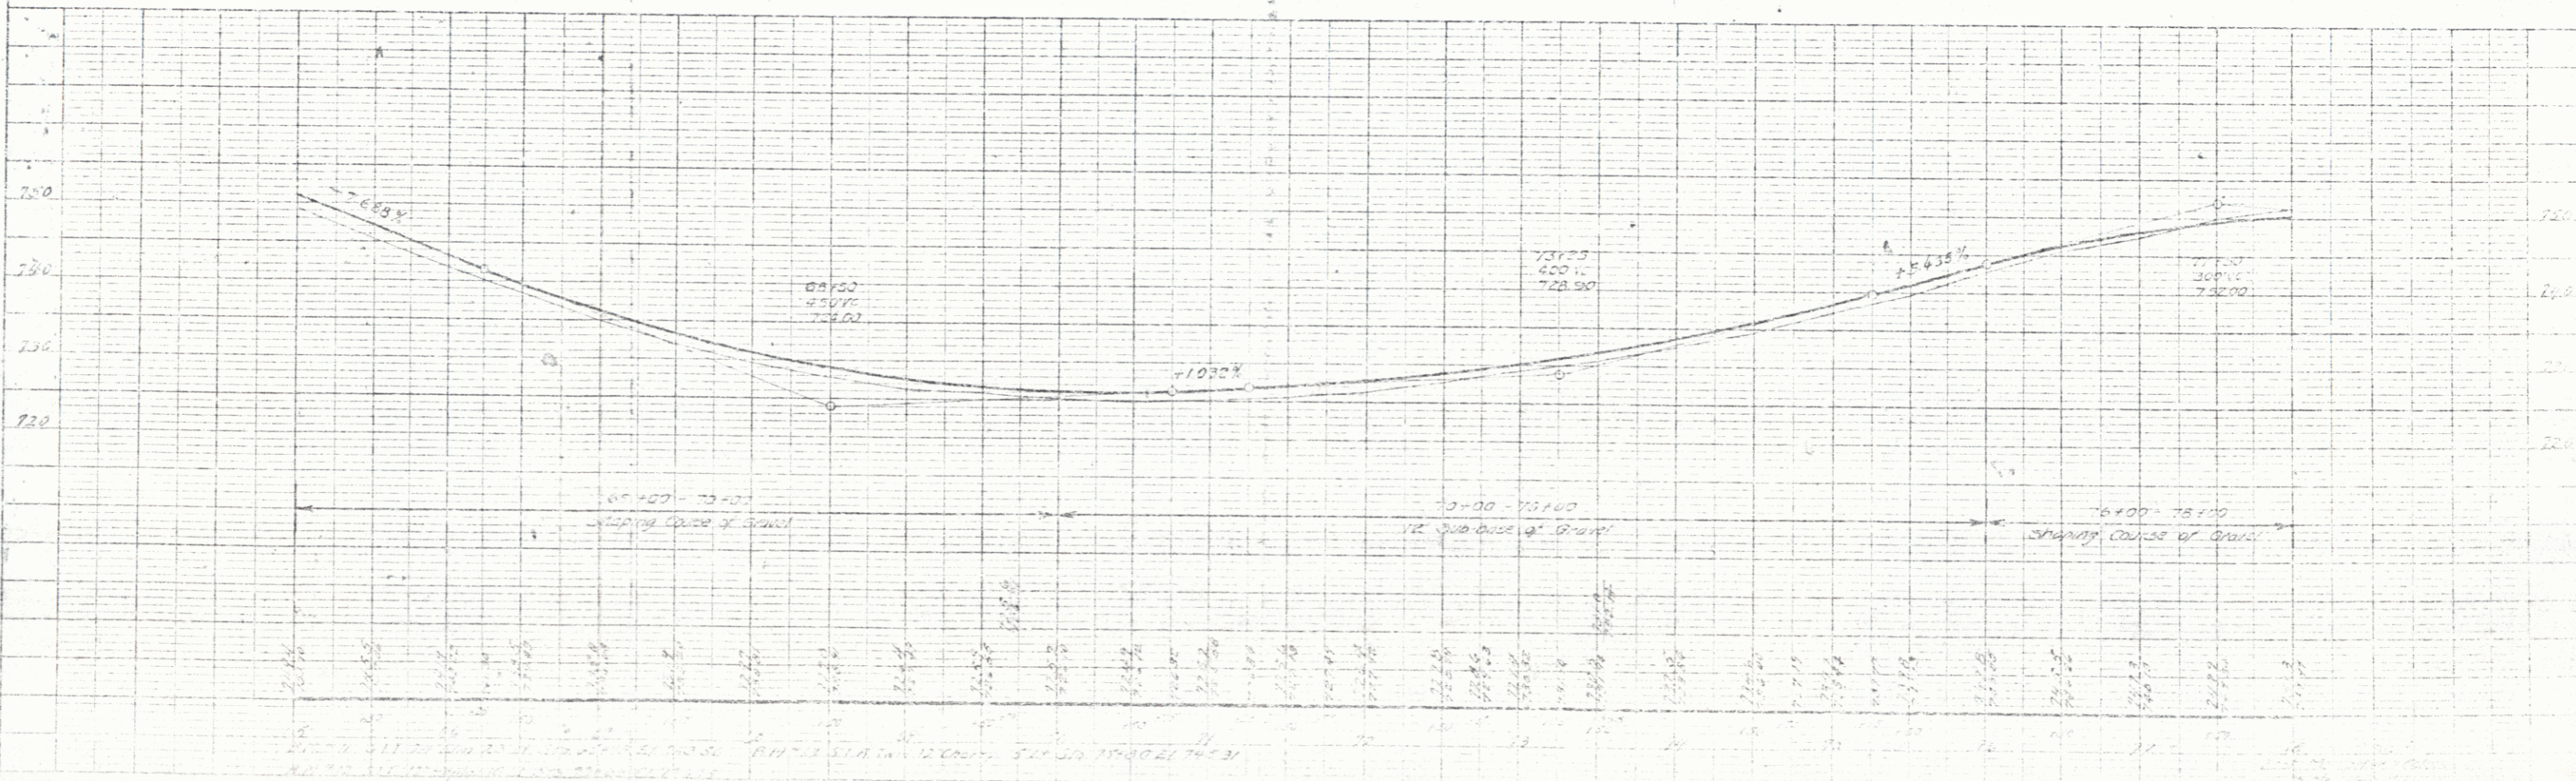

1/8" = 10'
 1/16" = 5'