
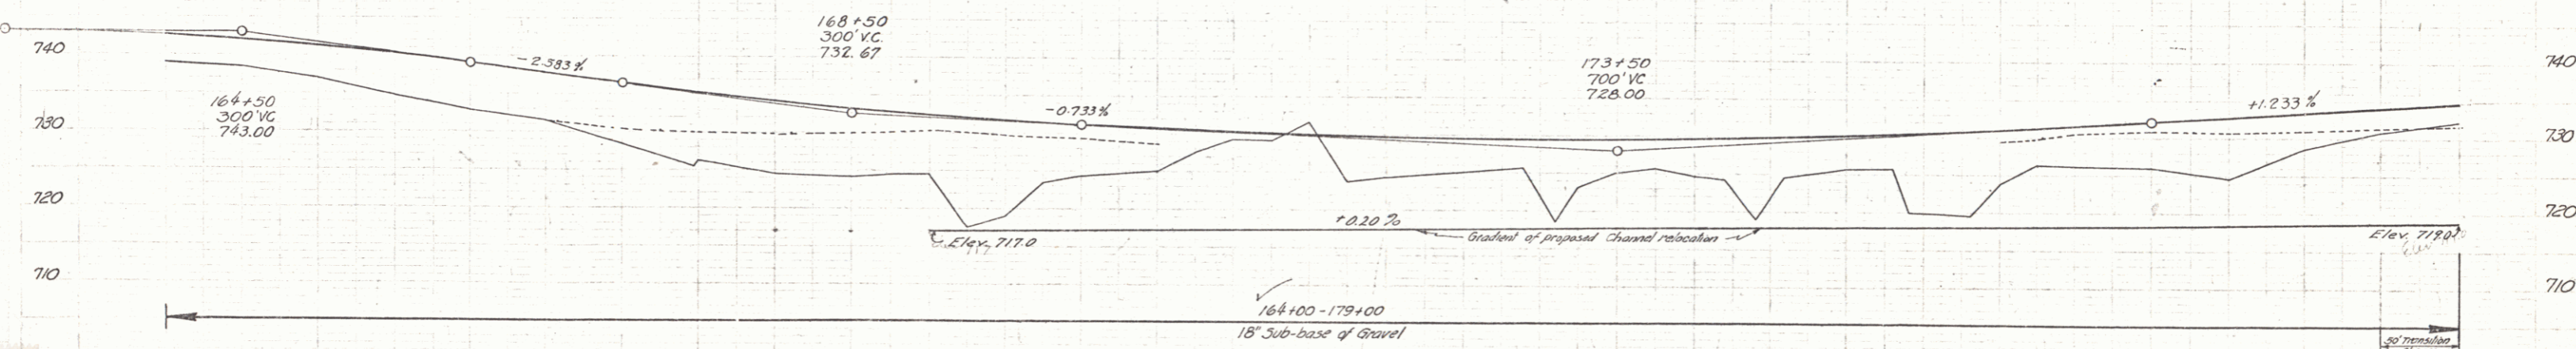


PARCEL	INSTRUMENT	DATE	GRANTOR	GRANTEE	RECORDED	REMARKS
A	W.D.O.E.	6-5-41	LEON LELIBIRDIE TUCKER	ST OF 17	23	372 10-16-41
A	W.D.O.E.	6-5-41	M. GUY L. CHRISTINE GEORGE	ST OF 17	23	374 10-16-41

Clearing & Grubbing - Item 13
 Rt. of Sta 168+00 - Sta 180+00

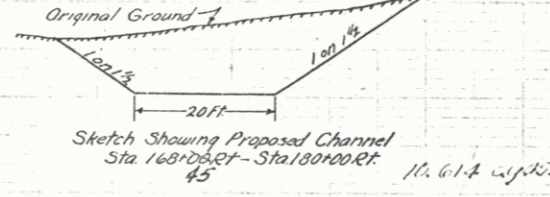

Station	Elevation
164	739.0
165	738.0
166	737.0
167	736.0
168	735.0
169	734.0
170	733.0
171	732.0
172	731.0
173	730.0
174	729.0
175	728.0
176	727.0
177	726.0
178	725.0
179	724.0

BM#27 51R 15" YB 43' LT Sta 167A39 Elev 735.50
 BM#29 51R 12" Pine 200' LT Sta 174A29 Elev 732.70

Calais
 Series ST. No 144 P
 Sheet 5 of 84 Sheets.