


PARCEL INSTRUMENT	DATE	GRANTOR	GRANTEE	RECORDED BOOK PAGE	REMARKS
B	W.O.G.E. 6-17-41	NINA DAILEY	ST OF VT	23 377	10-16-41 CULY INLET

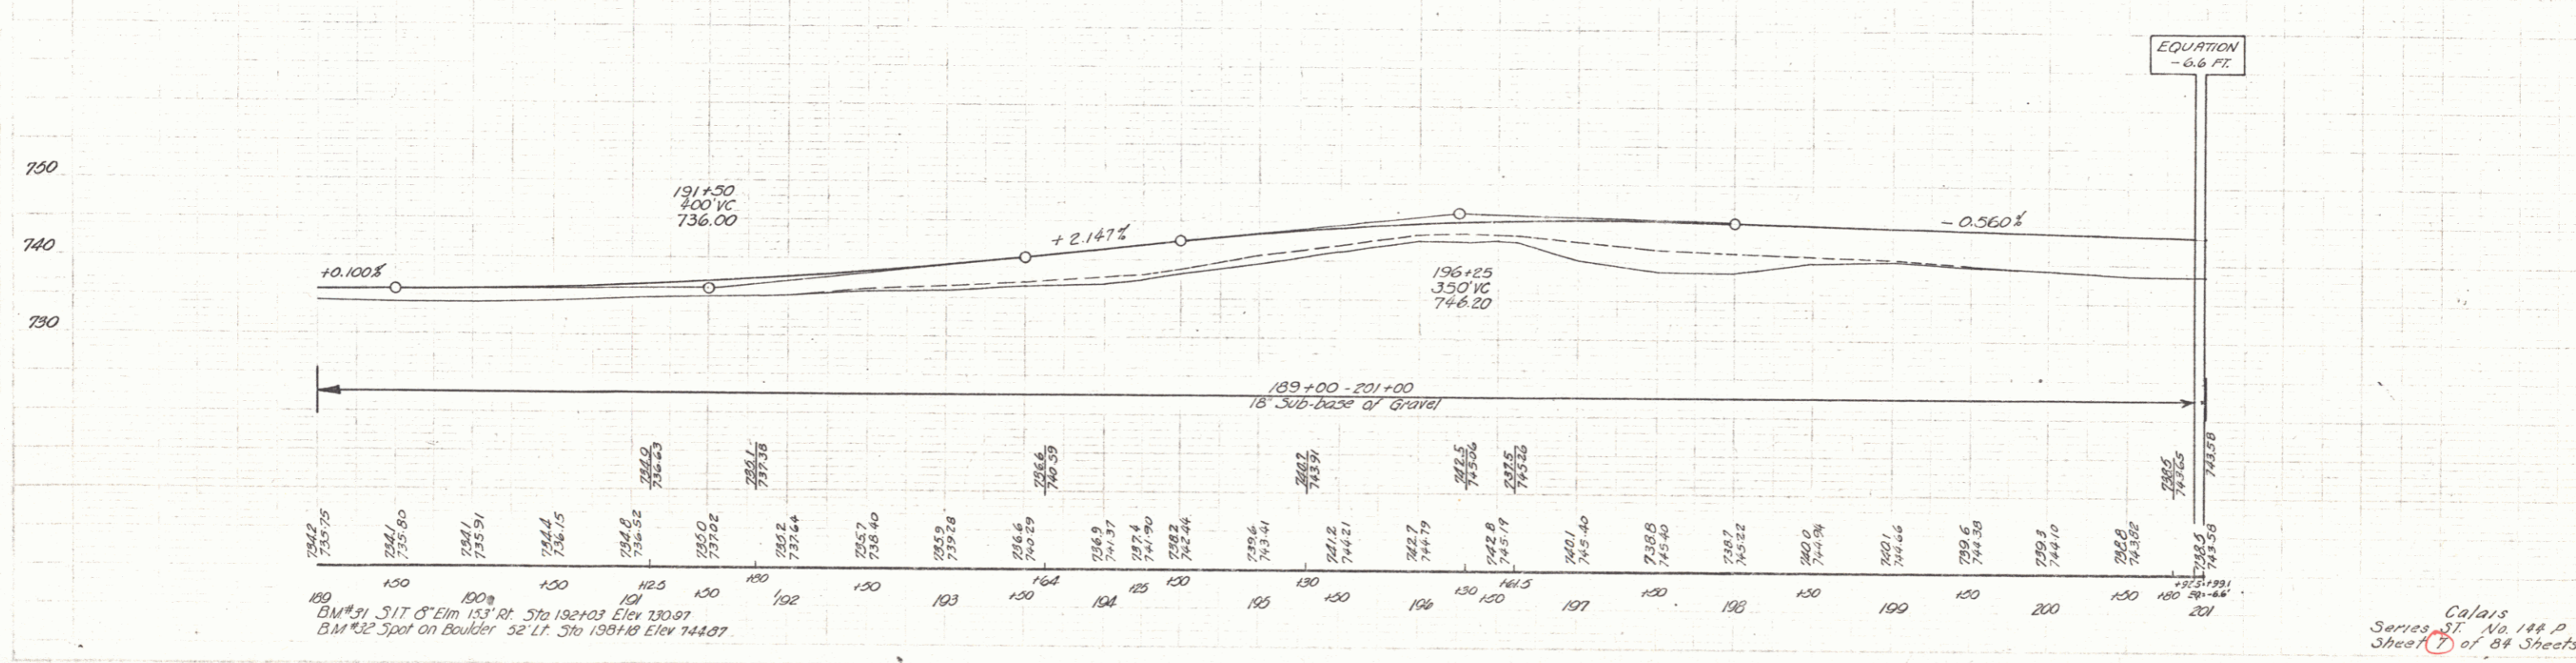

BM #31 S1T 0° Eim 153' RT Sta 192+03 Elev 110.97
 BM #32 Spot on Boulder 52' Lt. Sta 199+18 Elev 744.87

Calais Series ST No 144 P Sheet 7 of 84 Sheets