
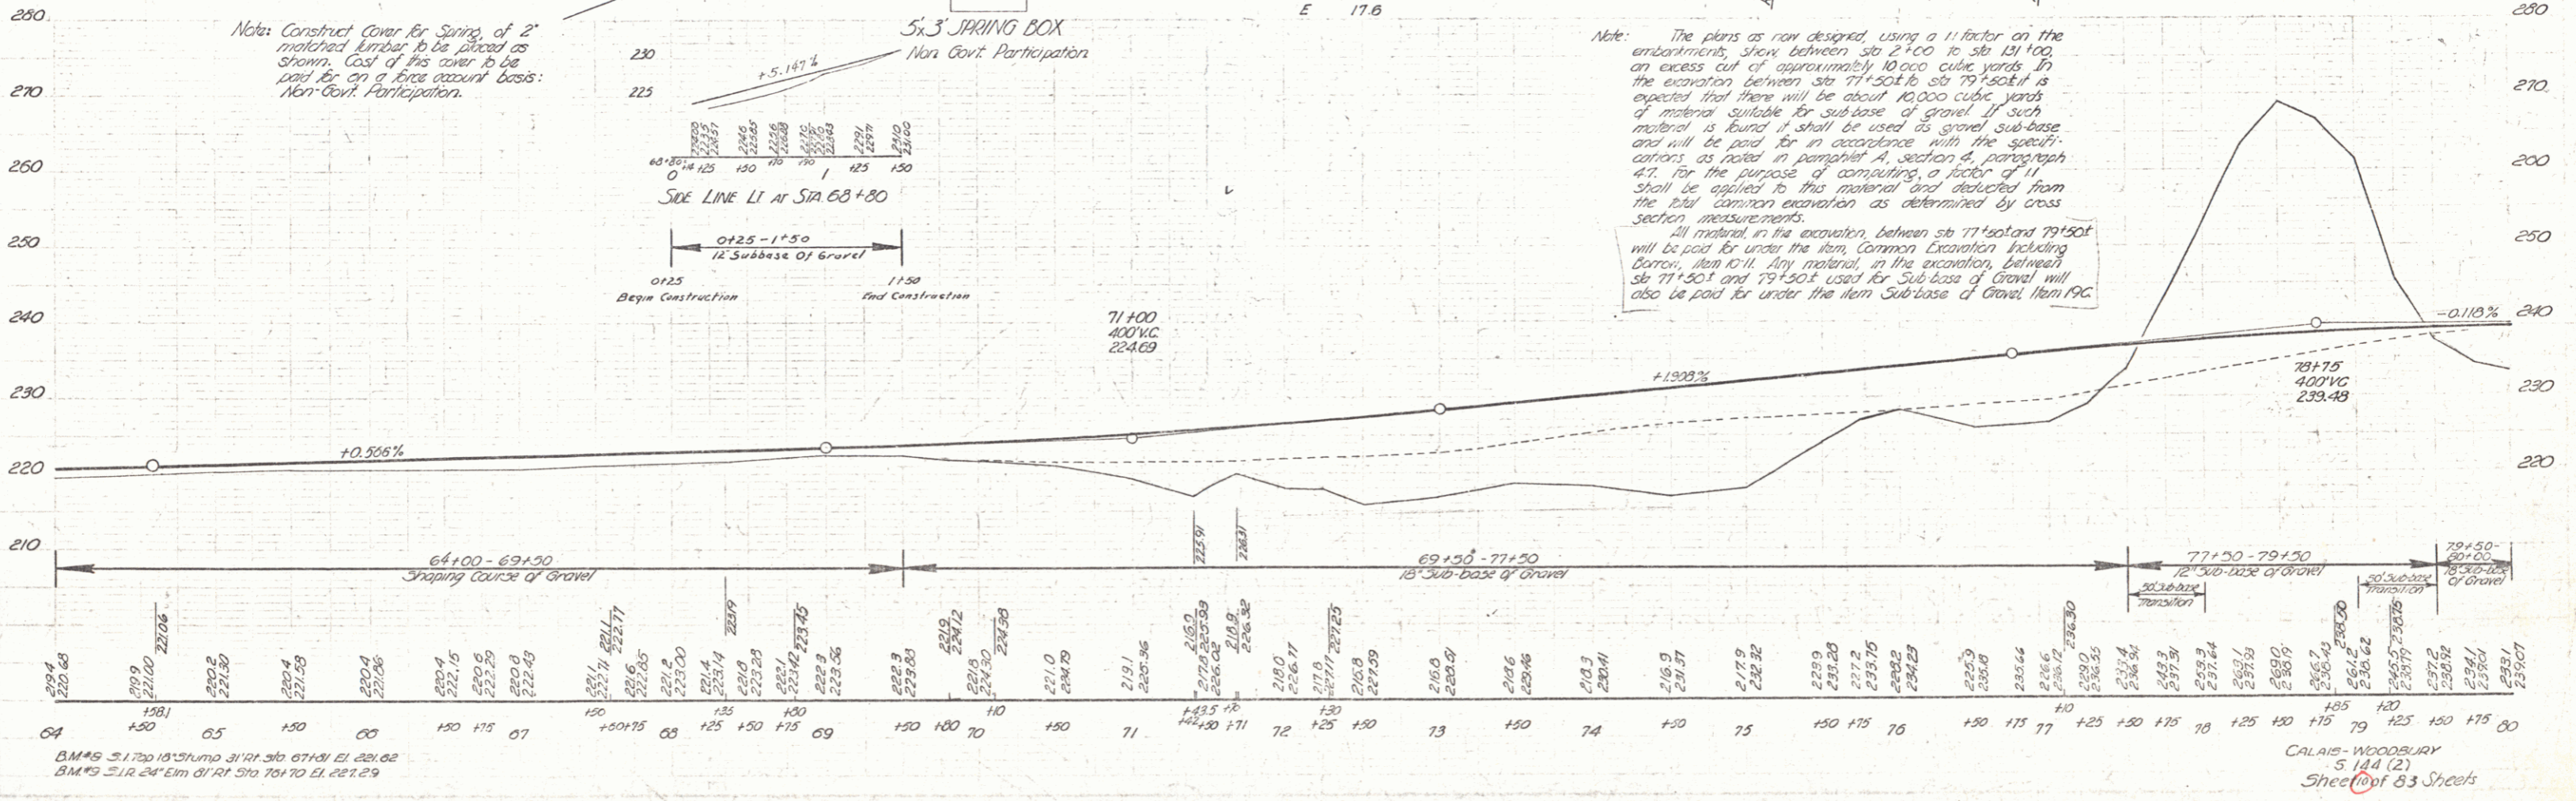


PARCEL INSTRUMENT	DATE	GRANTOR	GRANTEE	RECORDED	REMARKS
A, B	W.D.O.E	8-17-43	ALDOR E. & RUTH E. ROY	BOOK PAGE DATE	
A'	CONDONE	9-9-43	D. W. WILBER	5T OF VT 23 422 9-18-43	
				5T OF VT 23 403-04 9-18-43	

144(2) 1946 10 B3

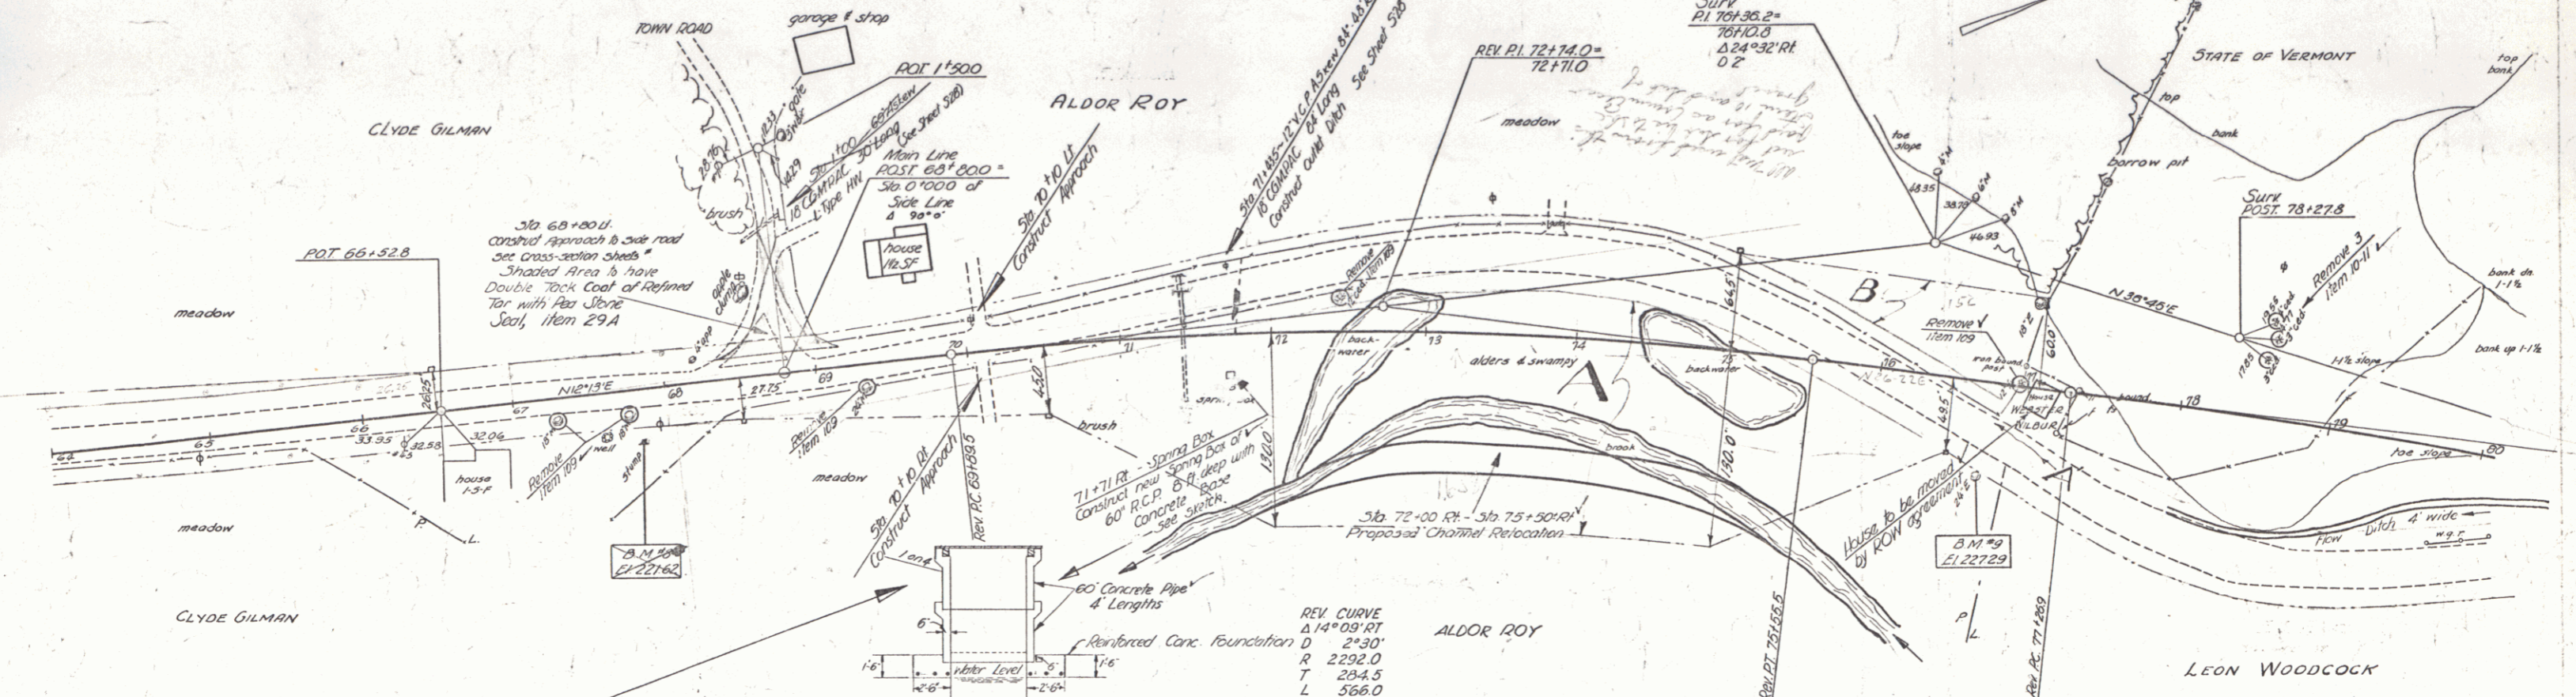

1/4" = 100' (Horizontal)  
 1/4" = 10' (Vertical)

1/4" = 10' (Vertical)

B.M. 15 21.720 15.511 m 31.71 310 07141 El. 221.62  
 B.M. 16 31.12 24' Elm 01' RT Sta 76+70 El. 227.29

CALAIS-WOODBURY  
 5 144 (2)  
 Sheet No. 83 Sheets