
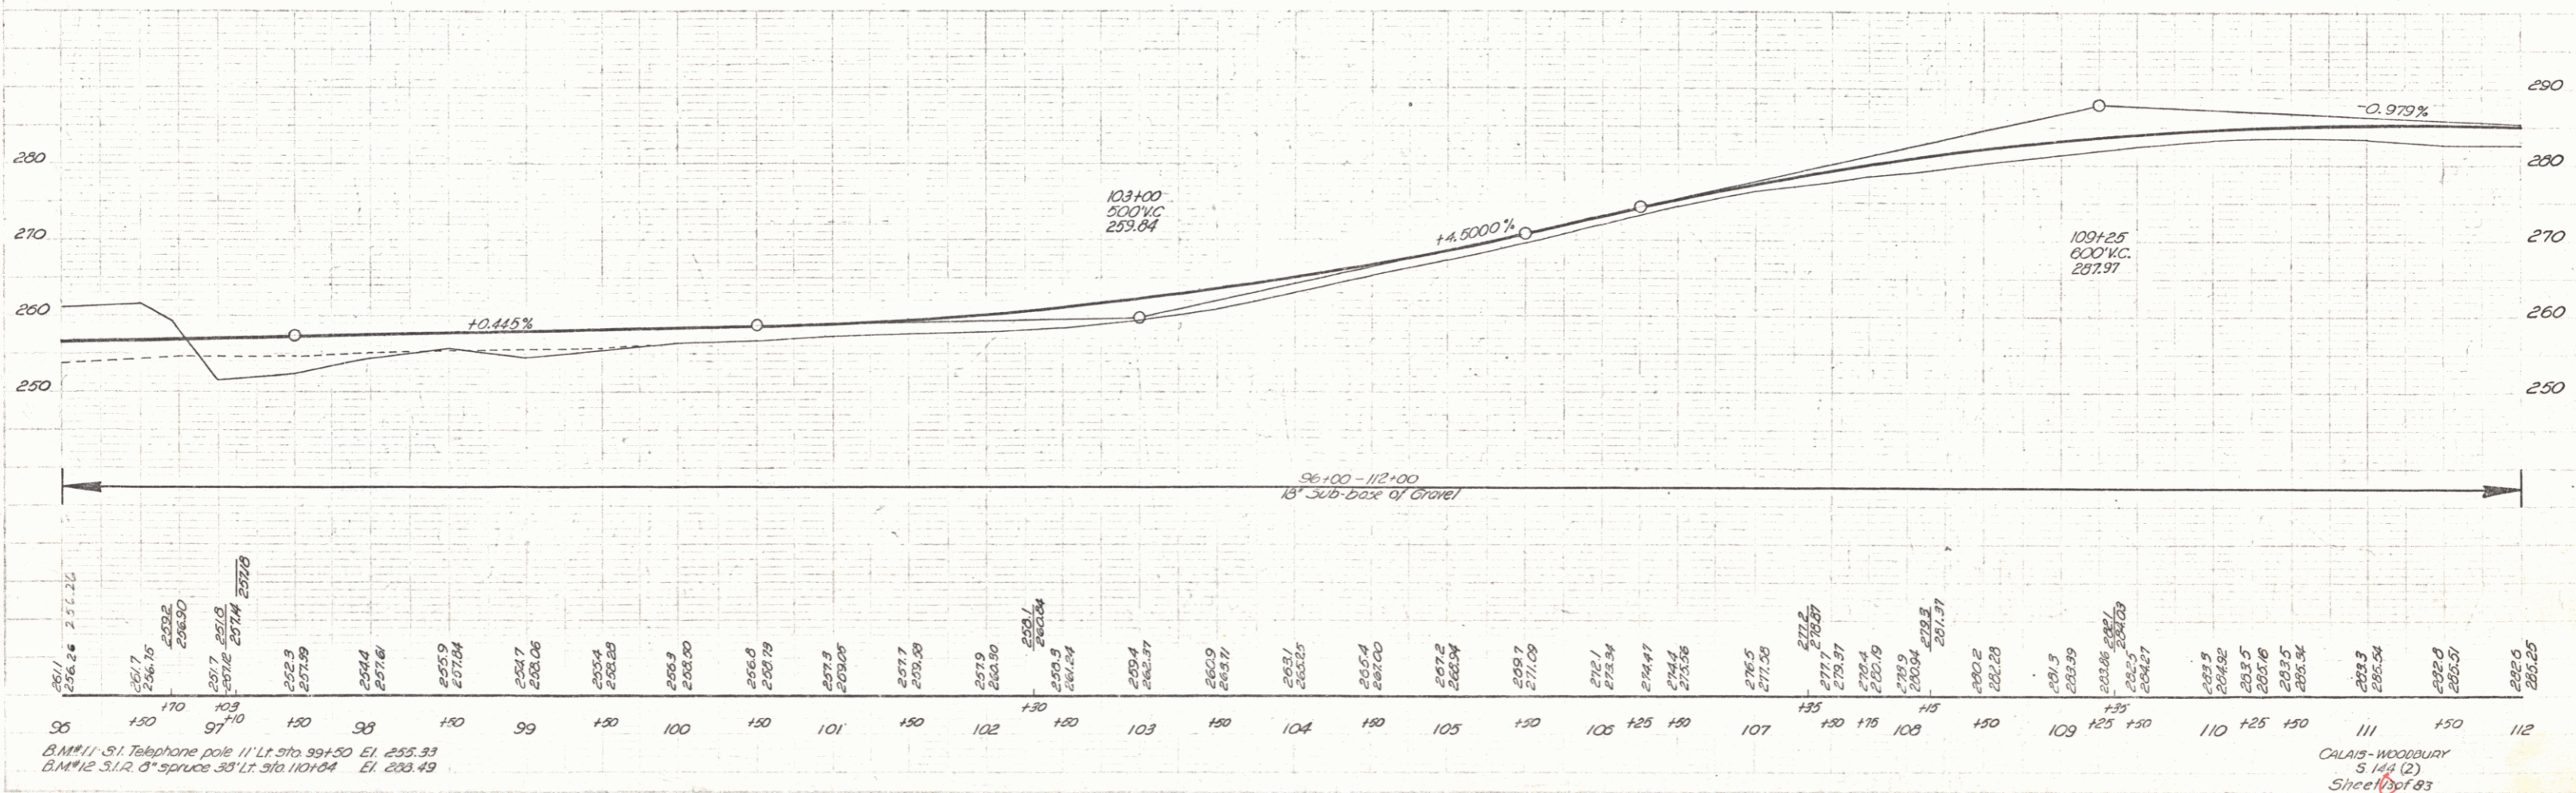


LEON WOODCOCK

PARCEL INSTRUMENT	DATE	GRANTOR	GRANTEE	RECORDED	REMARKS
A.B.C.	W.D.O.E.	9-15-43	PORTER & L. ESTHER COLBY	ST OF VT. BOOK PAGE DATE CALAIS 23 431-32 1-7-44	3 CULV

FED. ROAD DIST. NO. 5 VI. 144(2) 1946 13 83

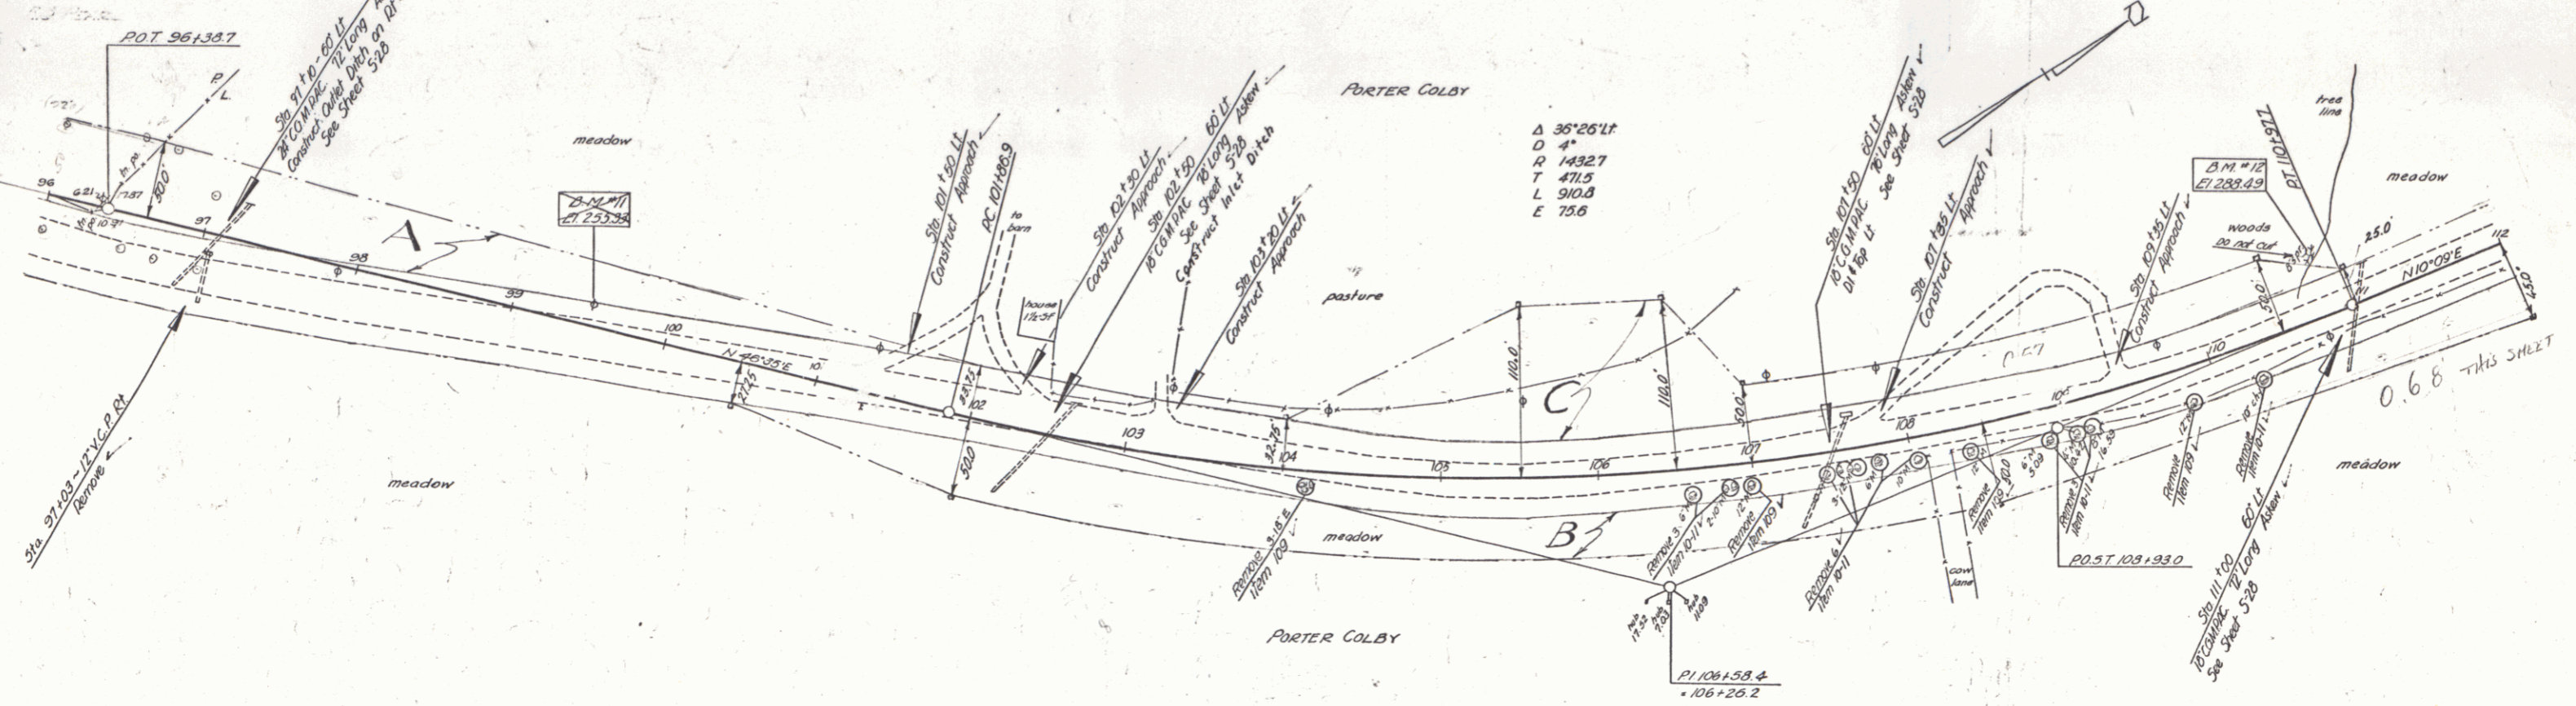

B.M. #11 S.I. Telephone pole 11' Lt. Sta. 99+20 El. 255.33  
 B.M. #12 S.I.R. 8" spruce 38' Lt. Sta. 101+84 El. 253.49

CALAIS-WOODBURY  
 5 144 (2)  
 Sheet 13 of 83