
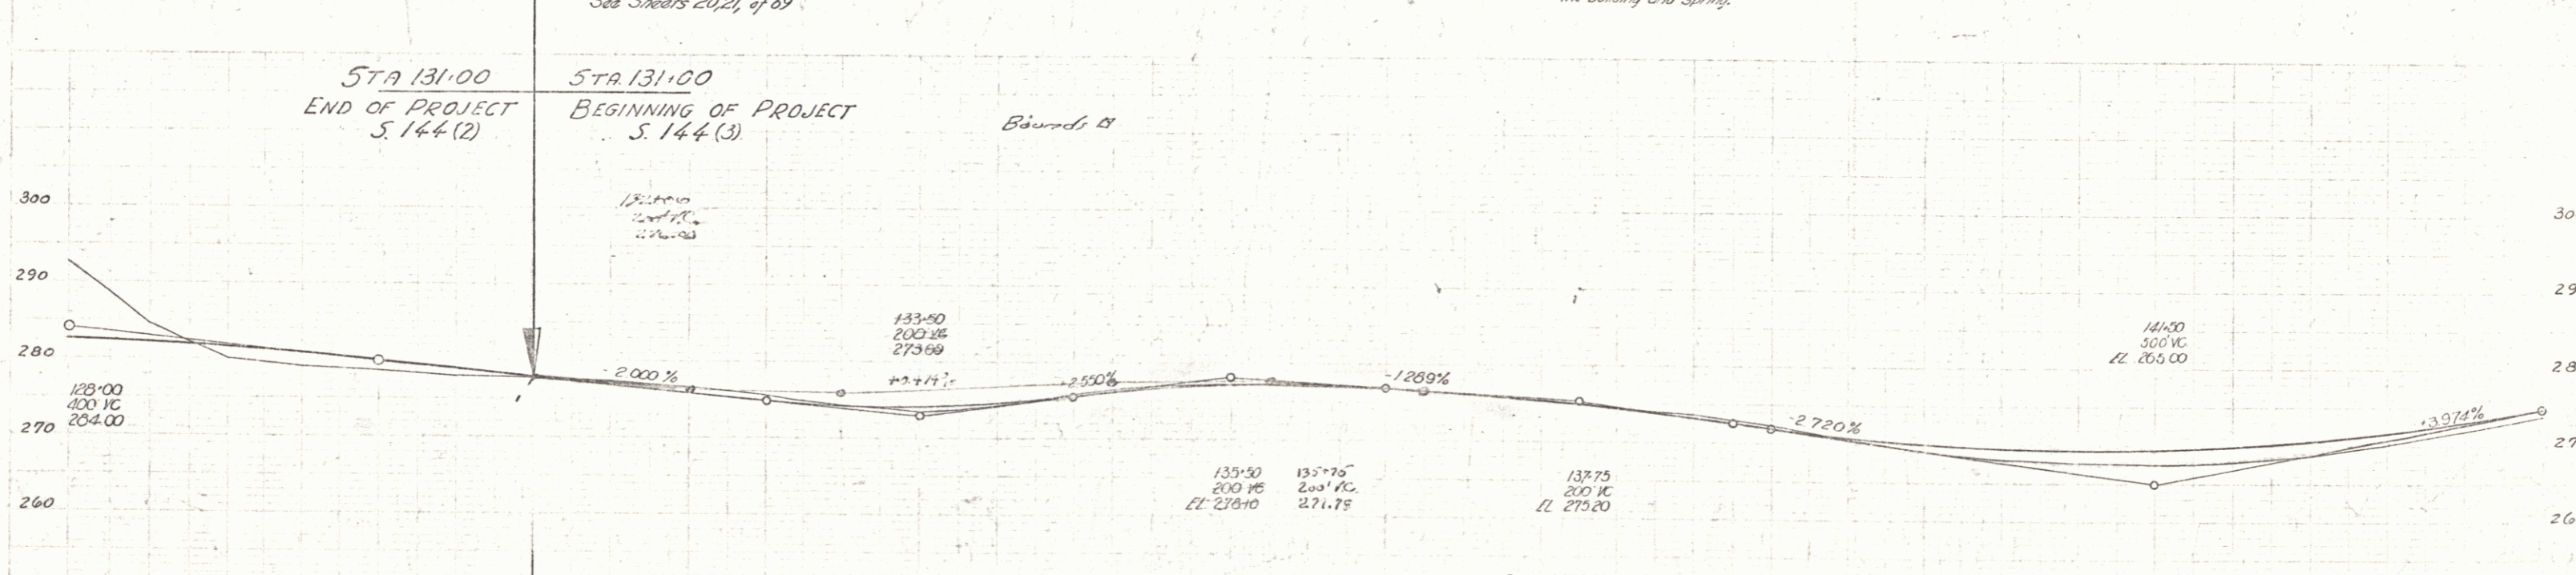


PARCEL INSTRUMENT	DATE	GRANTOR	GRANTEE	RECORDED	REMARKS
-------------------	------	---------	---------	----------	---------

A	W.D.	1-5-45	INEZ TASSIE	ST OF VT	BOOK PAGE DATE
A'	W.D.O.E	2-5-46	FERNANDO I DORIS SALDI	ST OF VT	24 122 1-18-45
A'BC	W.D.O.E	1-15-45	A.E. HAZEL H. THOMPSON	ST OF VT	24 210 2-8-46
A'	W.D.	1-8-45	C.C. CLARA R. FINNER	ST OF VT	24 116/17 1-18-45
A'S	W.D.	1-15-45	MICHAEL L. J. JORDAN EST	ST OF VT	24 118-119 1-18-45
A"	CONVEY.	12-7-44	FRANK SMALL EST	ST OF VT	24 98-105 12-16-44
A"	W.D.O.E	2-13-45	RUDOLF WRENN ANDERSON	ST OF VT	24 147 5-19-45

5144(3) 147 3 69

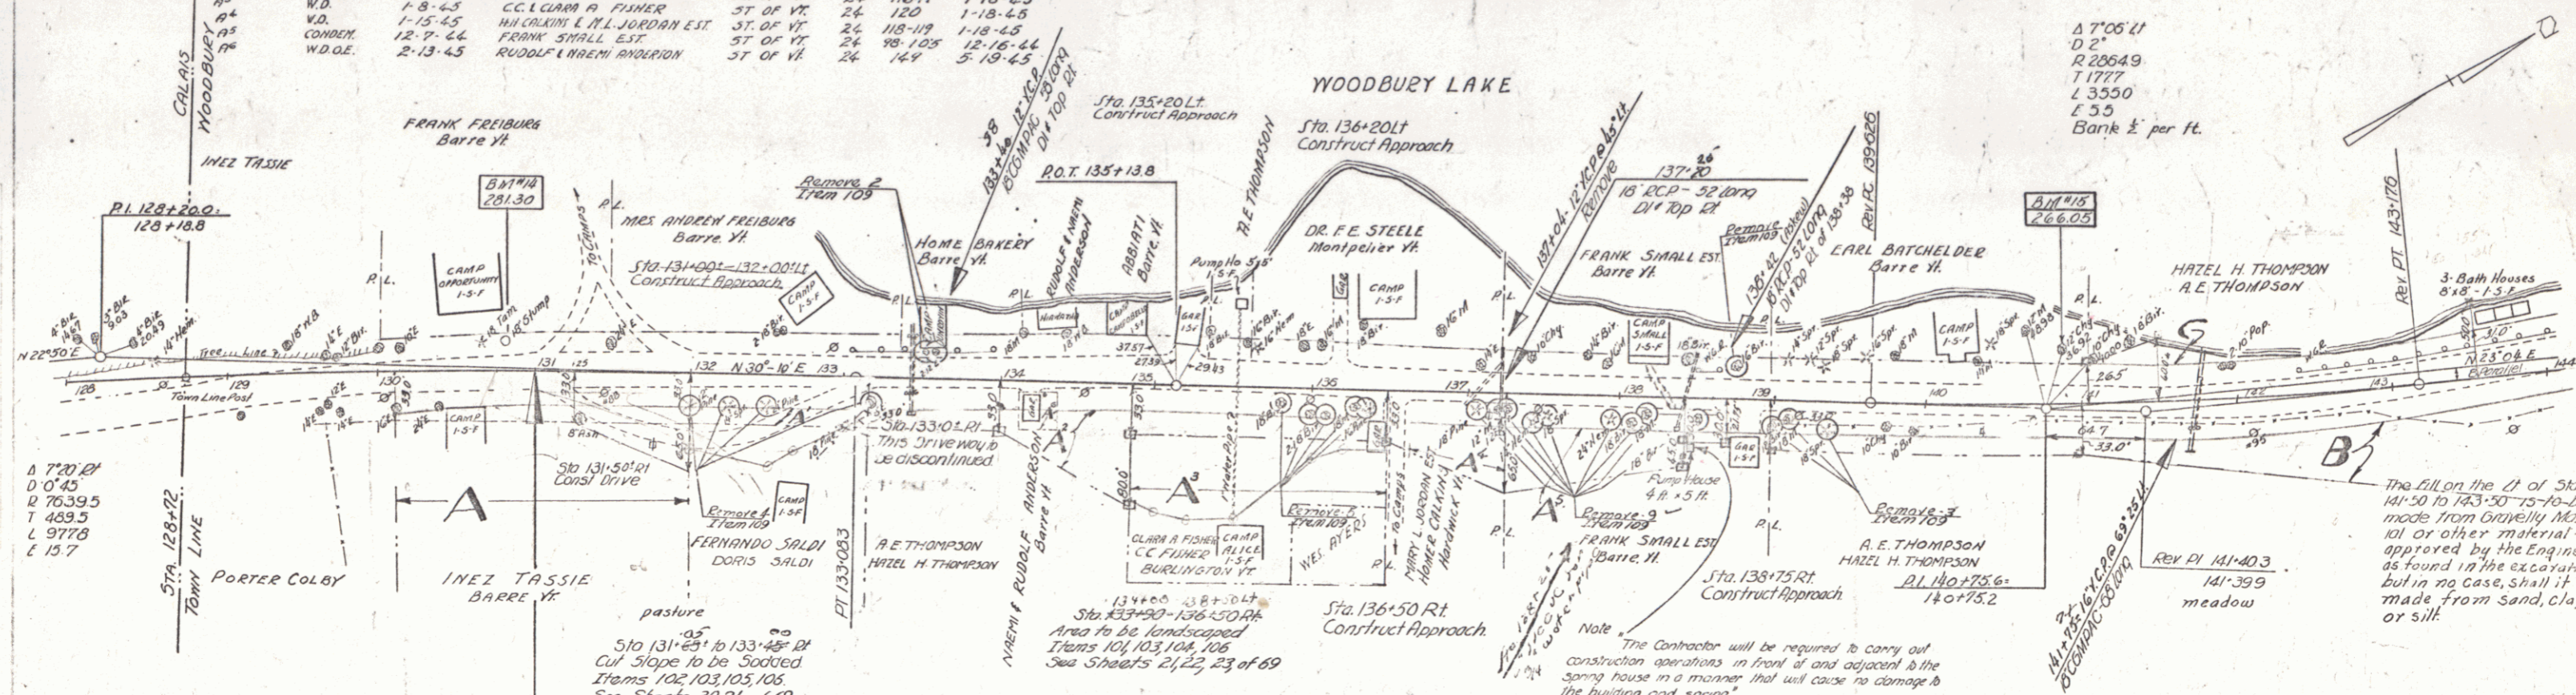

Station	Elevation
128	270.00
129	273.69
130	273.69
131	273.69
132	273.69
133	273.69
134	273.69
135	271.78
136	271.78
137	275.20
138	275.20
139	275.20
140	275.20
141	266.00
142	266.00
143	266.00
144	276.64

WOODBURY  
S. 144(3)  
Sheet 5 of 69 sheets