
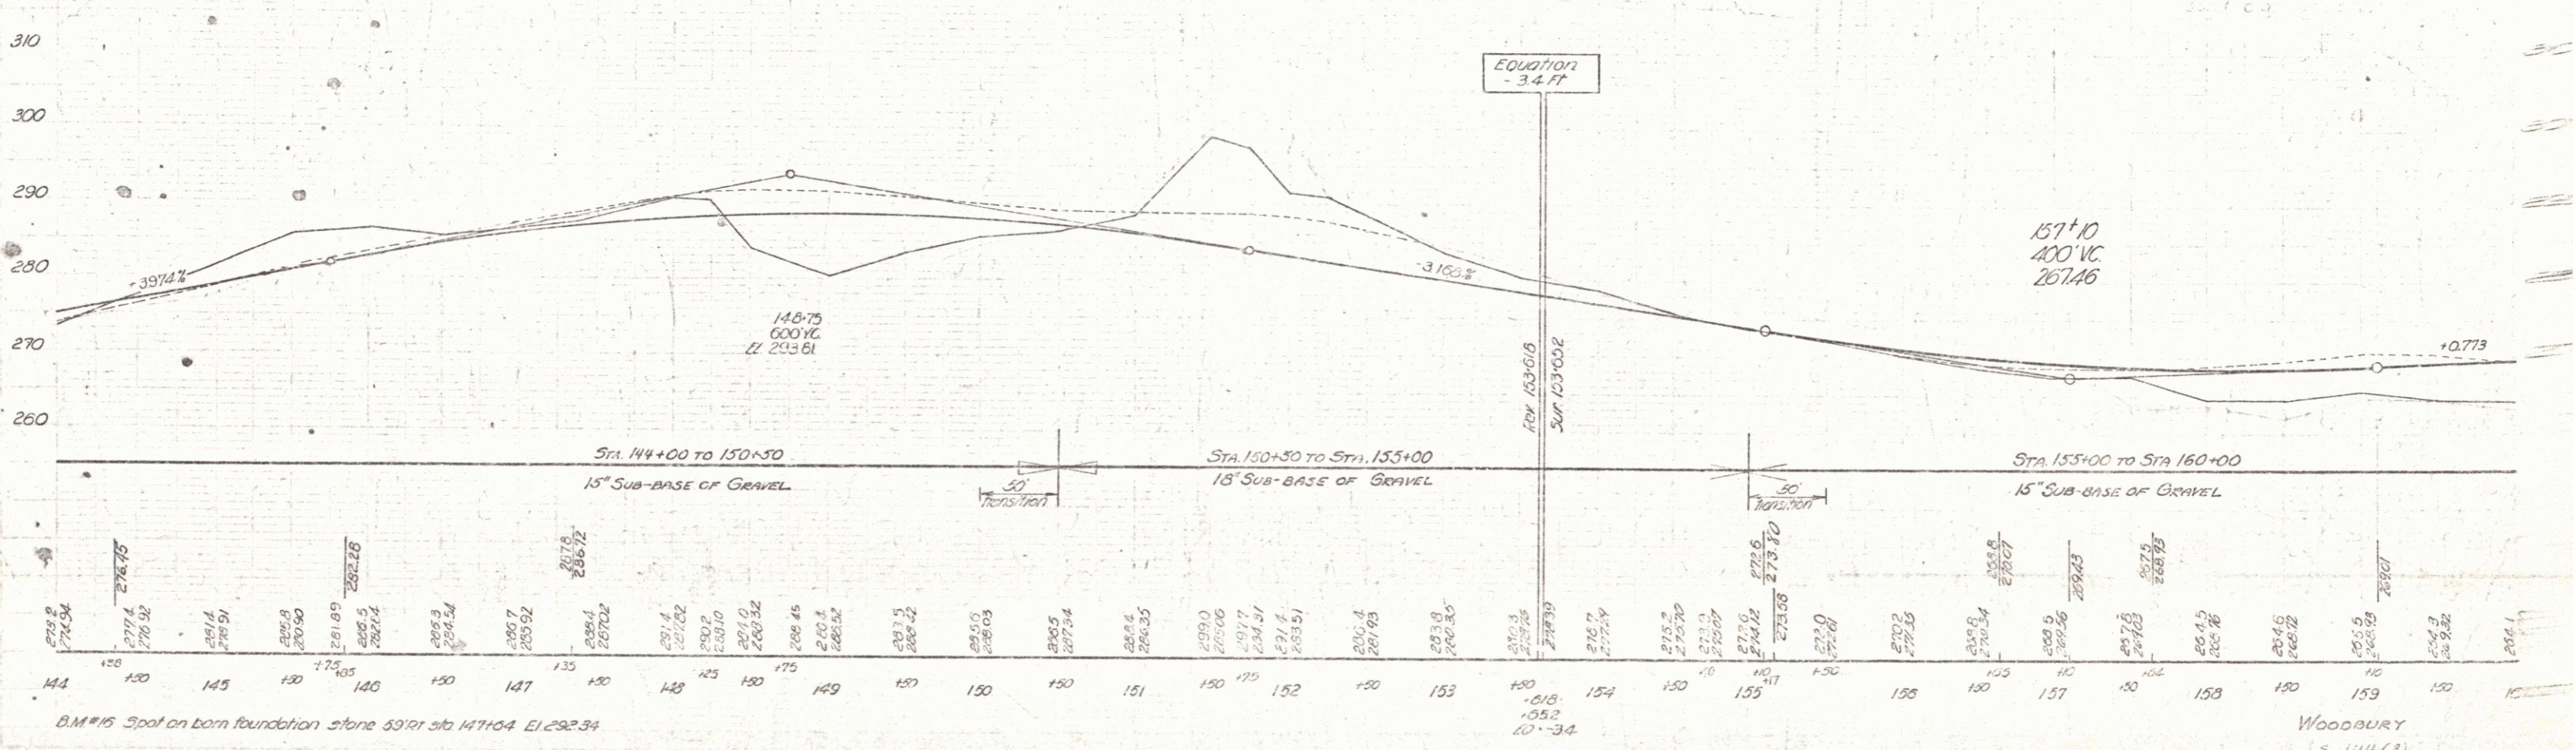


PARCEL	INSTRUMENT DATE	GRANTOR	GRANTEE	RECORDED	REMARKS
D.E.G.	1-15-45	R.E. HAZEL H. THOMPSON	ST. OF VT.	24	118-45
W.D.	1-26-45	JARVE ADOLSON	ST. OF VT.	24	130
A	1-22-45	GLENN H. RHEY & JULIAM	ST. OF VT.	24	148
A ²	1-13-45	LEONARD MYRNA BUSSIERE	ST. OF VT.	24	123
AGRM T	7-29-47	R.E. LAMB	ST. OF VT.	24	366

WOODBURY
S. 144(3) 1947 6 69

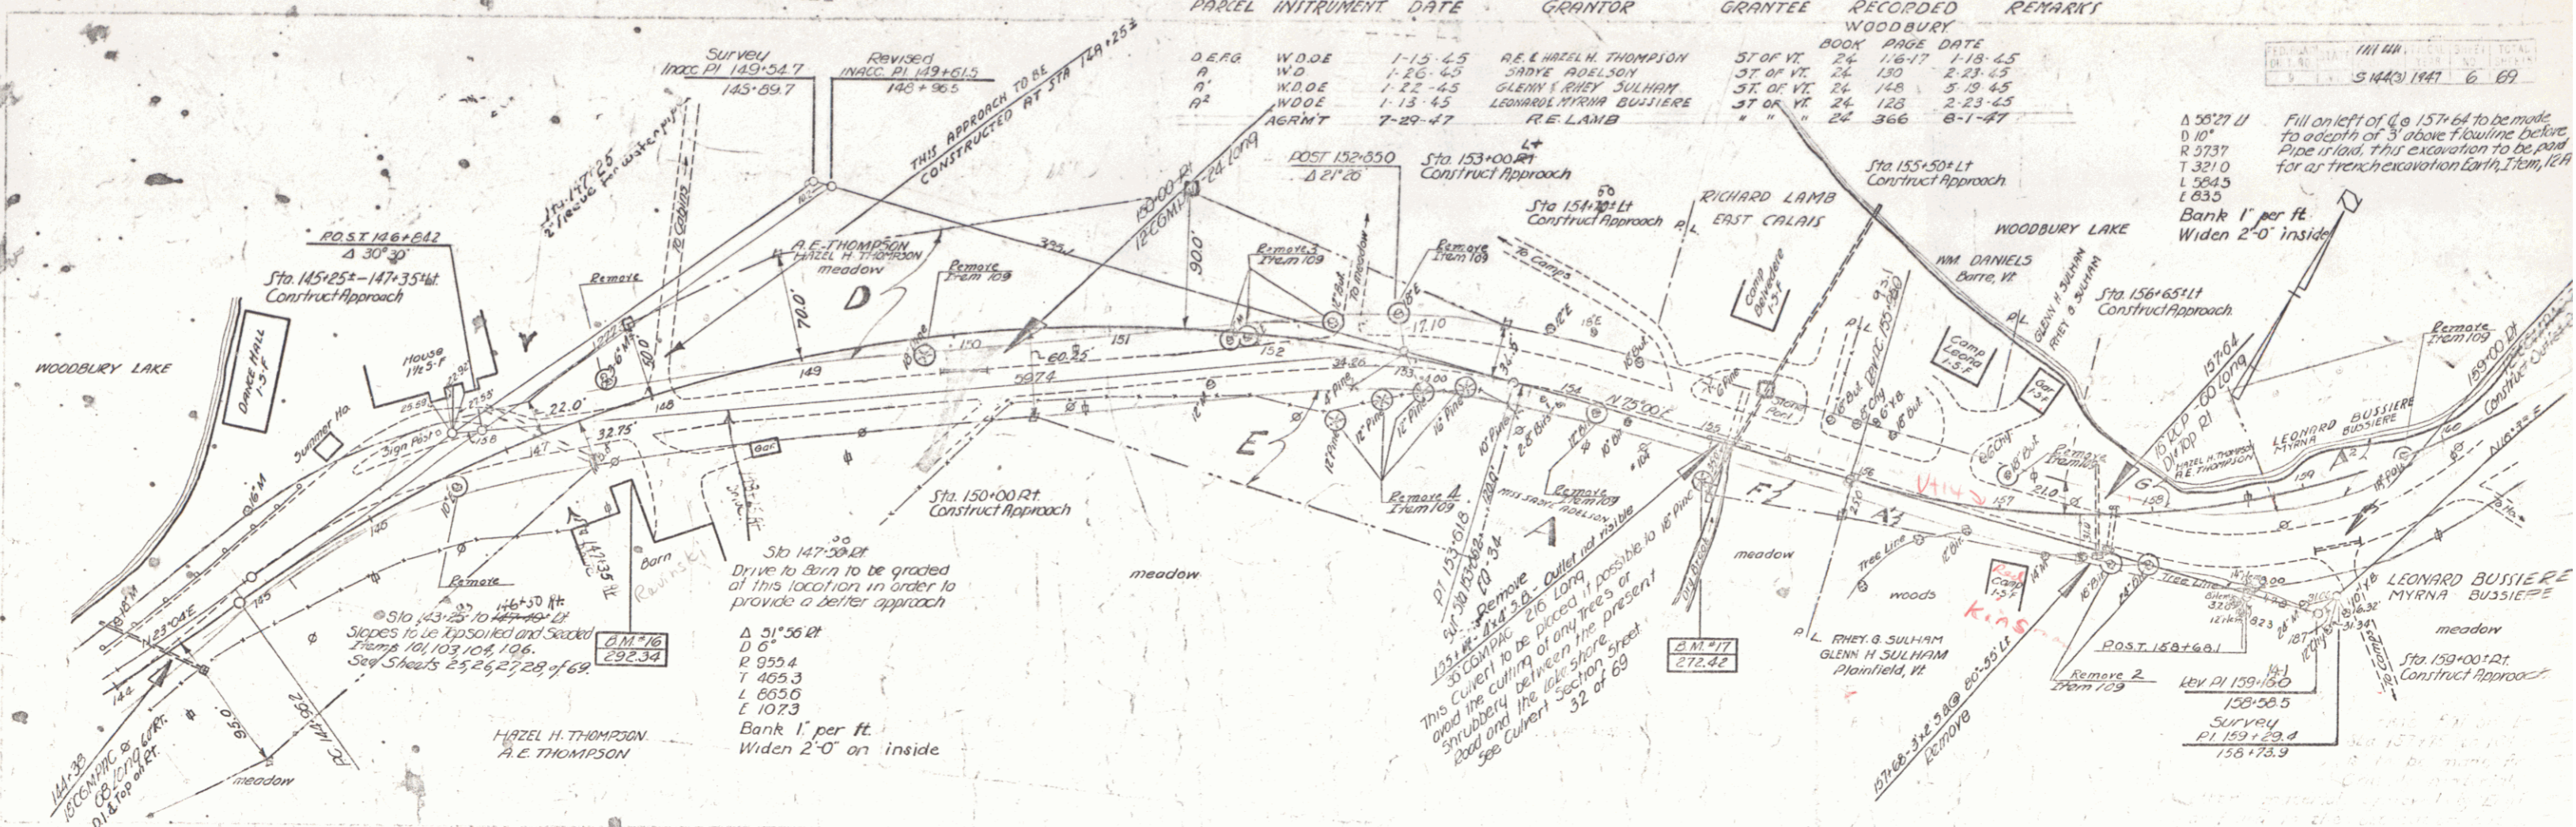

B.M. #15 Spot on barn foundation stone 59'11" Sta 147+04 El 292.34
WOODBURY S. 144(3)
Sheet 6 of 6 sheets