
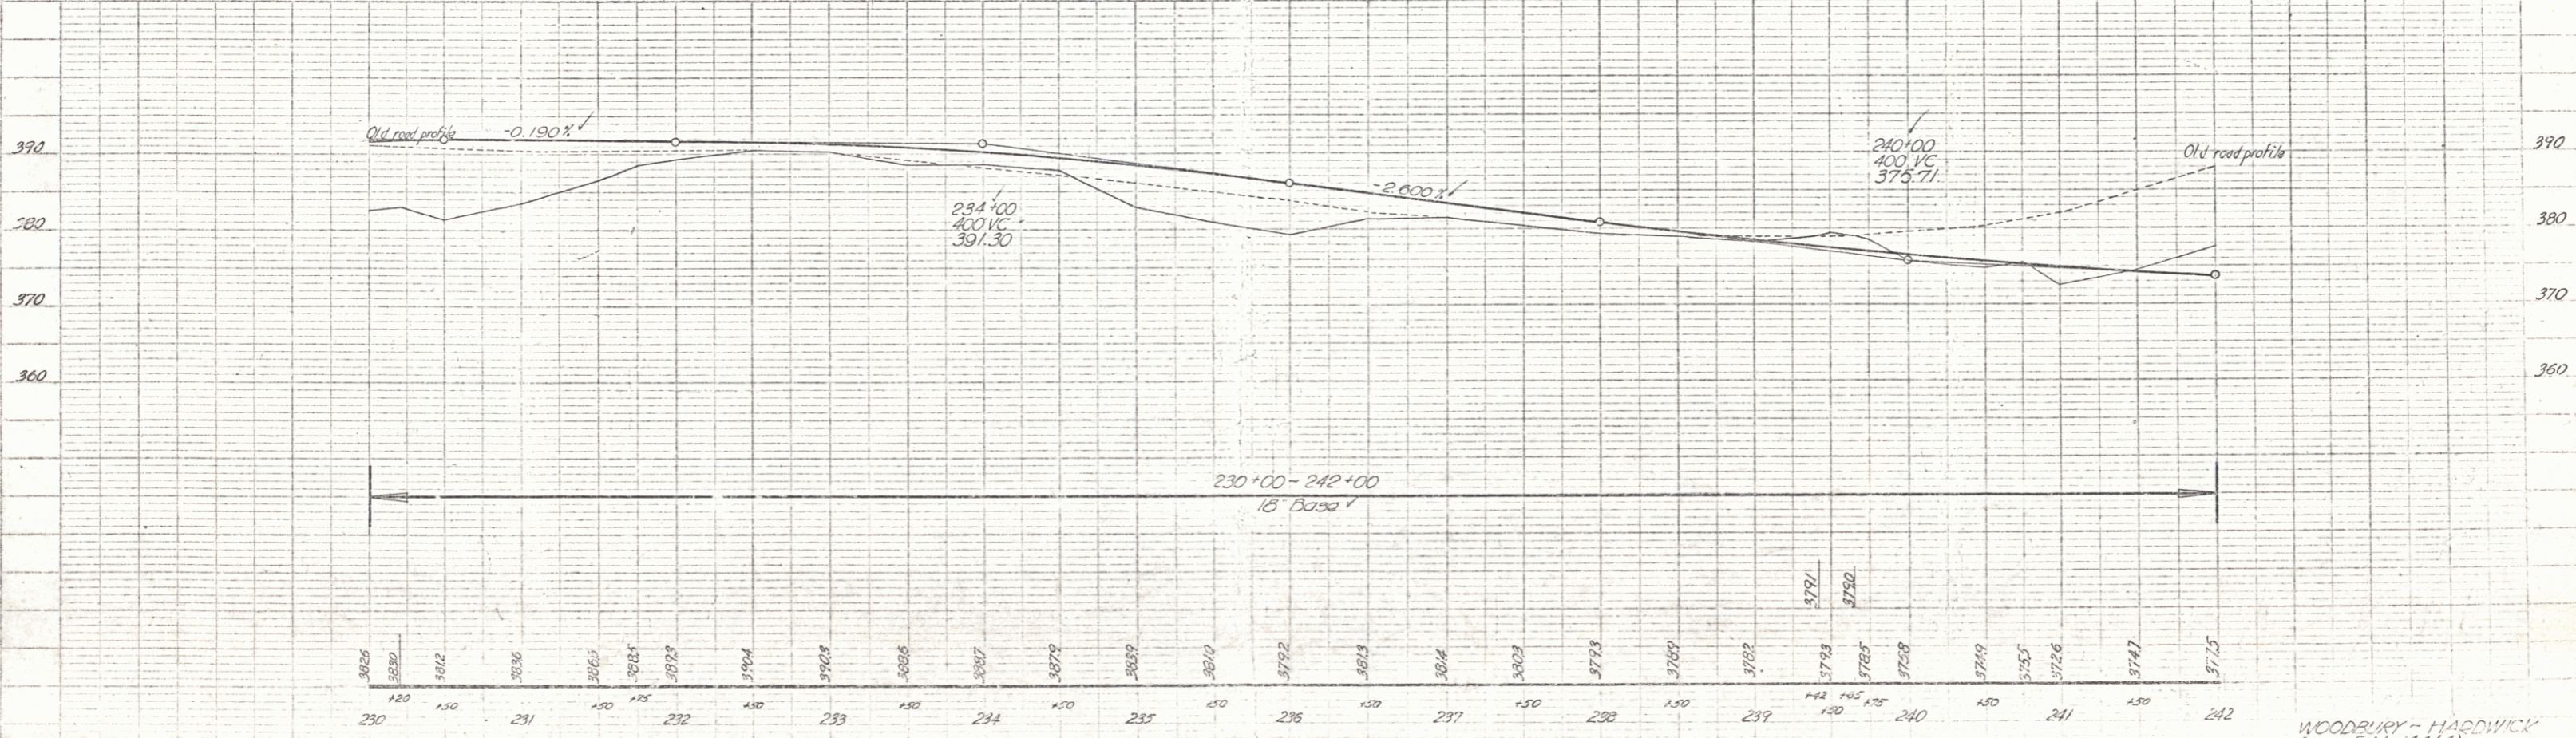


PARCEL INSTRUMENT DATE GRANTOR GRANTEE RECORDED REMARKS  
 #2 A W.D.O.E. 6-20-49 KATHERINE DAILEY ST. OF VT. 24 192 9-23-49 WOODBURY

PLAN	DATE	BY
NO. 1	12-28-49	W.L.D.
NO. 2		
NO. 3		
NO. 4		
NO. 5		
NO. 6		
NO. 7		
NO. 8		
NO. 9		
NO. 10		

Wood Guide Post

Sta	Lt	Rt
230+20	1	
235+70	1	1
240+50	3	
242+00	3	

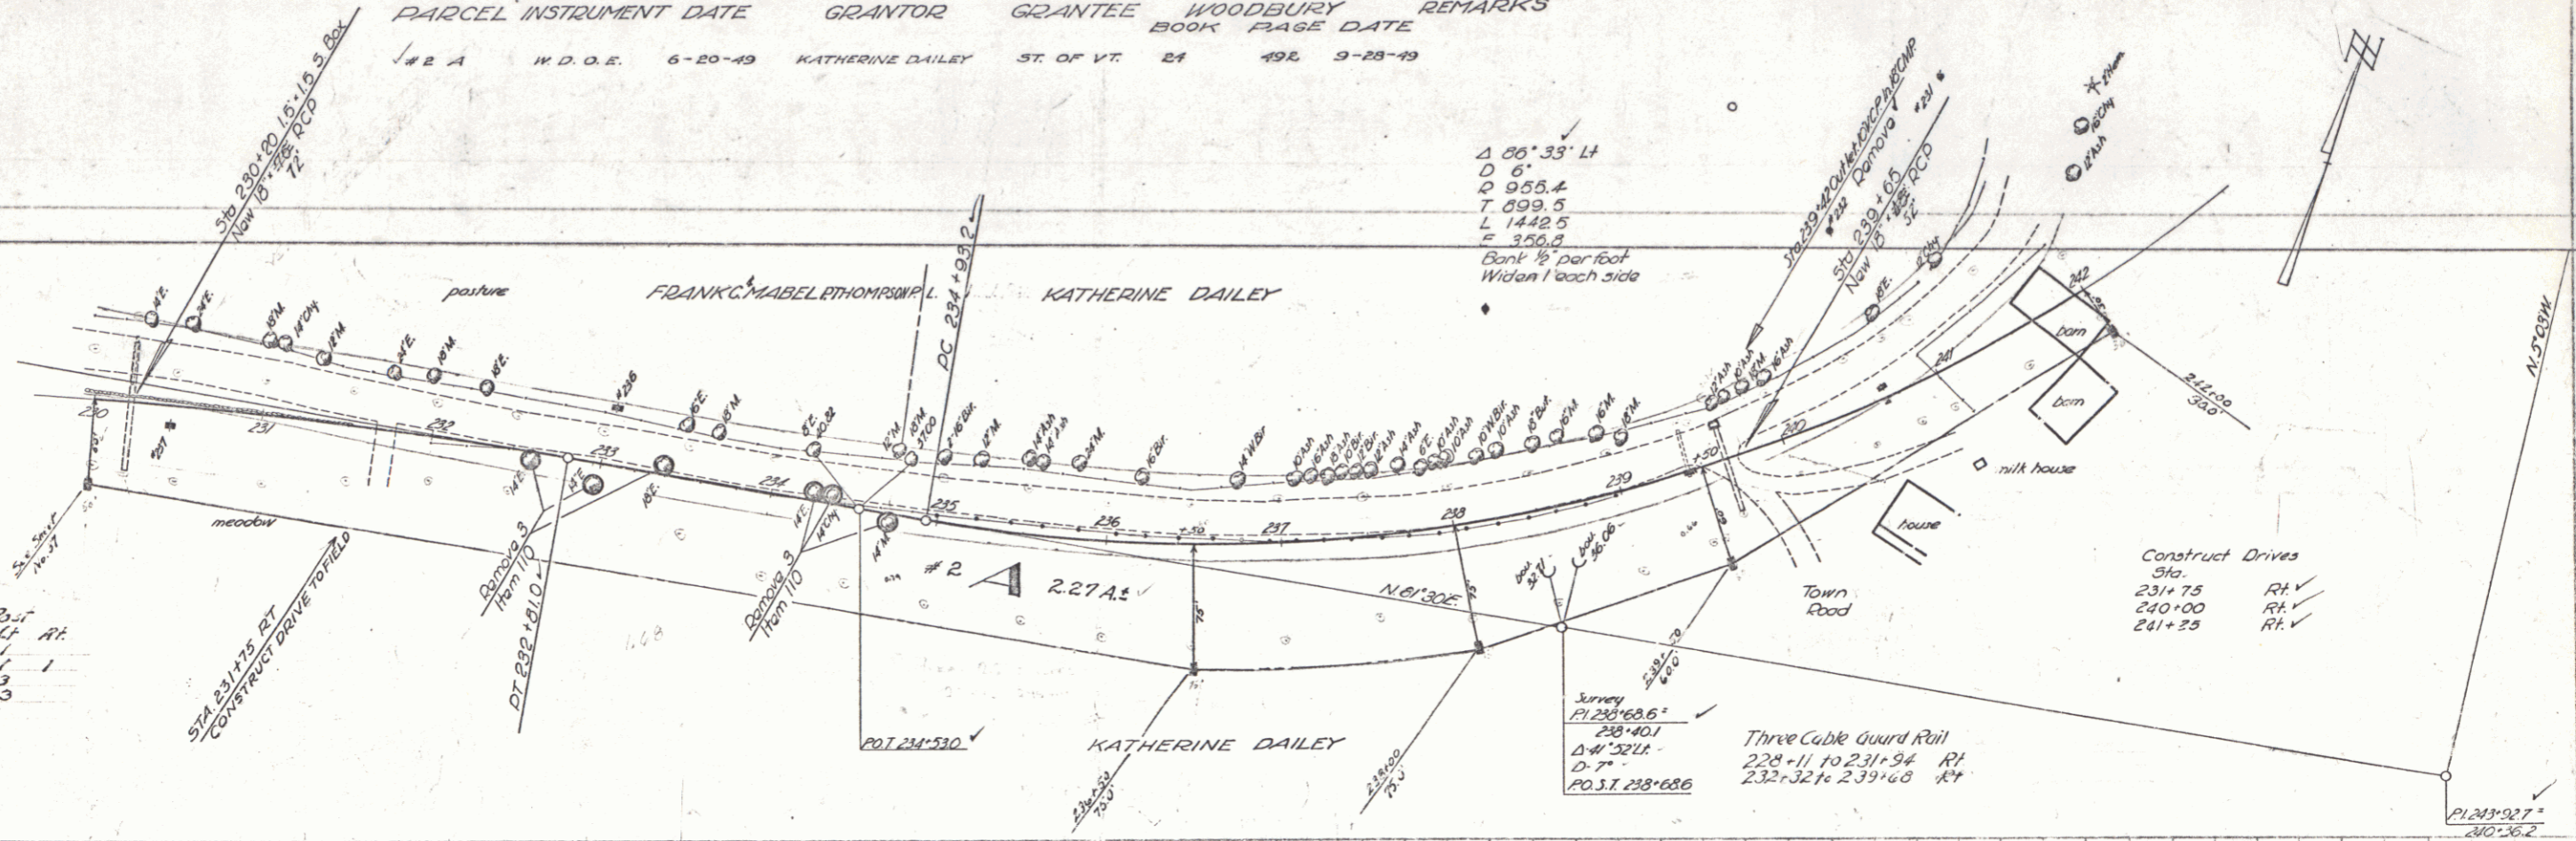

FILE	DATE	BY
NO. 1		
NO. 2		
NO. 3		
NO. 4		
NO. 5		
NO. 6		
NO. 7		
NO. 8		
NO. 9		
NO. 10		

WOODBURY - HARDWICK  
 Series No. 144 (12)  
 Sheet 3 of 3