


PLAN  
 DATE: 12-28-49  
 DRAWN BY: M.L.J.M.  
 CHECKED BY: M.L.J.M.  
 SCALE: AS SHOWN

PLAN  
 DATE: 12-28-49  
 DRAWN BY: M.L.J.M.  
 CHECKED BY: M.L.J.M.  
 SCALE: AS SHOWN

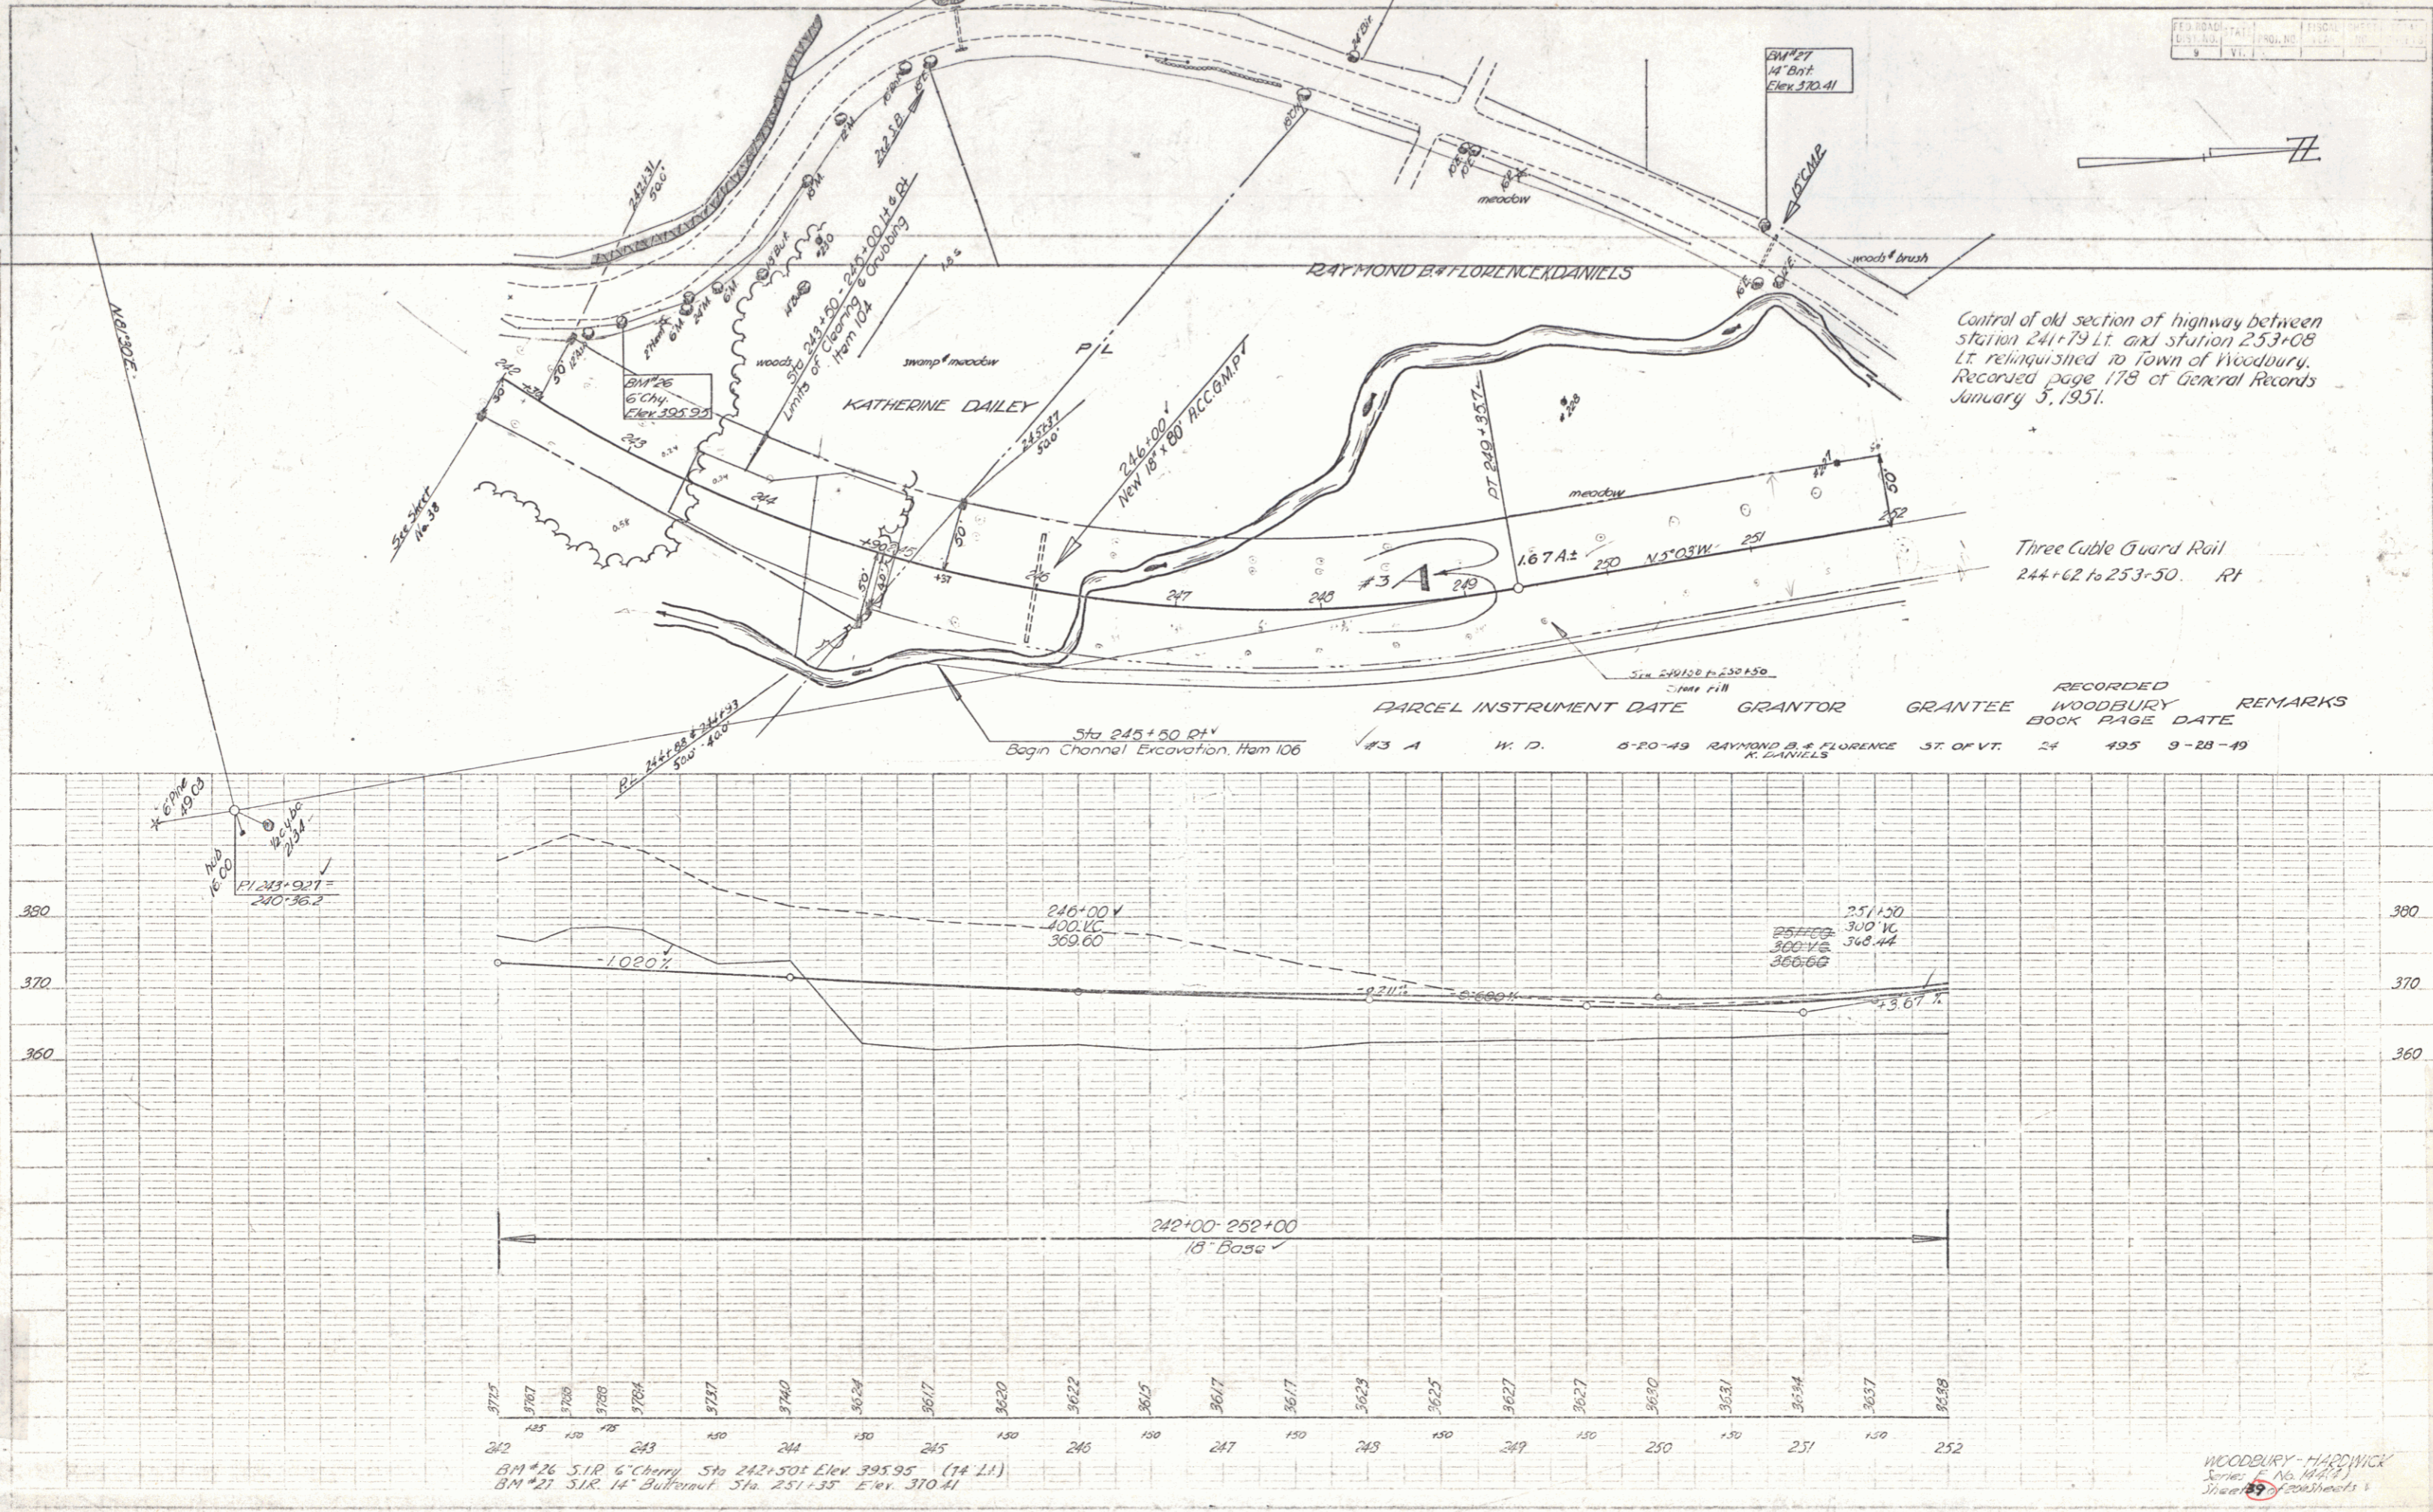

WOODBURY-HADWICK  
 Series (No. 10477)  
 Sheet 29 of 29