



EST. NO.	STATE	PROJ. NO.	FISCAL YEAR	SHEET NO.	TOTAL SHEETS
9	VT.				

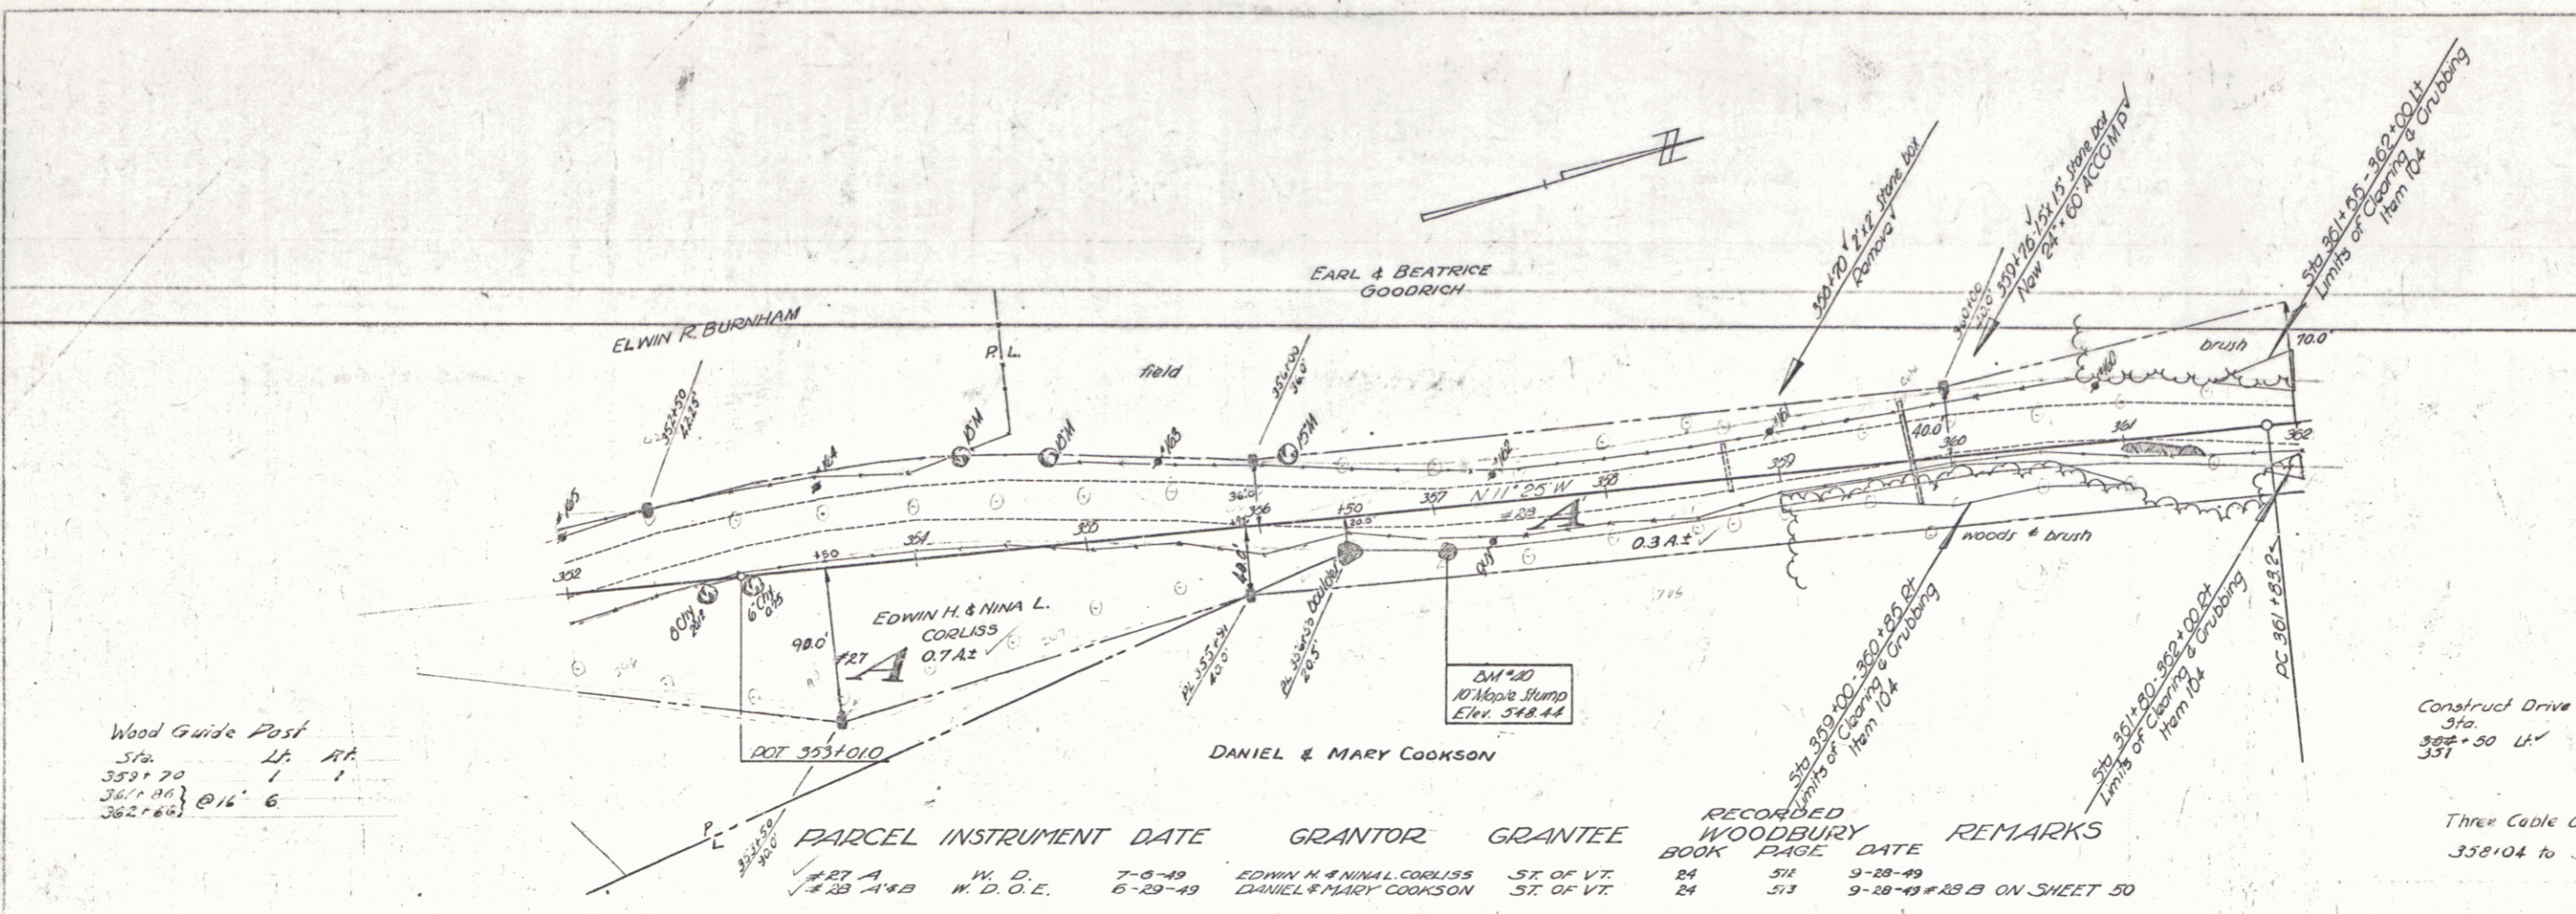

Wood Guide Post  
Sta. 353+20 Lt. Rt.  
361+00 } @ 16' 6"  
362+00 }

PARCEL	INSTRUMENT	DATE	GRANTOR	GRANTEE	RECORDED BOOK	WOODBURY PAGE	DATE	REMARKS
1	#27 A	7-6-49	W. D. E.	EDWIN H. & NINA L. CORLISS	24	518	9-28-49	
2	#28 A+B	6-29-49	W. D. E.	DANIEL & MARY COOKSON	24	513	9-28-49 #28 B ON SHEET 50	

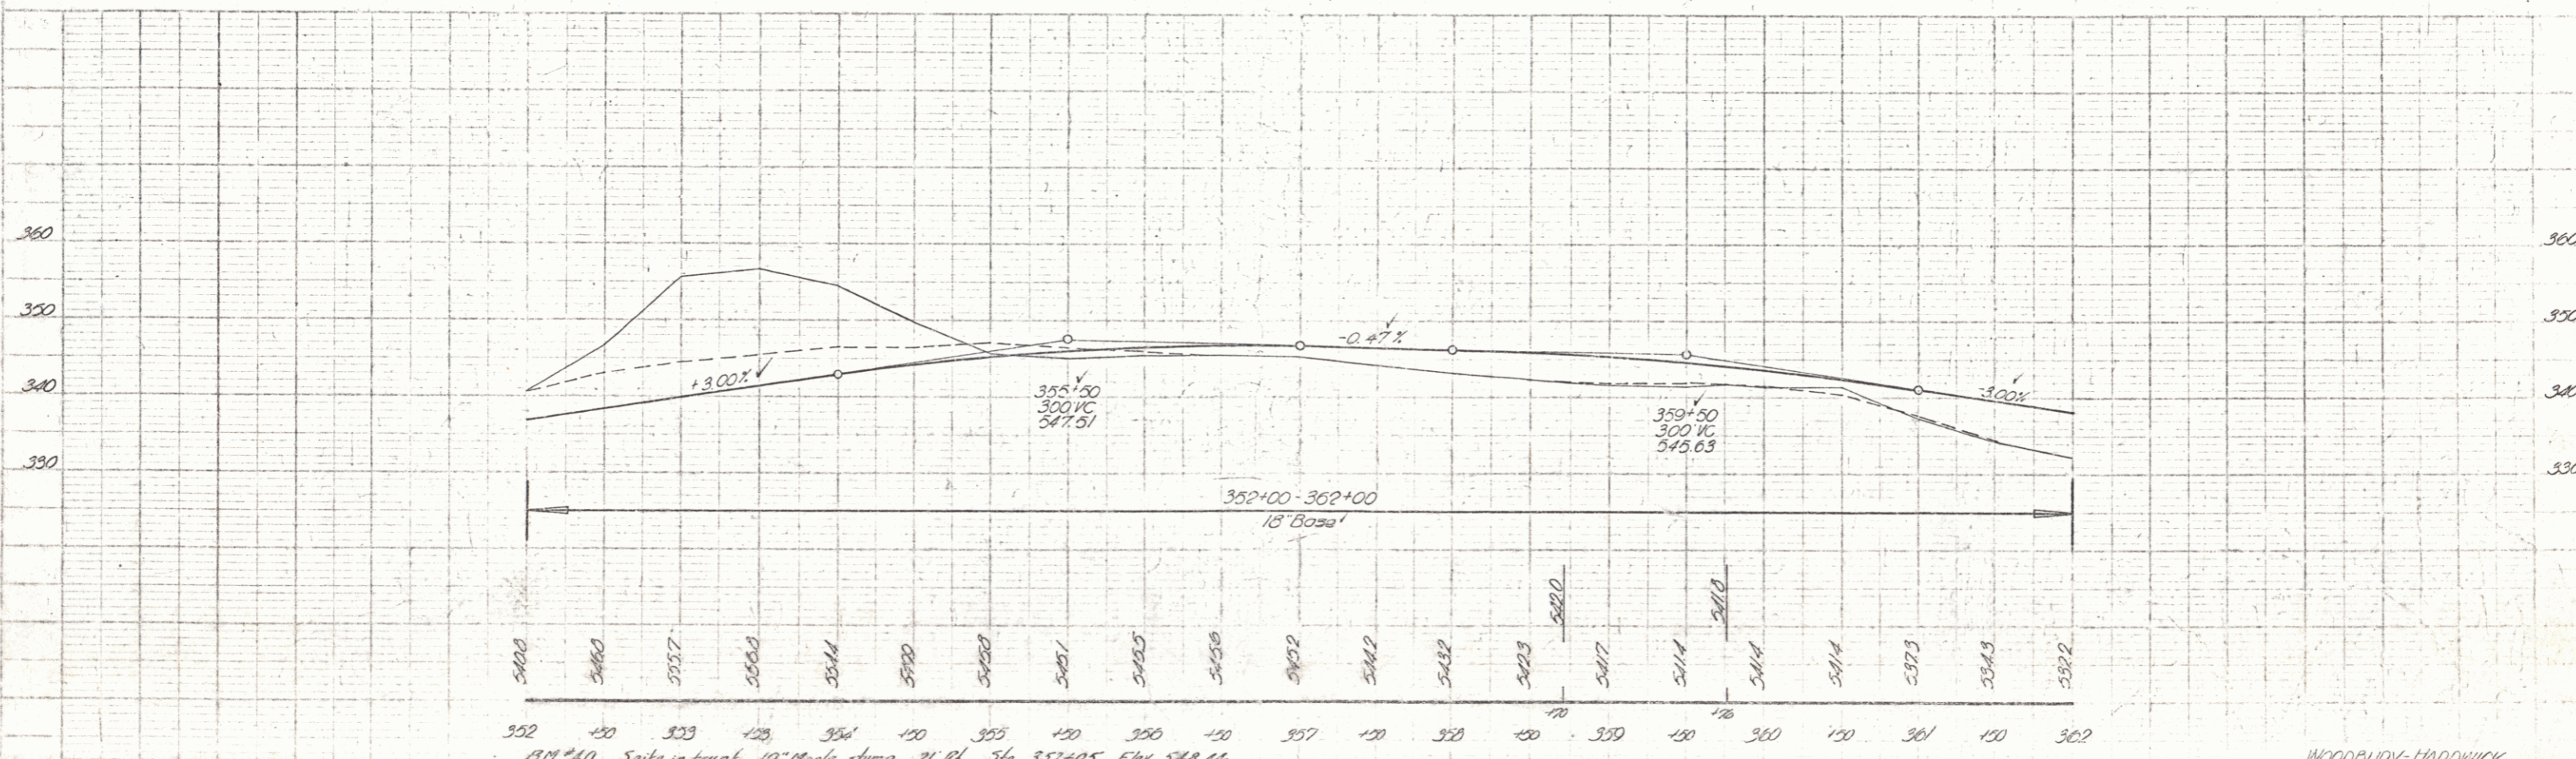

352+00 Spike in trunk 10" Maple stump 21' R.L. Sta. 357+05 Elev. 548.44

WOODBURY-MADONICK Series No. 144 (1) Sheet 49 of 206 sheets