


PARCEL	INSTRUMENT	DATE	GRANTOR	GRANTEE	RECORDED WOODBURY	REMARKS
#20 B	W. D. O. E.	6-29-49	DANIEL & MARY COOKSON	ST. OF VT.	24	513 9-28-49 #20 A' ON SHEET 49
#20 A	QUIT CLAIM DEED	6-20-49	MARGE E. & RAYMOND B. DANIELS	ST. OF VT.	21	218 9-28-49

Wood Guide Post

Sta	Li	ht
366+08	/	/
369+65	/	/
369+70	/	/
369+75	/	/
373+01	/	/
374+75	/	/

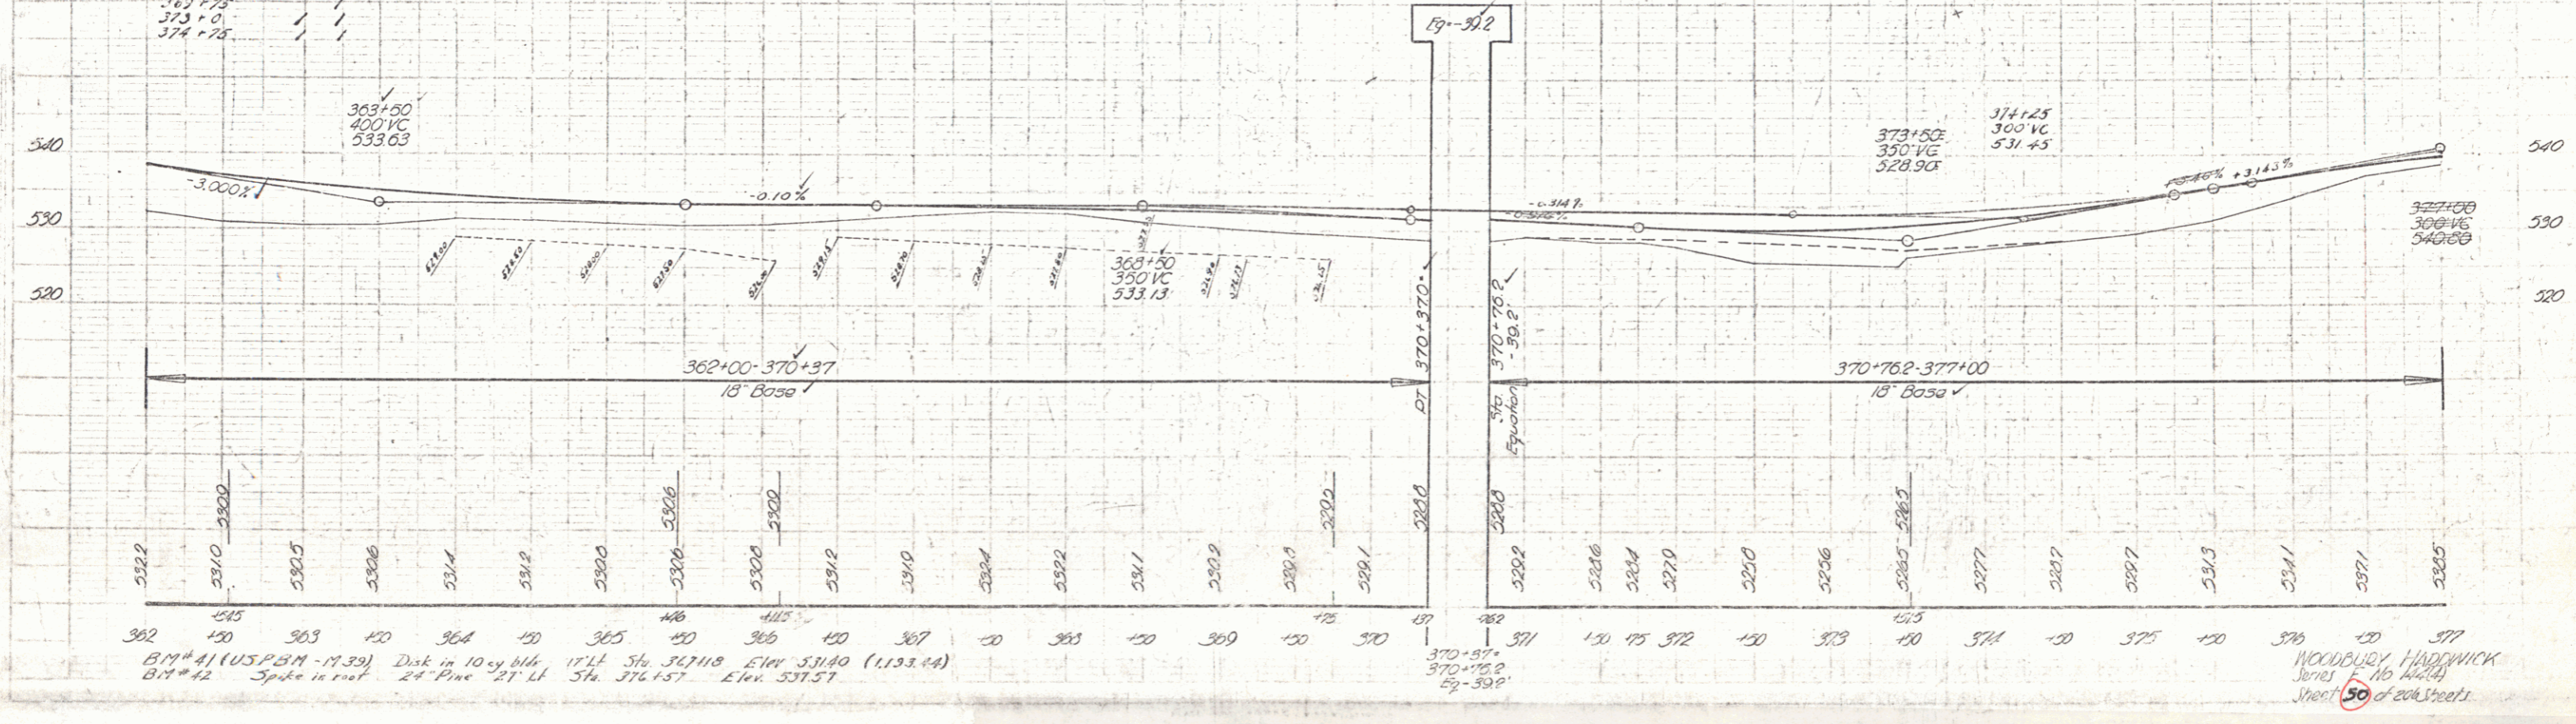

BM #41 (USPBM - 17.32) 24' Pine 21' Lt 5ft. 376.157 Elev. 531.57  
 BM #42 Spike in road 24' Pine 21' Lt 5ft. 376.157 Elev. 531.57

WOODBURY HADWICK Series F No. 100 of 200 Streets