


*Just Claim Deed 0.14 A±
from State to
Raymond C. Parker dated 7/25/54
& recorded in BK 27, Pg 54
WOODBURY LAND RECORDS.
RAYMOND C. PARKER*

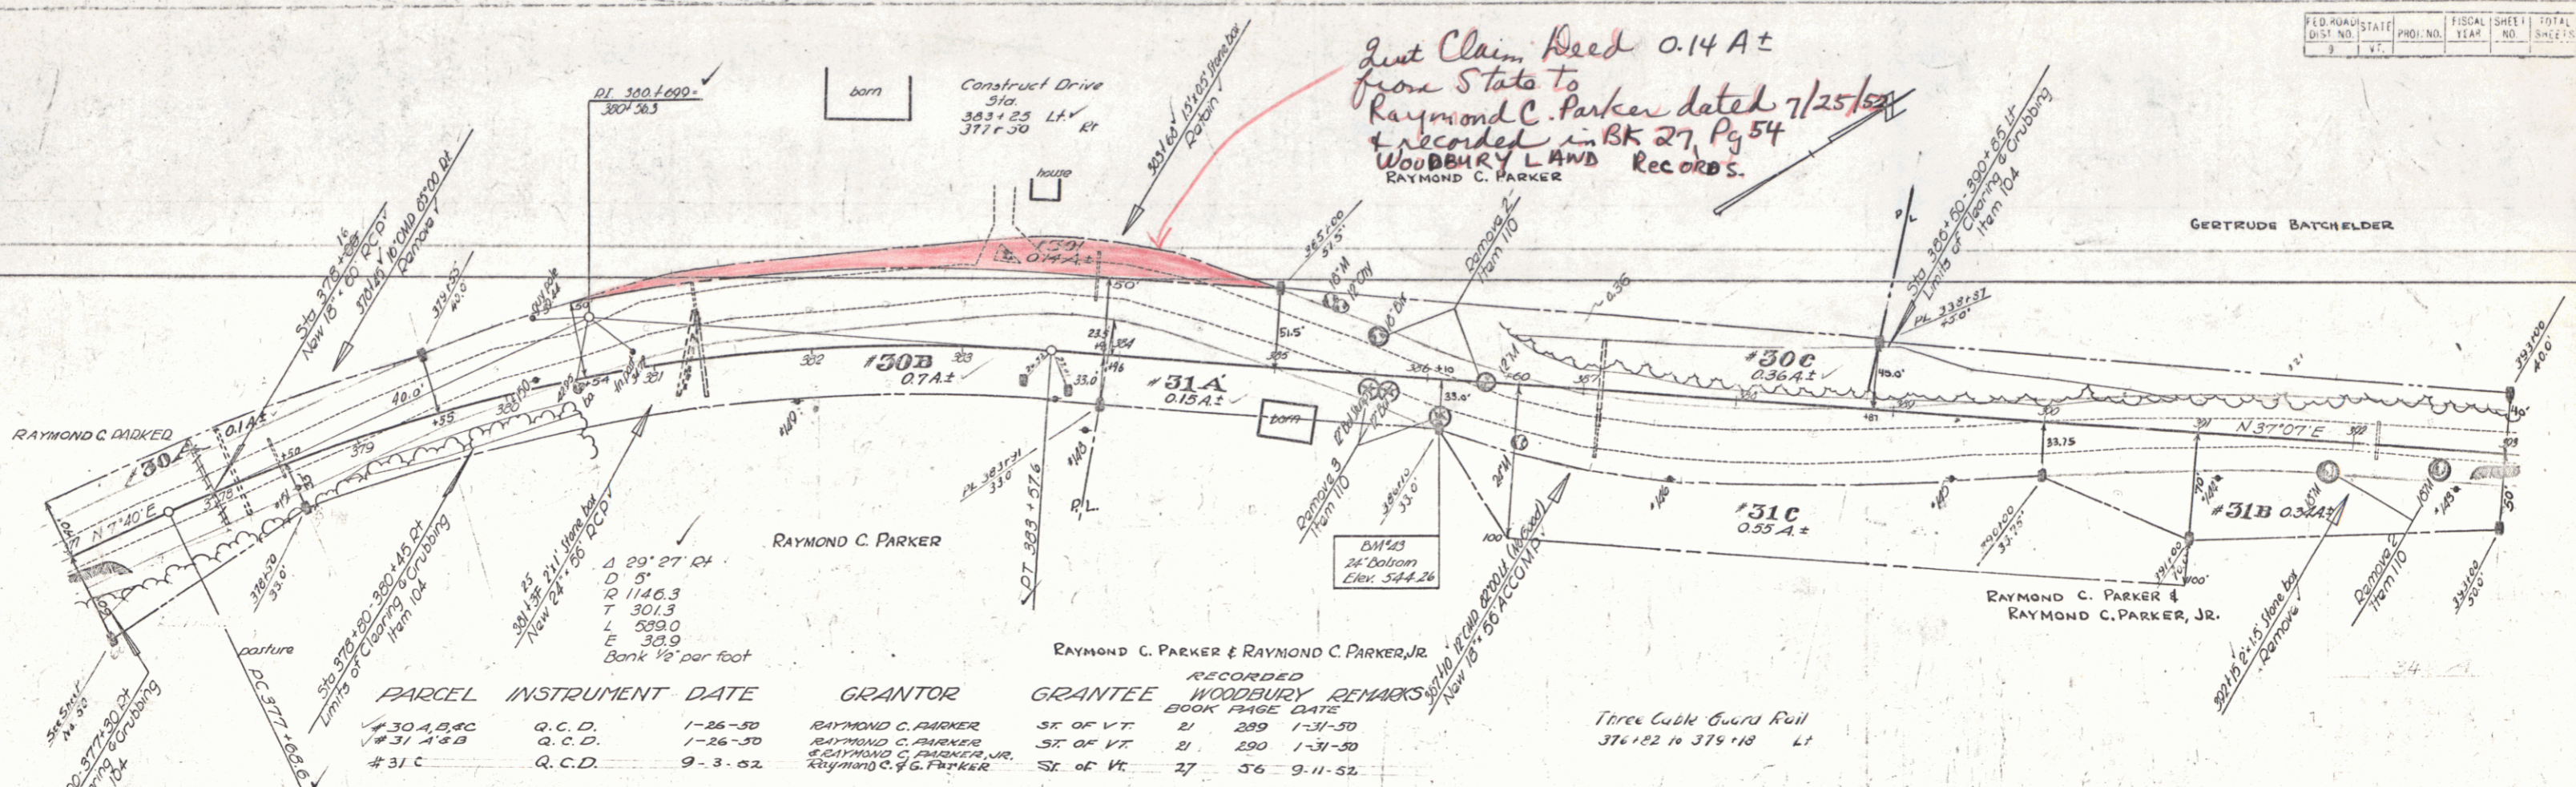

PARCEL	INSTRUMENT	DATE	GRANTOR	GRANTEE	RECORDED BOOK PAGE DATE	WOODBURY REMARKS
# 30 A, B, C	Q. C. D.	1-26-30	RAYMOND C. PARKER	ST. OF VT.	21 289 1-31-30	
# 31 A & B	Q. C. D.	1-26-30	RAYMOND C. PARKER	ST. OF VT.	21 290 1-31-30	
# 31 C	Q. C. D.	9-3-52	RAYMOND C. & G. PARKER	ST. OF VT.	27 56 9-11-52	

Wood Posts
 376 2 1/2
 377 63 1
 381 13 1
 381 13 1
 387 08 1
 387 20 2

