
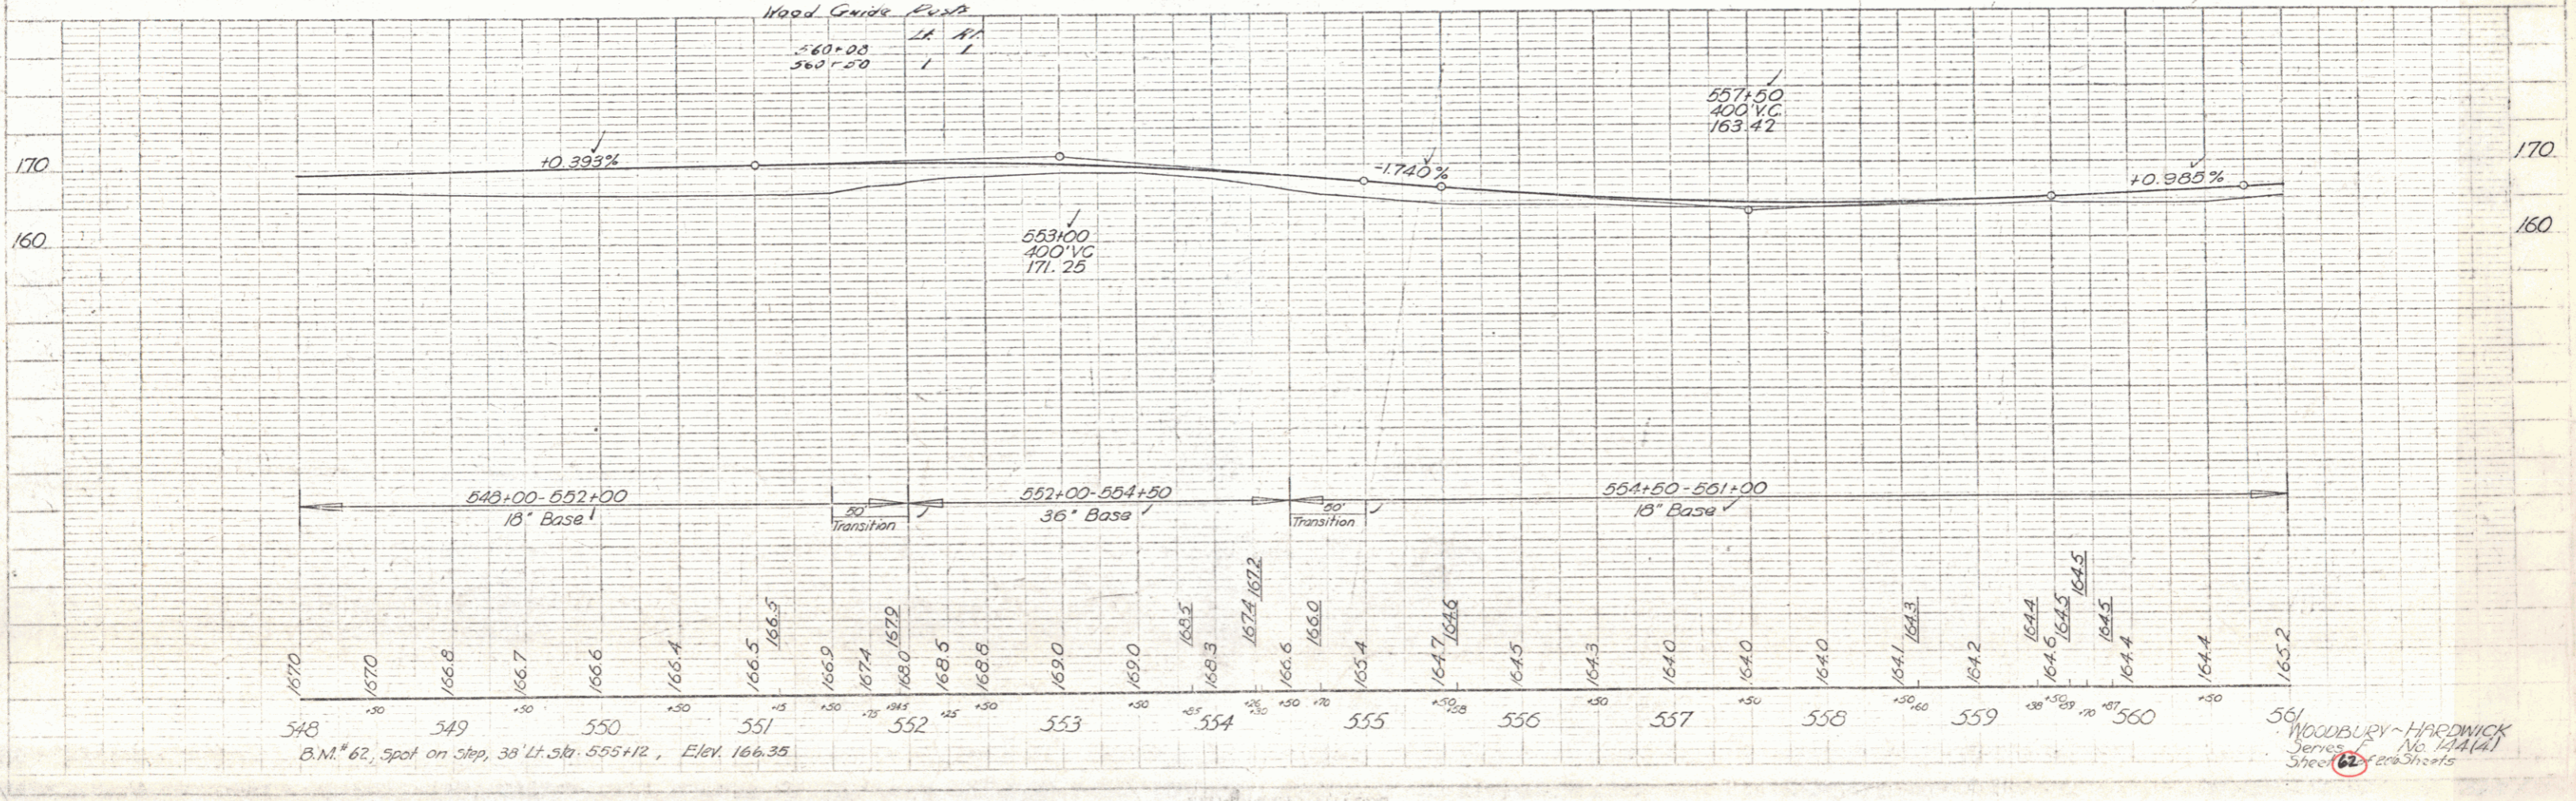


PLAN  
 PARTS  
 DATE  
 DRAWN BY  
 CHECKED BY

5-48  
 Sighting  
 5-48

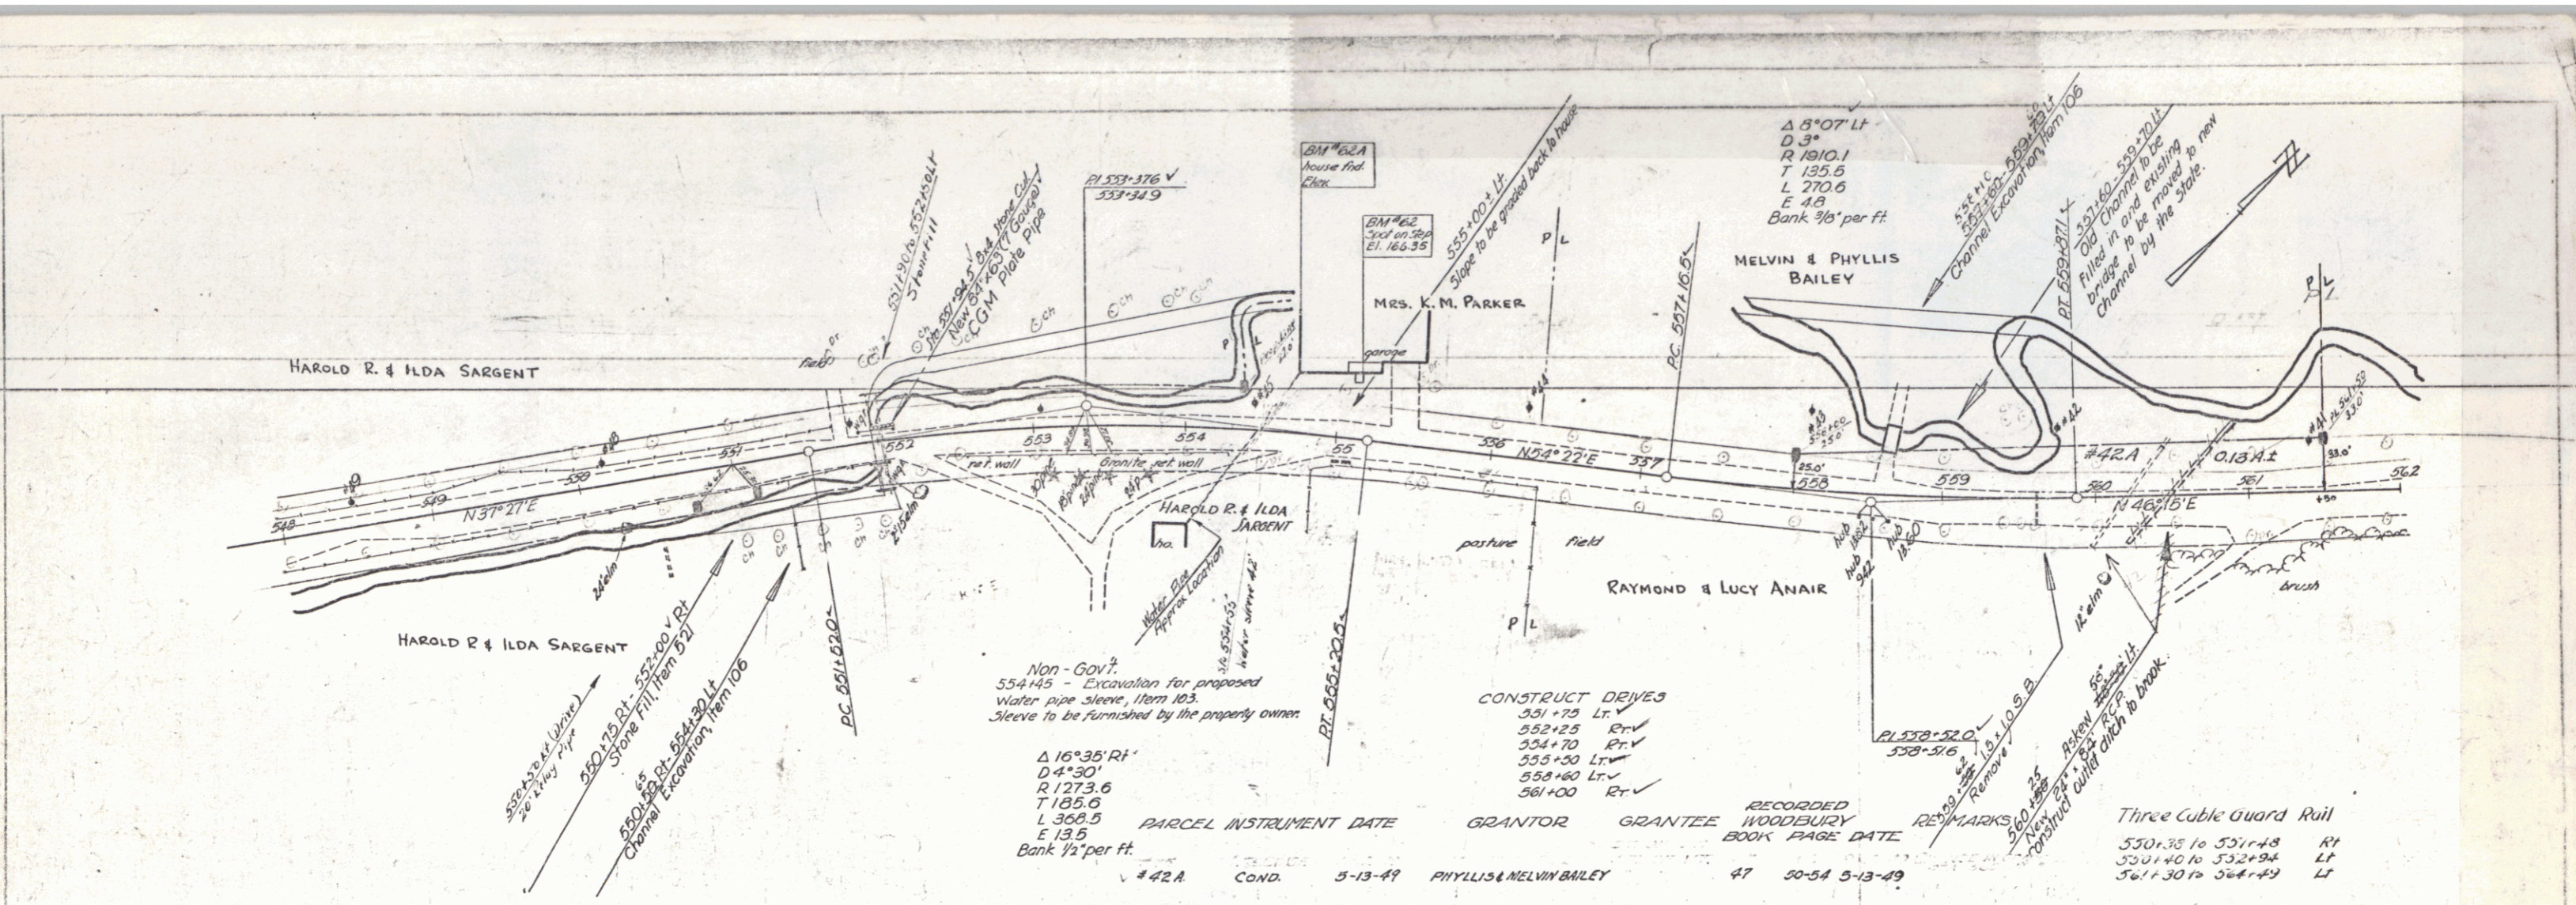

561 WOODBURY-HARDWICK  
 Series L No. 144 (a)  
 Sheet 62 of 63 sheets