



PLAN
 SHEET NO. 9
 DATE 7-18-27
 DRAWN BY [illegible]
 CHECKED BY [illegible]

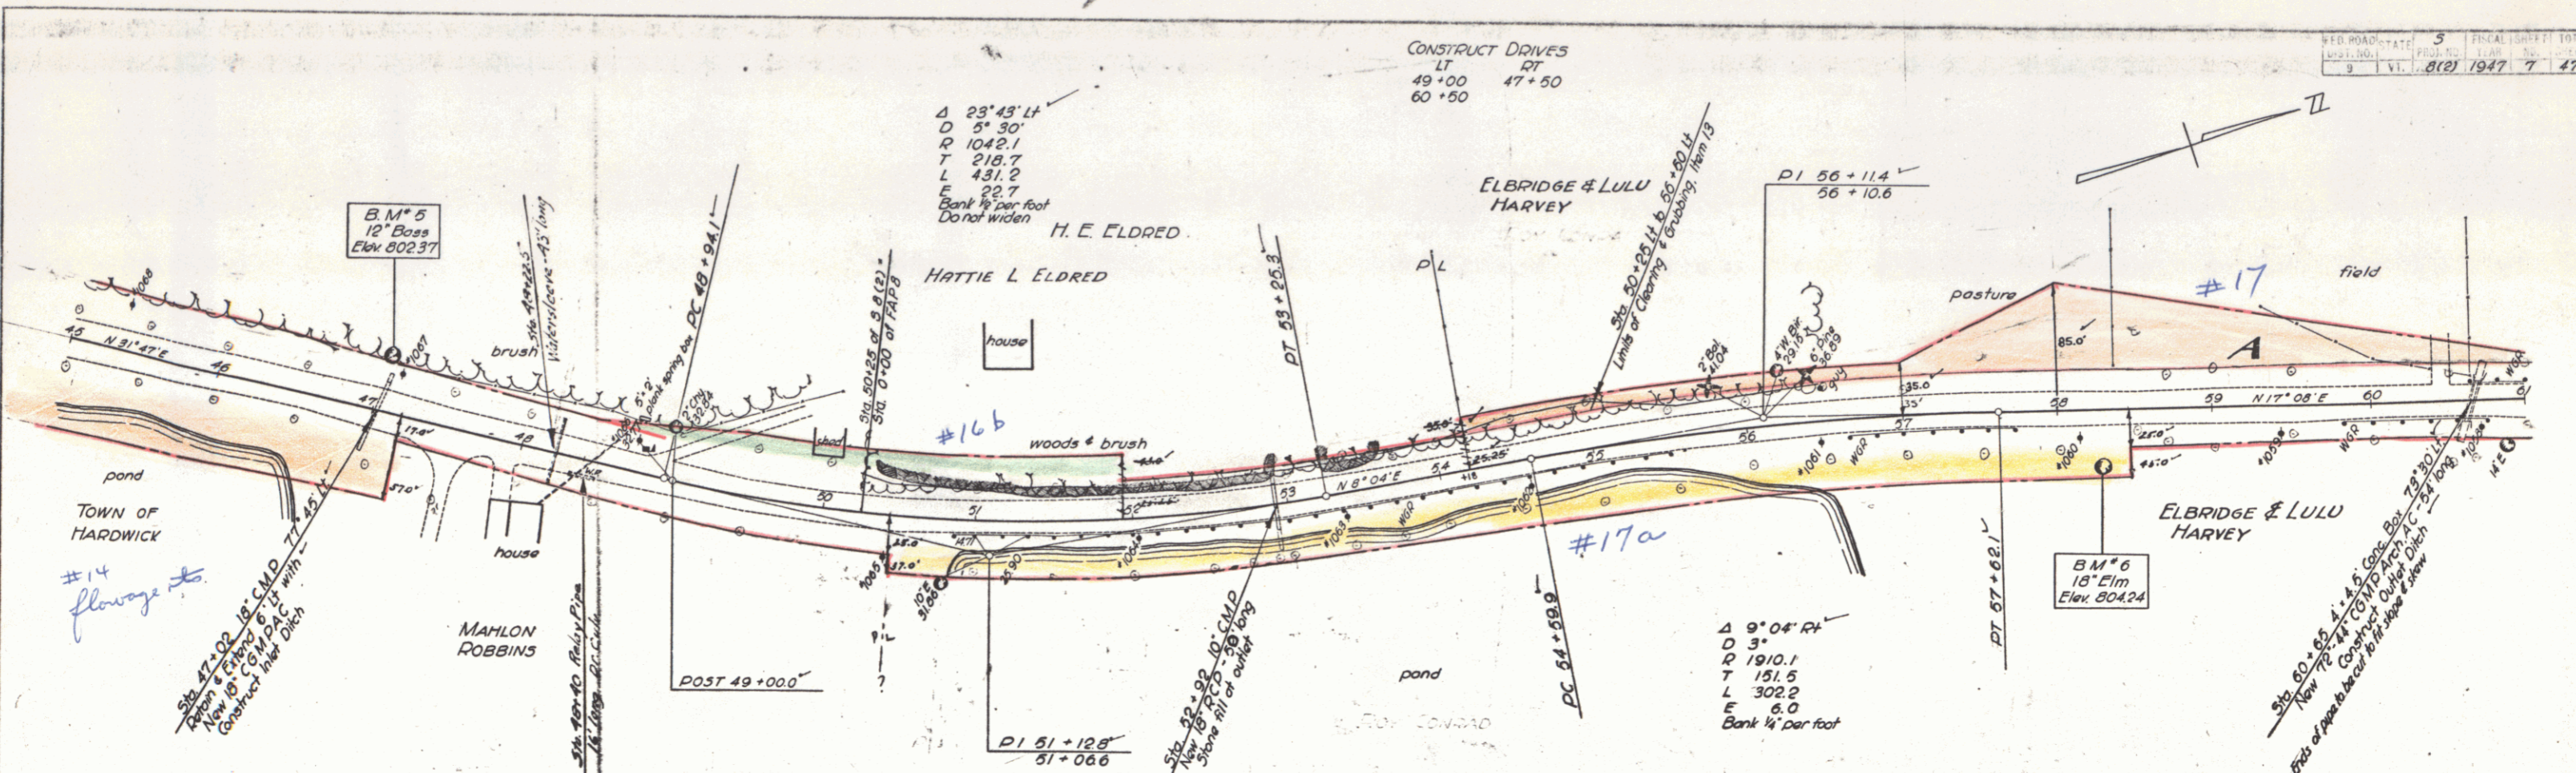

PROFILE
 SHEET NO. 9
 DATE 7-18-27
 DRAWN BY [illegible]
 CHECKED BY [illegible]

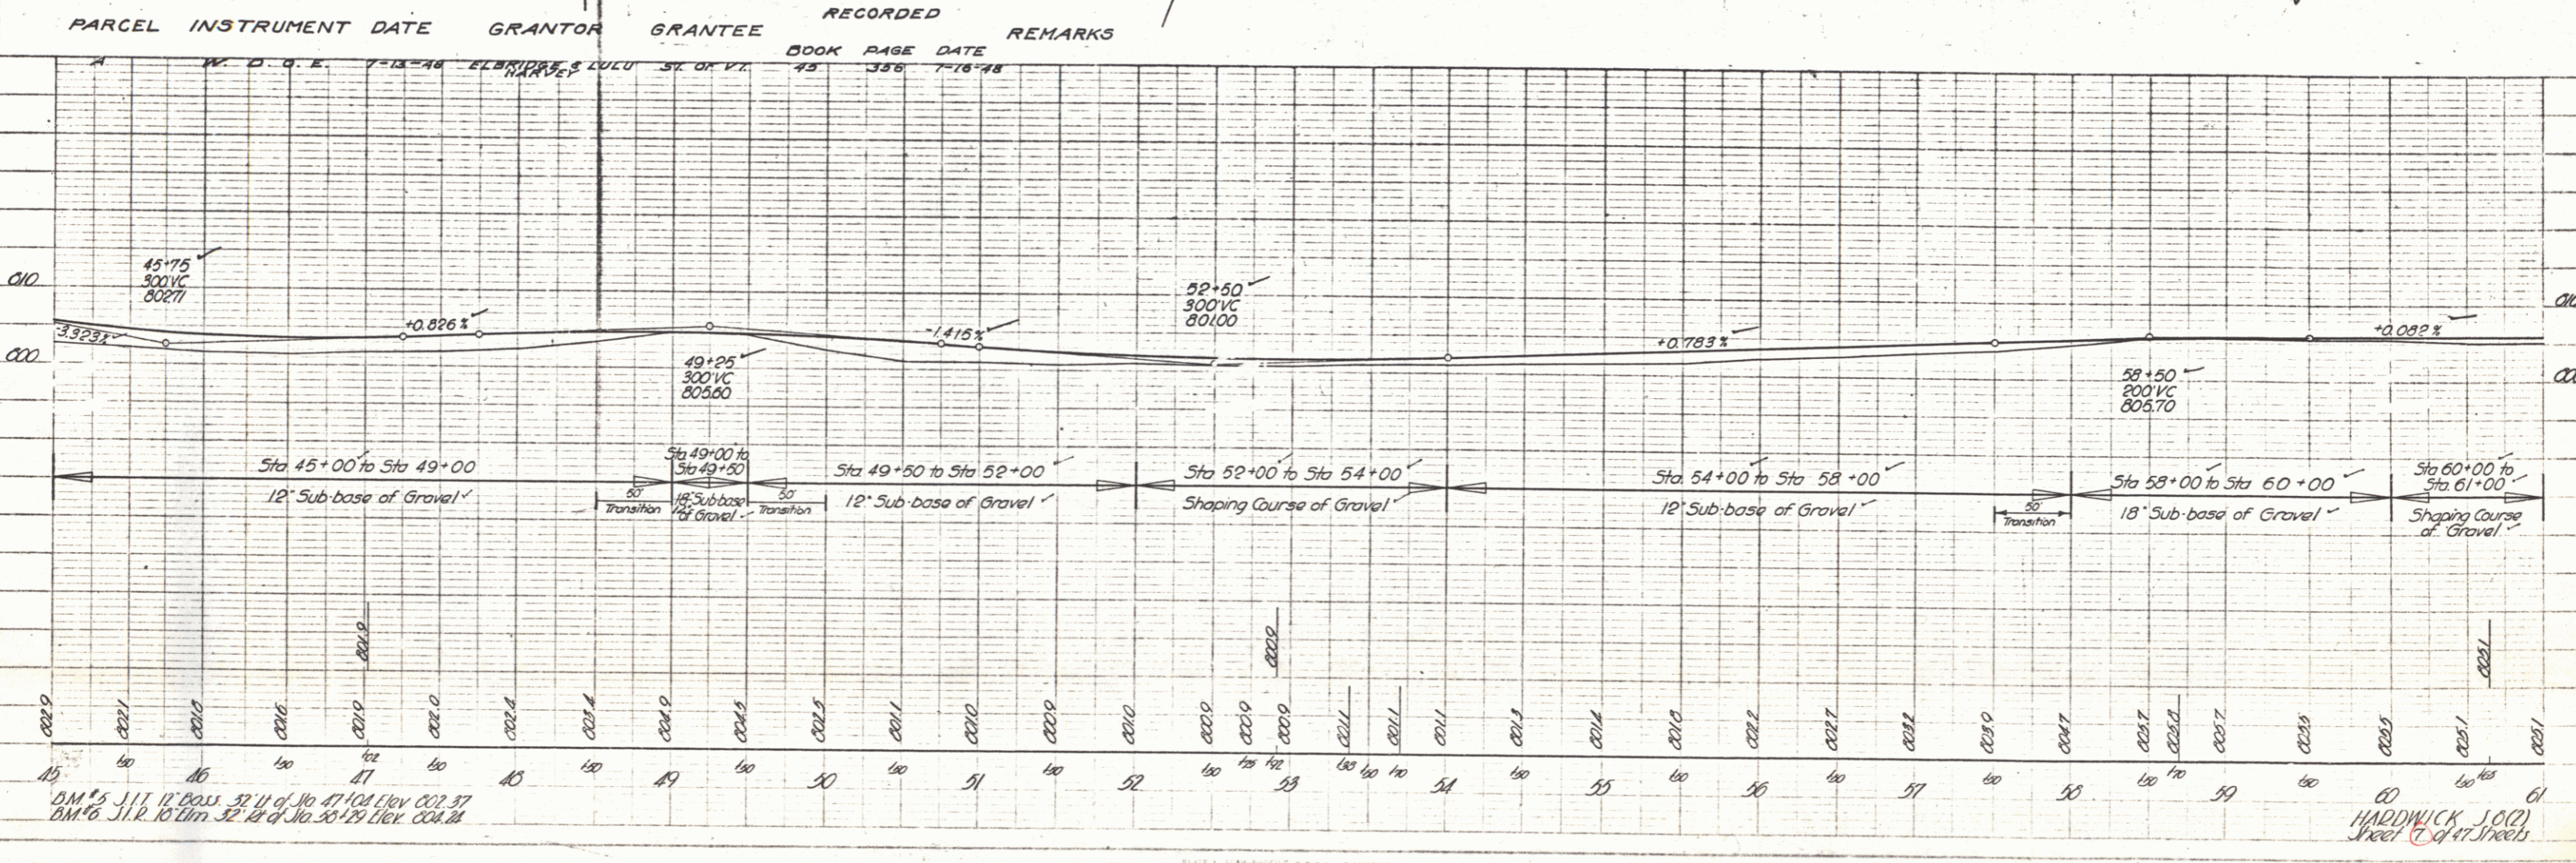

B.M. # 5 12" Brass Elev. 802.37
 B.M. # 6 18" Elm Elev. 804.24

HARDWICK, S.O.C.
 Sheet 9 of 17 Sheets