


CONSTRUCT DRIVES
 LT RT
 78+66 86+73
 86+73

PLAN
 BY
 DATE
 CHECKED
 DATE
 NOTE BOOK NO. OWNER CHECKED
 NO. REVISIONS

PROFILE
 DATE
 CHECKED
 DATE
 NOTE BOOK NO. OWNER CHECKED
 NO. REVISIONS

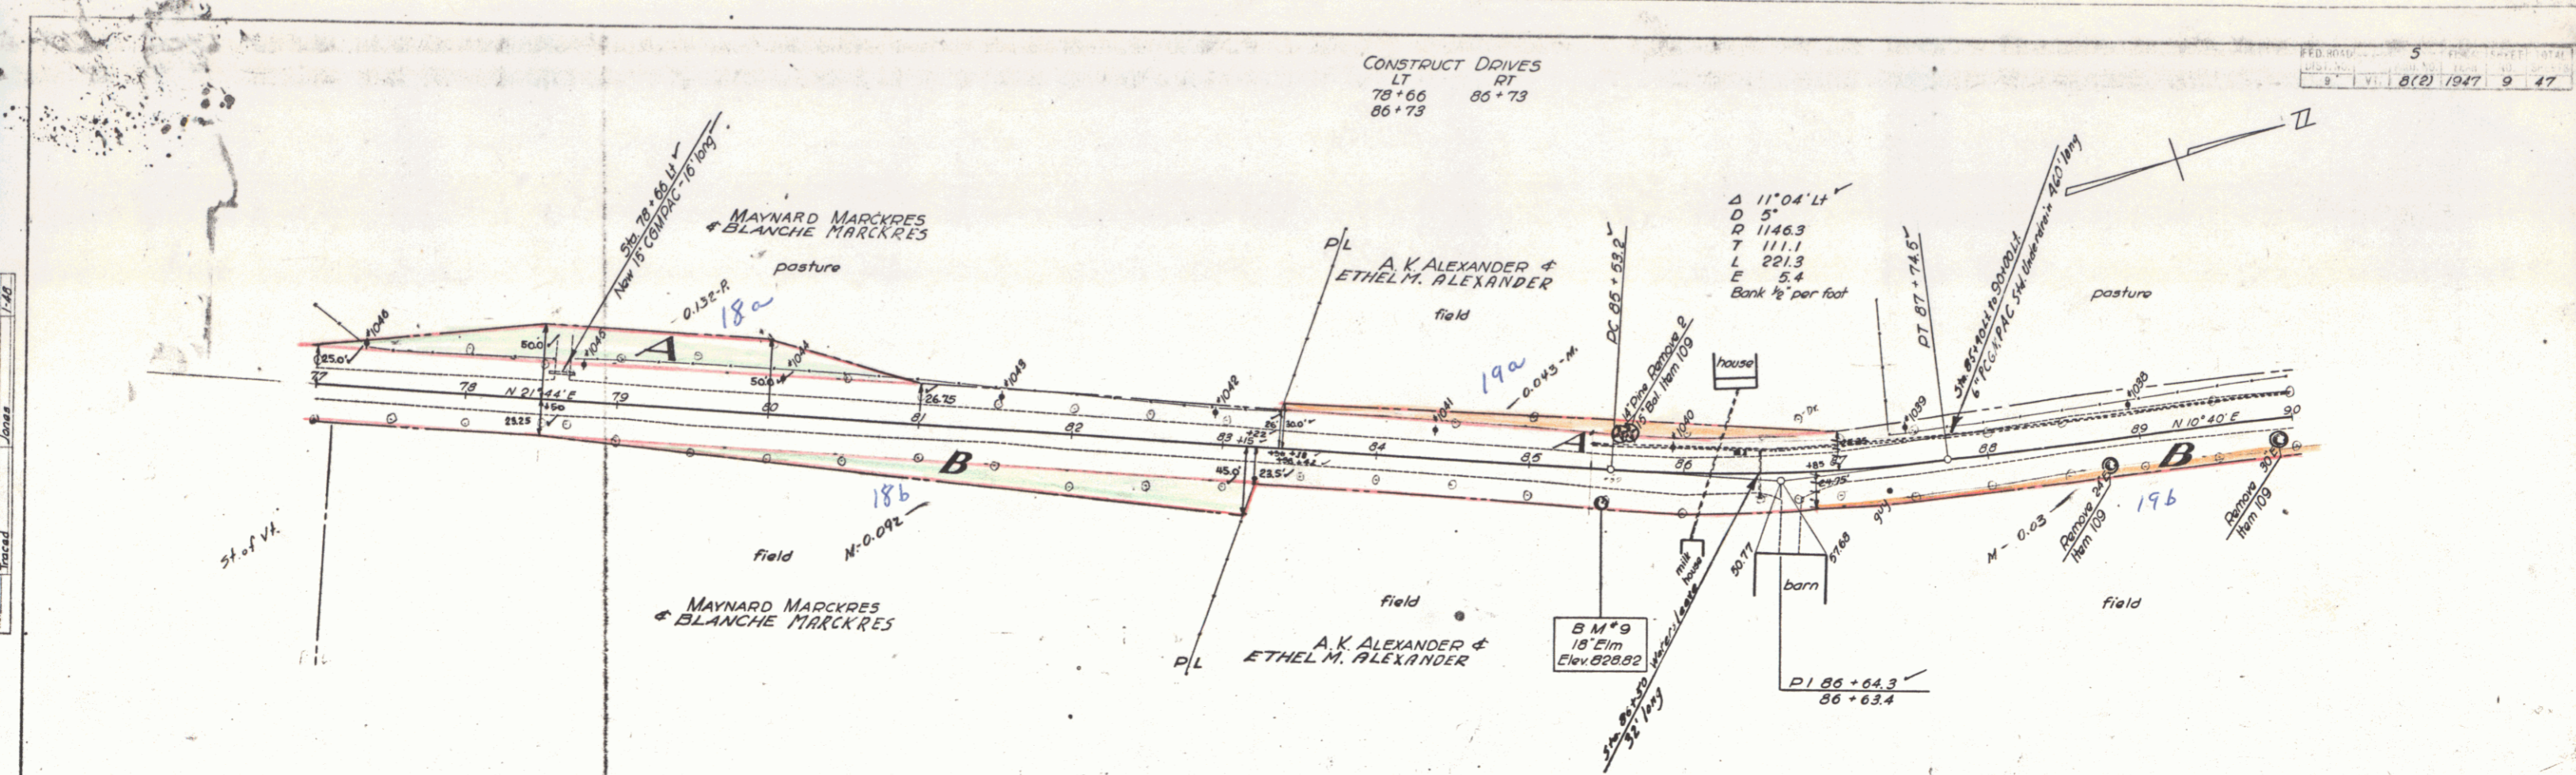

PARCEL	INSTRUMENT	DATE	GRANTOR	GRANTEE	RECORDED HARDWICK BOOK PAGE DATE	REMARKS
A & B	W. D. O. E.	7-13-48	MAYNARD & BLANCHE MARCKRES	ST. OF VT.	45 359 7-16-48	
A & B	W. D. O. E.	7-13-48	BLANCHE MARCKRES & MAYNARD MARCKRES	ST. OF VT.	45 357-358 7-16-48	SEE SHEET 10

