


PLAN
 DRAWN BY: [Signature]
 CHECKED BY: [Signature]
 DATE: 7/18

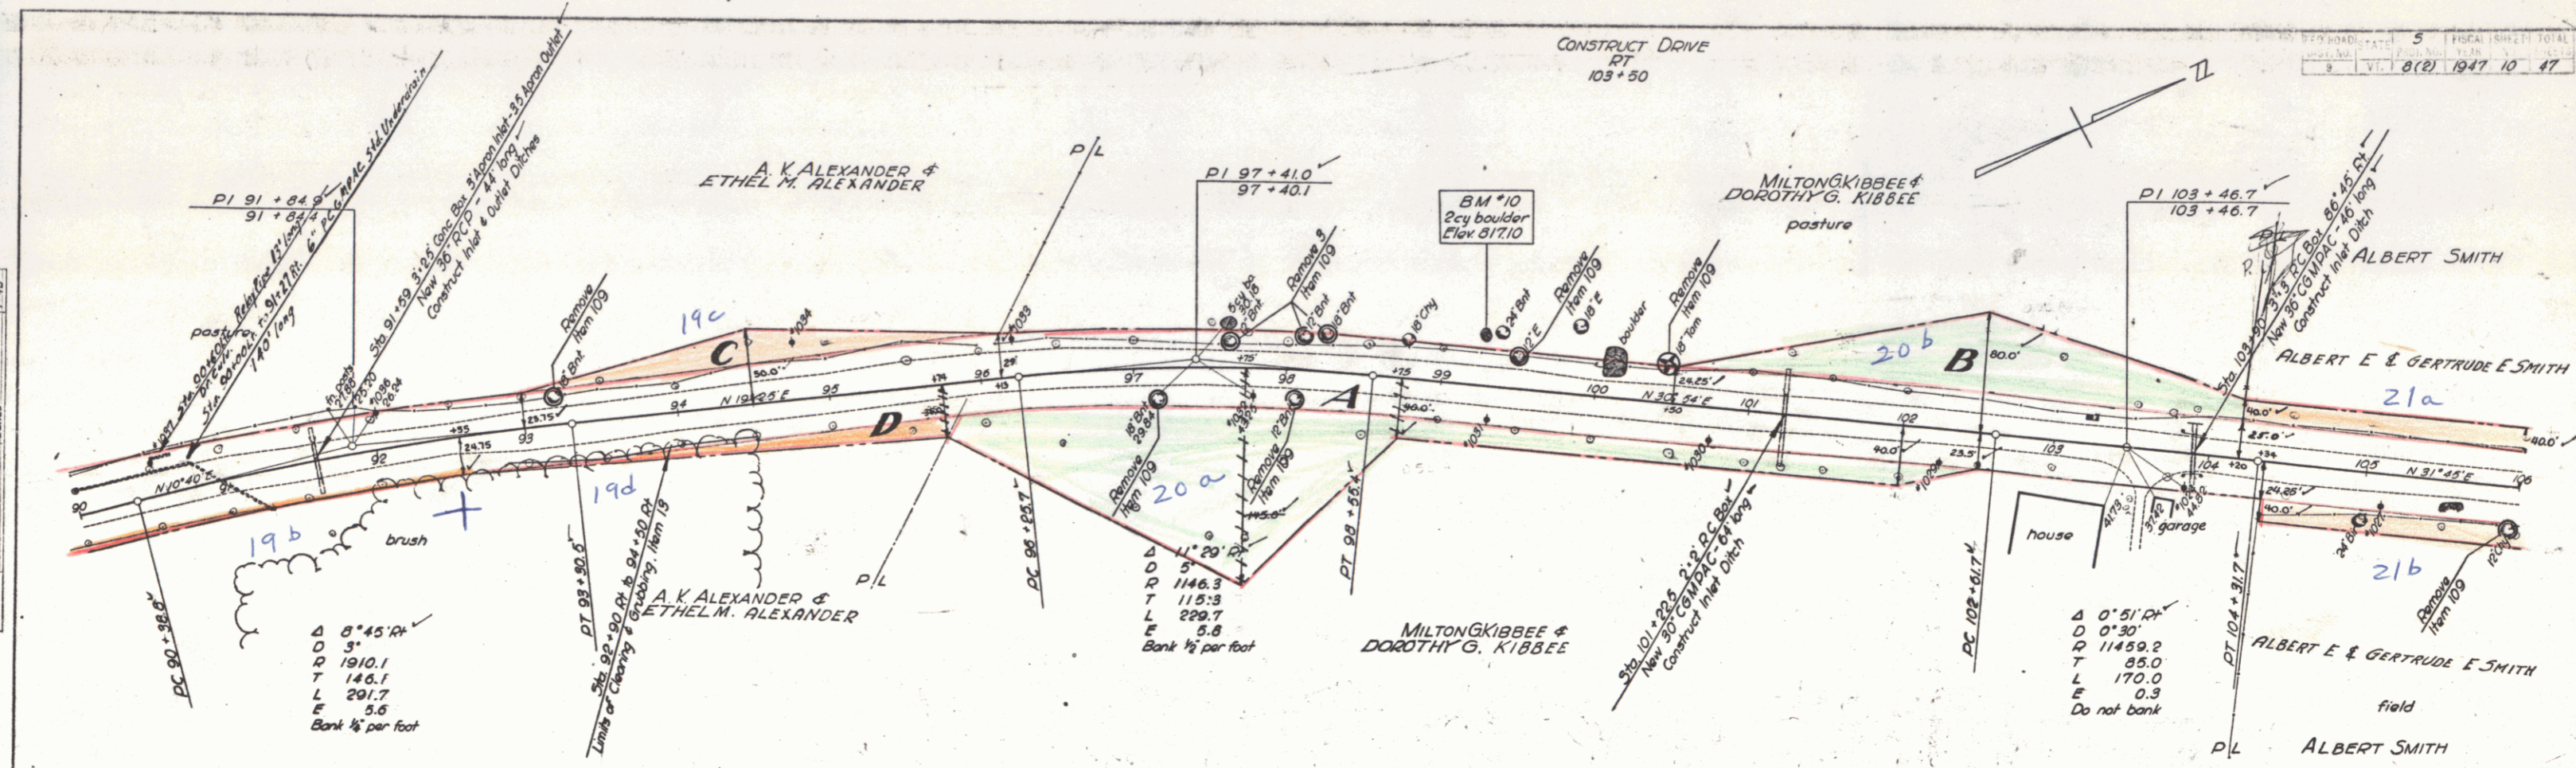

PARCEL INSTRUMENT DATE GRANTOR GRANTEE RECORDED HARDWICK BOOK PAGE DATE REMARKS

PARCEL	INSTRUMENT	DATE	GRANTOR	GRANTEE	RECORDED	HARDWICK	BOOK	PAGE	DATE	REMARKS
A & B	M. D. D. E.	7-13-48	MILTON & DOROTHY G. KIBBEE	ST. OF V.T.	45	389	7-16-48			
C & D	M. D. D. E.	7-13-48	A. K. ALEXANDER & ETHEL M. ALEXANDER		45	357-358	7-16-48		SEE SHEET 9	

PROFILE
 DRAWN BY: [Signature]
 CHECKED BY: [Signature]
 DATE: 7/18

