


PLAN
 DRAWN BY: [Signature]
 CHECKED BY: [Signature]
 DATE: 7-18-48

PROFILE
 DRAWN BY: [Signature]
 CHECKED BY: [Signature]
 DATE: 7-18-48

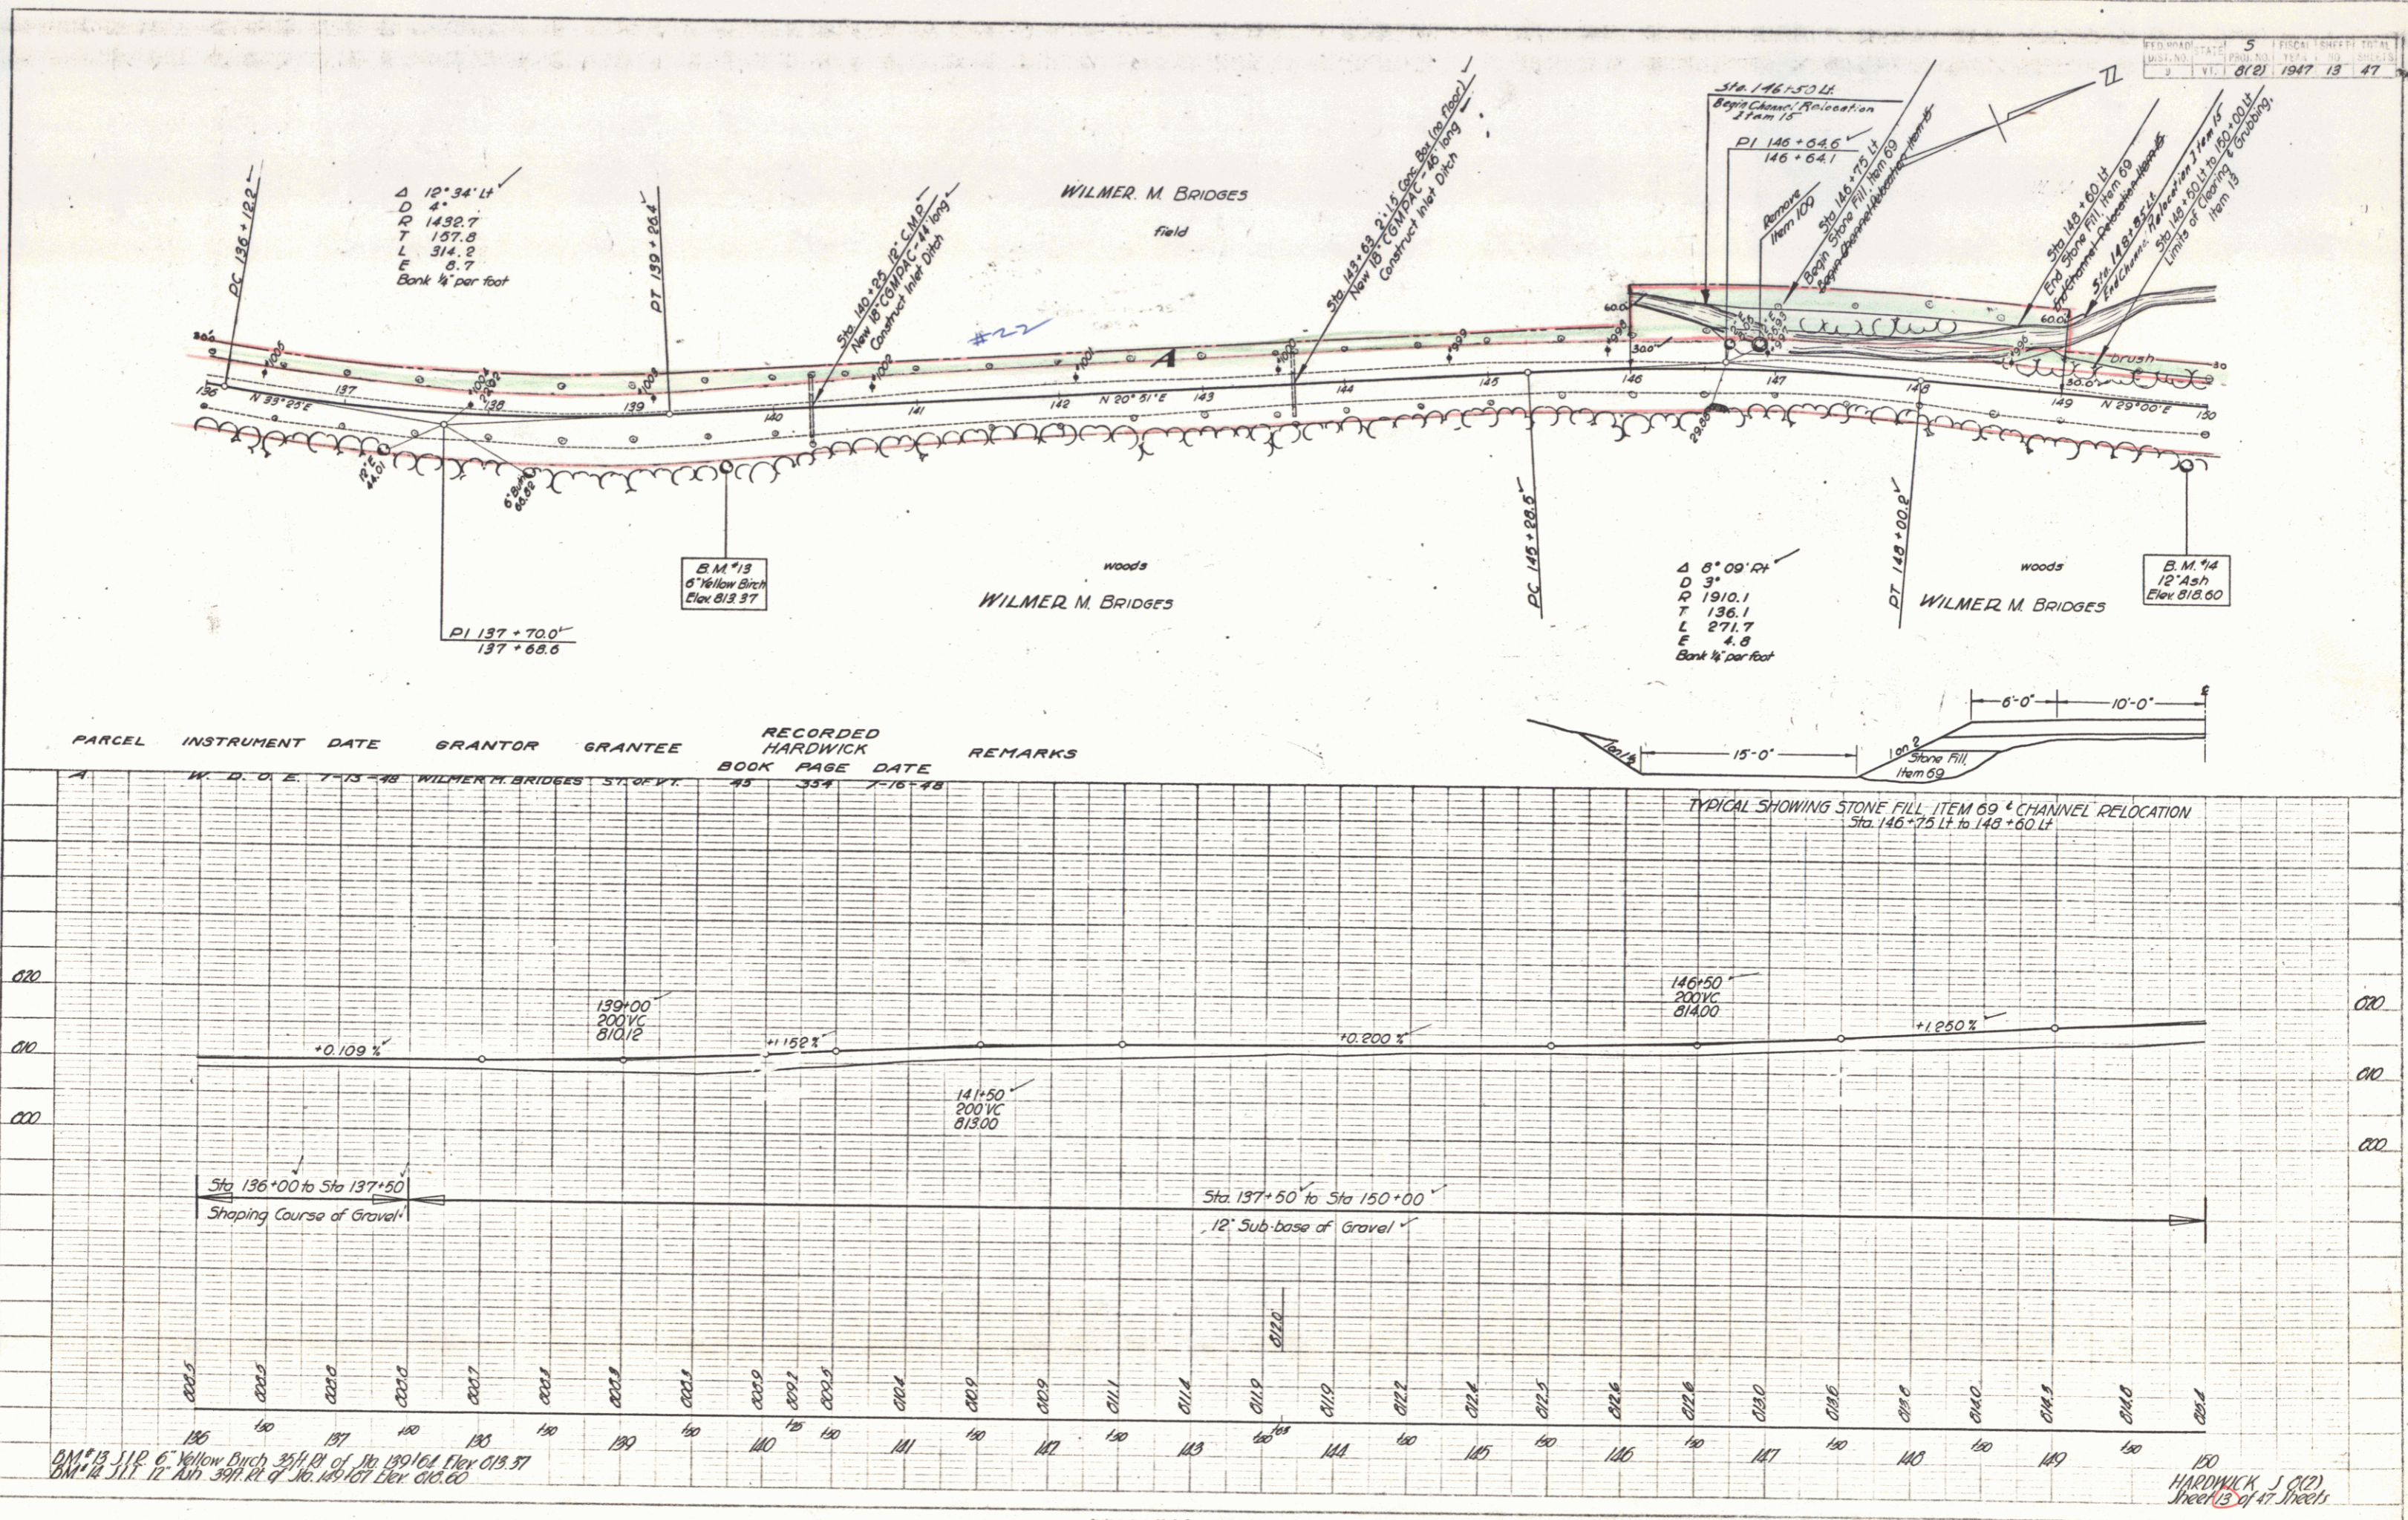

Δ 10° 34' Lt
 D 4'
 T 1432.7
 L 314.2
 E 0.7
 Bank 1/2 per foot

B.M. #13
 6" Yellow Birch
 Elev 813.37

Δ 6° 09' Rt
 D 3'
 T 1910.1
 L 136.1
 E 4.8
 Bank 1/2 per foot

B.M. #14
 12" Ash
 Elev 818.00

REVISIONS
 5
 8(2) 1947 13 47

HARDWICK, J. (2)
 Sheet 13 of 47 Sheets